


- DURABLE AND TEMPORARY 4'' WHITE LINE
STA. 200+00 - STA. 210+00 LT & RT (EDGE LINE)
- DURABLE AND TEMPORARY 4'' YELLOW LINE
STA. 200+00 - STA. 210+00 LT & RT (DOUBLE YELLOW CL)
- REMOVAL AND DISPOSAL OF GUARD RAIL
STA. 200+00 - STA. 208+90 LT
- STEEL BEAM GUARD RAIL (GALVANIZED)
STA. 200+00 - STA. 208+90 LT
- ANCHOR FOR STEEL BEAM GUARD RAIL
STA. 208+78 LT

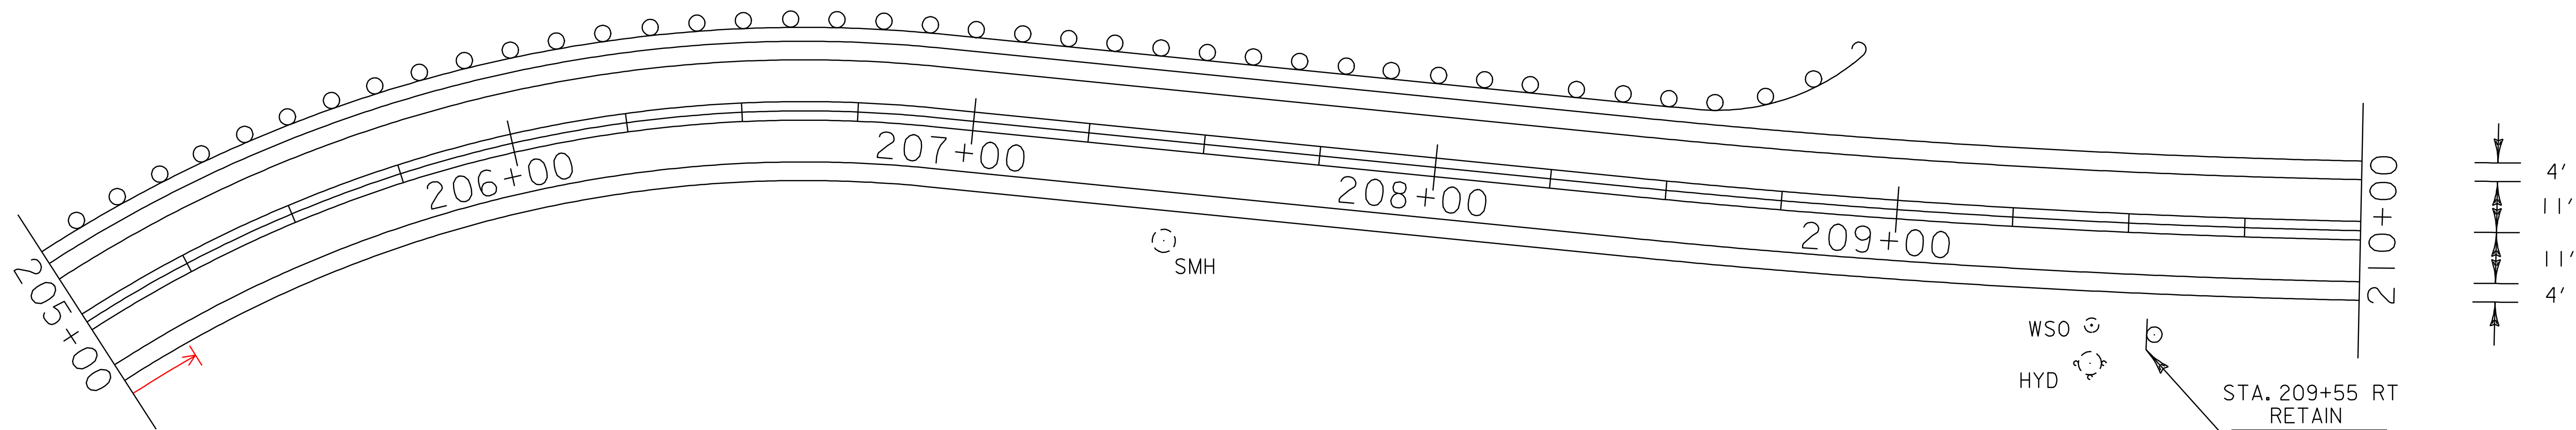

PAVING PROJECT LAYOUT #22	PROJECT NAME: STOWE	PLOT DATE: 11-JUN-2007 13:45
	PROJECT NUMBER: AC STP 2407(I)S	DRAWN BY: LOCKE
	FILE NAME: p04c048.dgn	CHECKED BY: PAVT MGMT
	PROJECT LEADER: WOOLAVER DESIGNED BY: LOCKE p04c048i22.i	SHEET 31 OF 69