

DURABLE AND TEMPORARY 4'' WHITE LINE  
STA. 210+00 - STA. 220+00 LT & RT (EDGE LINE)

DURABLE AND TEMPORARY 4'' YELLOW LINE  
STA. 210+00 - STA. 220+00 LT & RT (DOUBLE YELLOW CL)

REMOVAL AND DISPOSAL OF GUARD RAIL

STA. 212+97 - STA. 214+10 LT  
STA. 213+15 - STA. 214+33 RT

STEEL BEAM GUARD RAIL (GALVANIZED)

STA. 212+97 - STA. 213+37 LT  
STA. 213+15 - STA. 213+42 RT  
STA. 213+55 - STA. 214+10 LT  
STA. 213+63 - STA. 214+33 RT


ANCHOR FOR STEEL BEAM GUARD RAIL

STA. 213+09 LT  
STA. 213+27 RT  
STA. 213+98 LT  
STA. 214+21 RT

BRIDGE RAIL - H.D. STEEL BEAM/FASCIA MOUNTED (MOD. 1)

STA. 213+37 - STA. 213+55 LT  
STA. 213+42 - STA. 213+63 RT

REHABING DI, CB, OR MH CLASS 1  
STA. 217+95 RT

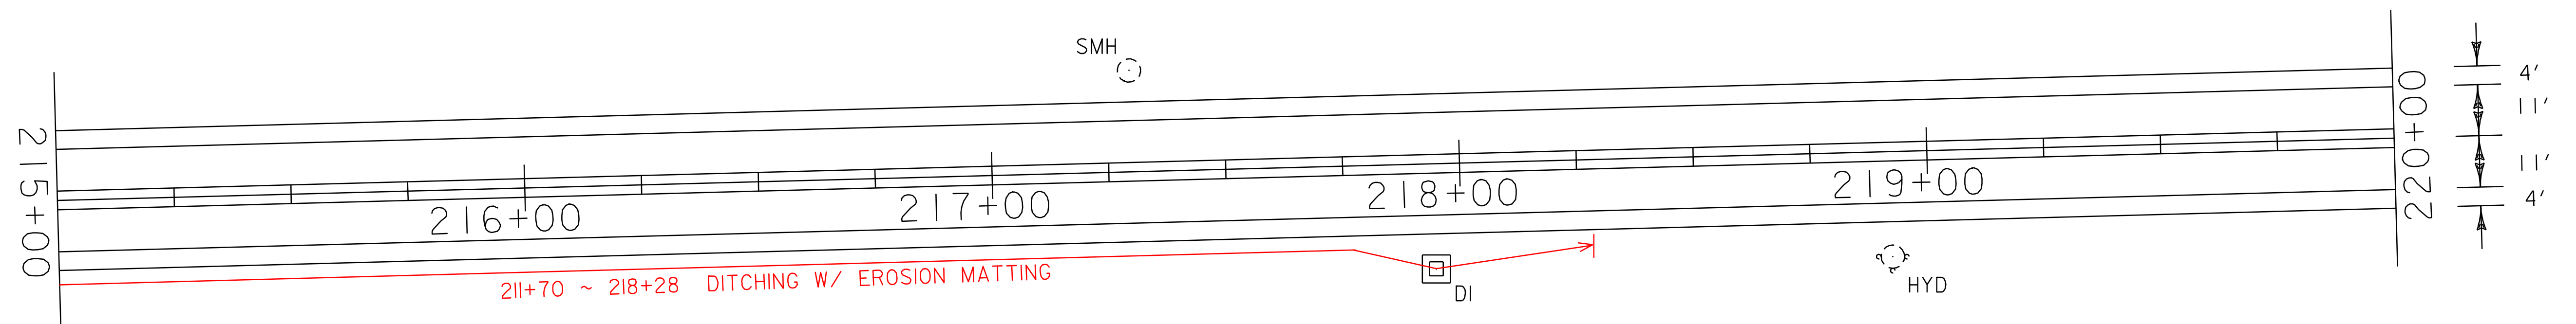

**PAVING  
PROJECT  
LAYOUT  
#23**

PROJECT NAME: STOWE  
PROJECT NUMBER: AC STP 2407(I)S

FILE NAME: p04c048.dgn  
PROJECT LEADER: WOOLAVER  
DESIGNED BY: LOCKE  
p04c048i23.i

PLOT DATE: 11-JUN-2007 13:45  
DRAWN BY: LOCKE  
CHECKED BY: PAVT MGMT  
SHEET 32 OF 69