

DURABLE AND TEMPORARY LETTERS OR SYMBOLS
 STA. 242+53 RT (T-21) STOP

DURABLE AND TEMPORARY 4'' WHITE LINE
 STA. 240+00 - STA. 250+00 LT (EDGE LINE)
 STA. 240+00 - STA. 242+48 RT (EDGE LINE)
 STA. 242+65 - STA. 250+00 RT (EDGE LINE)

DURABLE AND TEMPORARY 4'' YELLOW LINE
 STA. 240+00 - STA. 242+33 LT & RT (DOUBLE YELLOW CL)
 STA. 242+73 - STA. 250+00 LT & RT (DOUBLE YELLOW CL)
 STA. 242+53 RT (DOUBLE YELLOW CL) T-21

DURABLE AND TEMPORARY 24'' STOP BAR
 STA. 242+53 RT (T-21)

REMOVING SIGNS
 2 EA

CHANGING ELEVATION OF SEWER MANHOLE
 STA. 242+37 RT
 REHABING DI, CB, OR MH CLASS I
 STA. 242+28 RT


T-21
 SANBORN RD.
 MM 4.593 = STA. 242+53

REMOVAL AND DISPOSAL OF GUARD RAIL
 STA. 246+00 - STA. 247+81 LT
 STA. 246+79 - STA. 247+15 RT

STEEL BEAM GUARD RAIL (GALVANIZED)
 STA. 246+00 - STA. 246+77 LT
 STA. 246+79 - STA. 246+85 RT
 STA. 247+03 - STA. 247+81 LT
 STA. 247+03 - STA. 247+15 RT

BRIDGE RAIL - H.D. STEEL BEAM/FASCIA MOUNTED (MOD. 3)
 STA. 246+77 - STA. 247+03 LT
 STA. 246+85 - STA. 247+03 RT

ANCHOR FOR STEEL BEAM GUARD RAIL
 STA. 246+12 LT
 STA. 246+91 RT
 STA. 247+03 RT
 STA. 247+69 LT

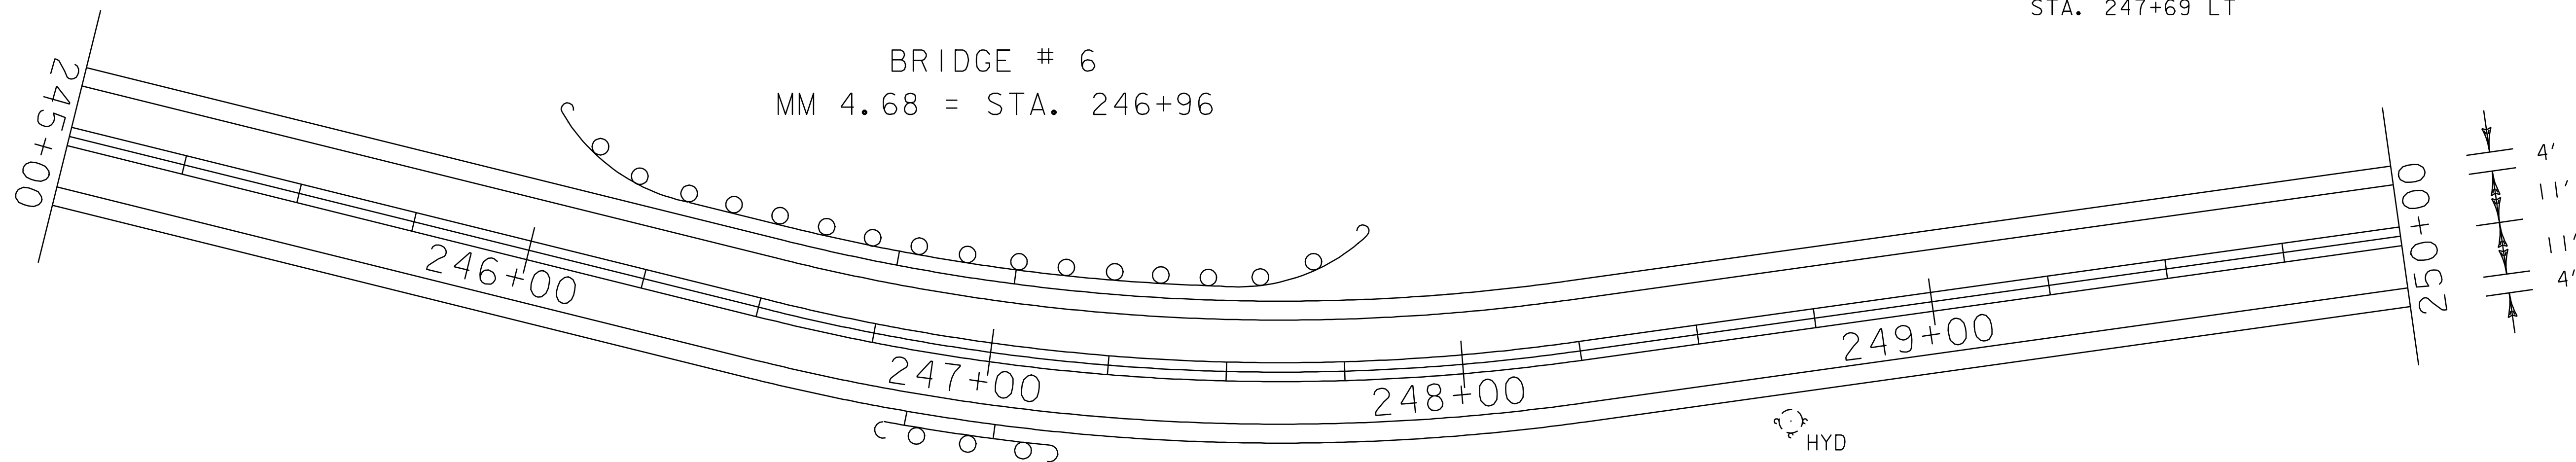

PAVING PROJECT LAYOUT #26	PROJECT NAME: STOWE	PLOT DATE: 11-JUN-2007 13:45
	PROJECT NUMBER: AC STP 2407(I)S	DRAWN BY: LOCKE
	FILE NAME: p04c048.dgn	CHECKED BY: PAVT MGMT
	PROJECT LEADER: WOOLAVER	SHEET 35 OF 69
	DESIGNED BY: LOCKE	
	p04c048i26.i	