
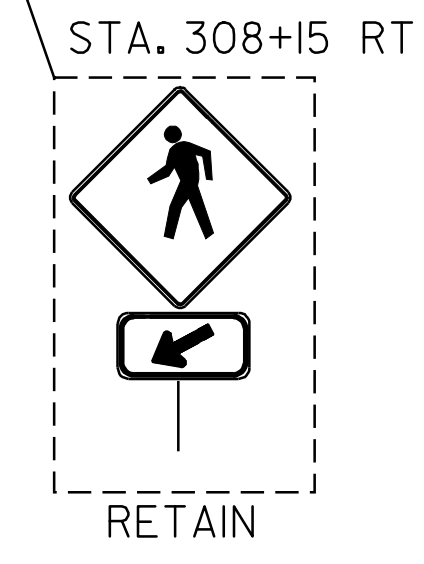


DURABLE AND TEMPORARY 4'' WHITE LINE  
 STA. 300+00 - STA. 310+00 LT & RT (EDGE LINE)  
 DURABLE AND TEMPORARY 4'' YELLOW LINE  
 STA. 300+00 - STA. 310+00 LT & RT (DOUBLE YELLOW CL)  
 REHABING DI, CB, OR MH CLASS I  
 STA. 307+88 RT

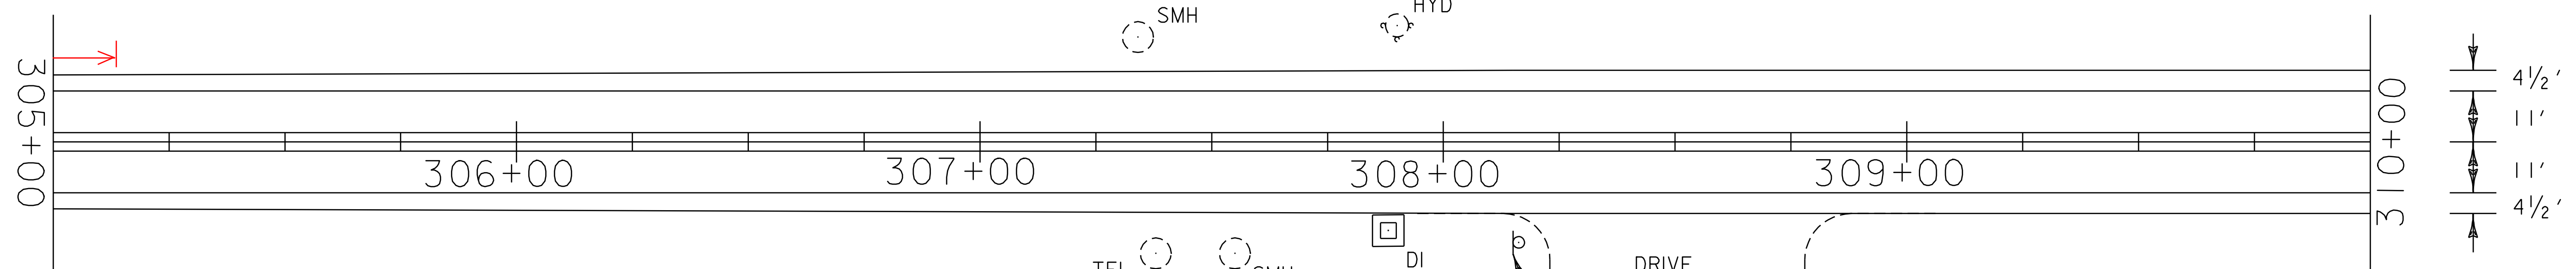

<b>PAVING PROJECT LAYOUT #32</b>	PROJECT NAME: STOWE	PLOT DATE: 11-JUN-2007 13:45
	PROJECT NUMBER: AC STP 2407(I)S	DRAWN BY: LOCKE
	FILE NAME: p04c048.dgn	CHECKED BY: PAVT MGMT
	PROJECT LEADER: WOOLLAVER	SHEET 41 OF 69
	DESIGNED BY: LOCKE	
	p04c048i32.i	