


DURABLE AND TEMPORARY 4 '' WHITE LINE
 STA. 320+00 - STA. 330+00 LT & RT (EDGE LINE)
 DURABLE AND TEMPORARY 4 '' YELLOW LINE
 STA. 320+00 - STA. 330+00 LT & RT (DOUBLE YELLOW CL)

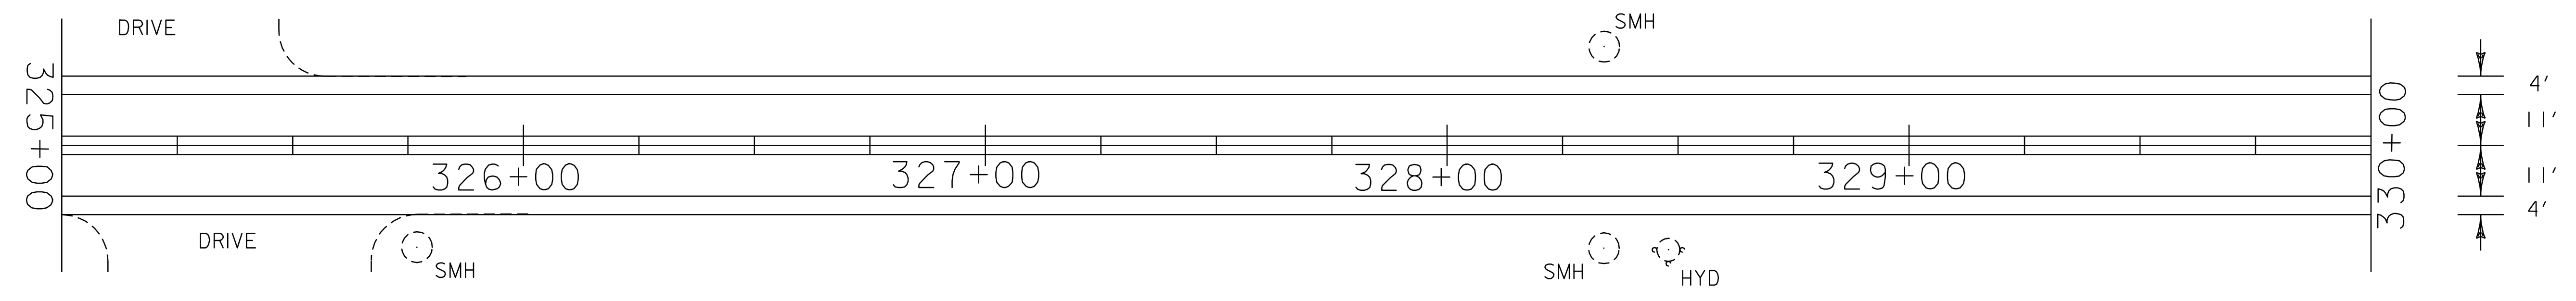

PAVING PROJECT LAYOUT #34	PROJECT NAME: STOWE	PLOT DATE: 11-JUN-2007 13:45
	PROJECT NUMBER: AC STP 2407(I)S	DRAWN BY: LOCKE
	FILE NAME: p04c048.dgn	CHECKED BY: PAVT MGMT
	PROJECT LEADER: WOOLAVER	SHEET 43 OF 69
	DESIGNED BY: LOCKE	
	p04c048i34.i	