


DURABLE AND TEMPORARY 4'' WHITE LINE  
 STA. 330+00 - STA. 340+00 LT & RT (EDGE LINE)  
 DURABLE AND TEMPORARY 4'' YELLOW LINE  
 STA. 330+00 - STA. 340+00 LT & RT (DOUBLE YELLOW CL)

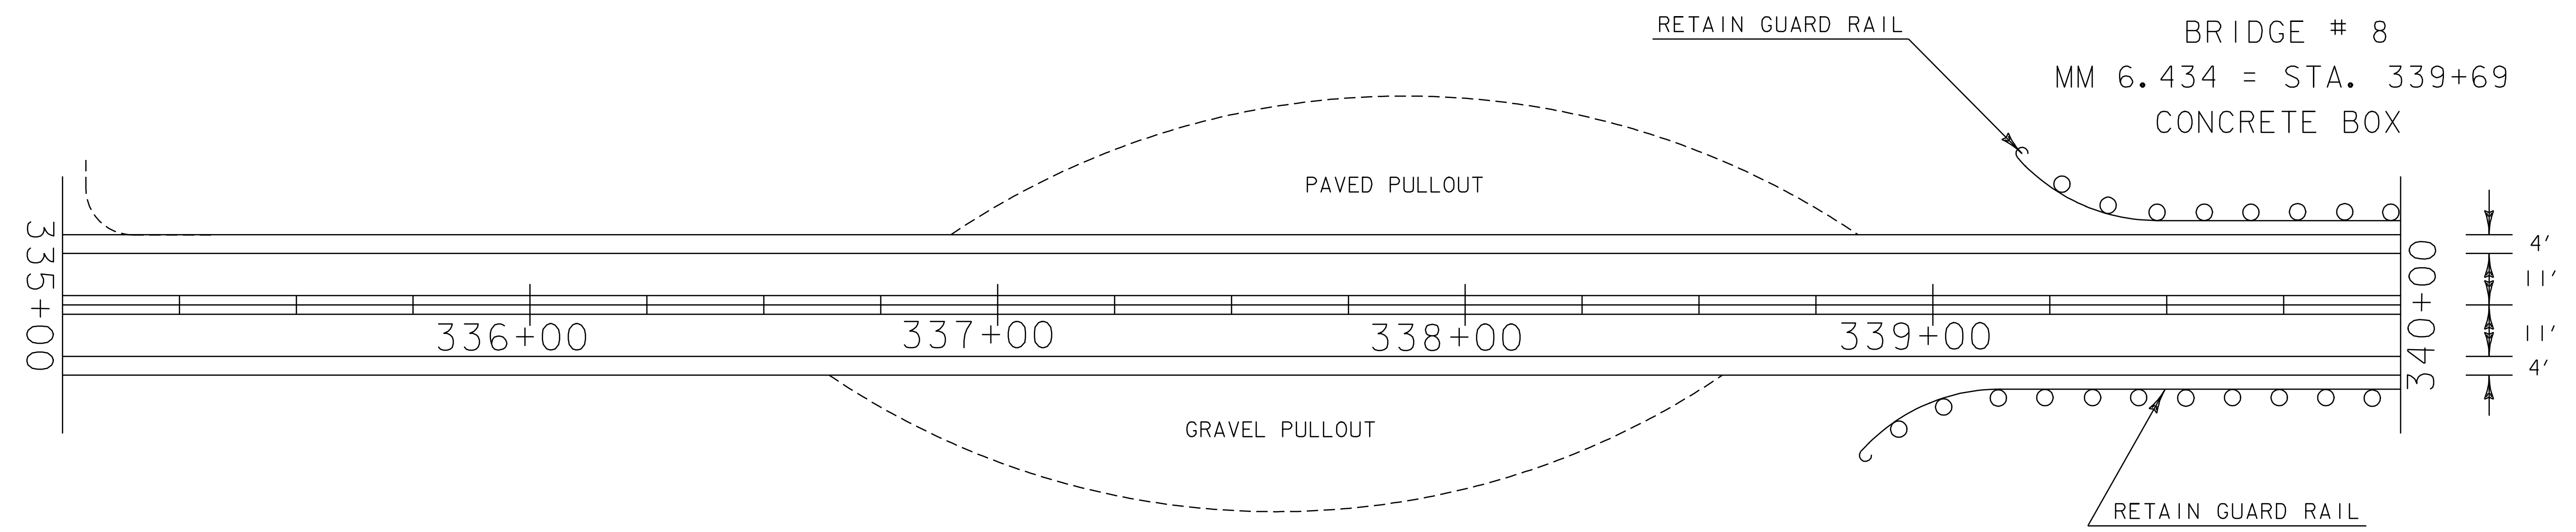

<b>PAVING PROJECT LAYOUT #35</b>	PROJECT NAME: STOWE	PLOT DATE: 11-JUN-2007 13:45
	PROJECT NUMBER: AC STP 2407(I)S	DRAWN BY: LOCKE
	FILE NAME: p04c048.dgn	CHECKED BY: PAVT MGMT
	PROJECT LEADER: WOOLLAVER	SHEET 44 OF 69
	DESIGNED BY: LOCKE	
	p04c048135.1	