


DURABLE AND TEMPORARY 4'' WHITE LINE
 STA. 370+00 - STA. 380+00 LT & RT (EDGE LINE)
DURABLE AND TEMPORARY 4'' YELLOW LINE
 STA. 370+00 - STA. 380+00 LT & RT (DOUBLE YELLOW CL)
CHANGING ELEVATION OF SEWER MANHOLE
 STA. 378+12 RT (IN PAVED APRON)

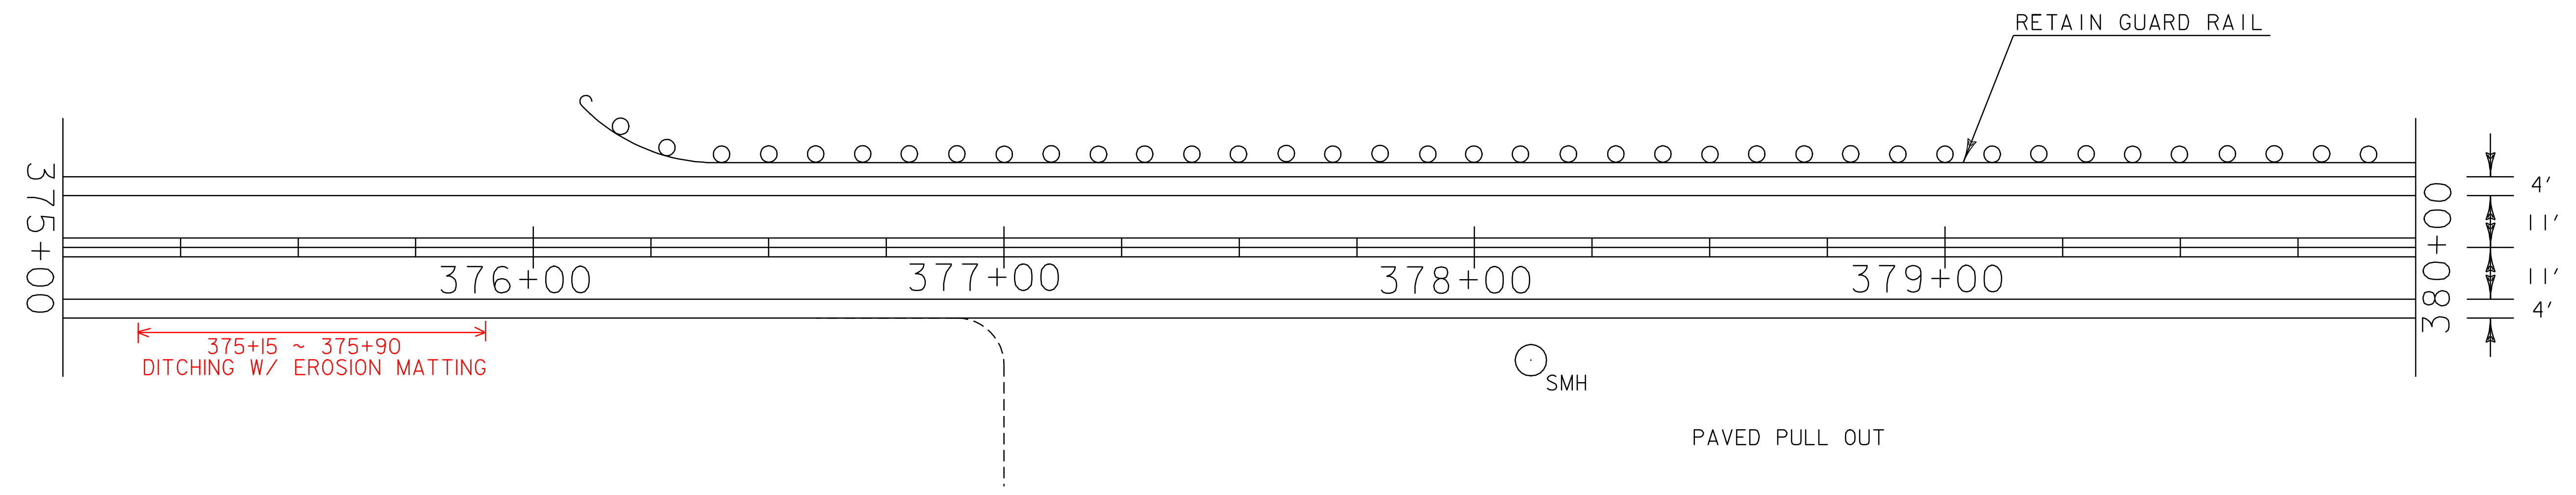

PAVING PROJECT LAYOUT #39	PROJECT NAME: STOWE	PLOT DATE: 11-JUN-2007 13:46
	PROJECT NUMBER: AC STP 2407(I)S	DRAWN BY: LOCKE
	FILE NAME: p04c048.dgn	CHECKED BY: PAVT MGMT
	PROJECT LEADER: WOOLAVER	SHEET 48 OF 69
DESIGNED BY: LOCKE		
p04c048i39.i		