


← 390+70 ~ 392+55 ITEM 649.3I GEOTEXTILE UNDER STONE FILL →

DURABLE AND TEMPORARY 4'' WHITE LINE  
 STA. 390+00 - STA. 400+00 LT & RT (EDGE LINE)  
 DURABLE AND TEMPORARY 4'' YELLOW LINE  
 STA. 390+00 - STA. 400+00 LT & RT (DOUBLE YELLOW CL)

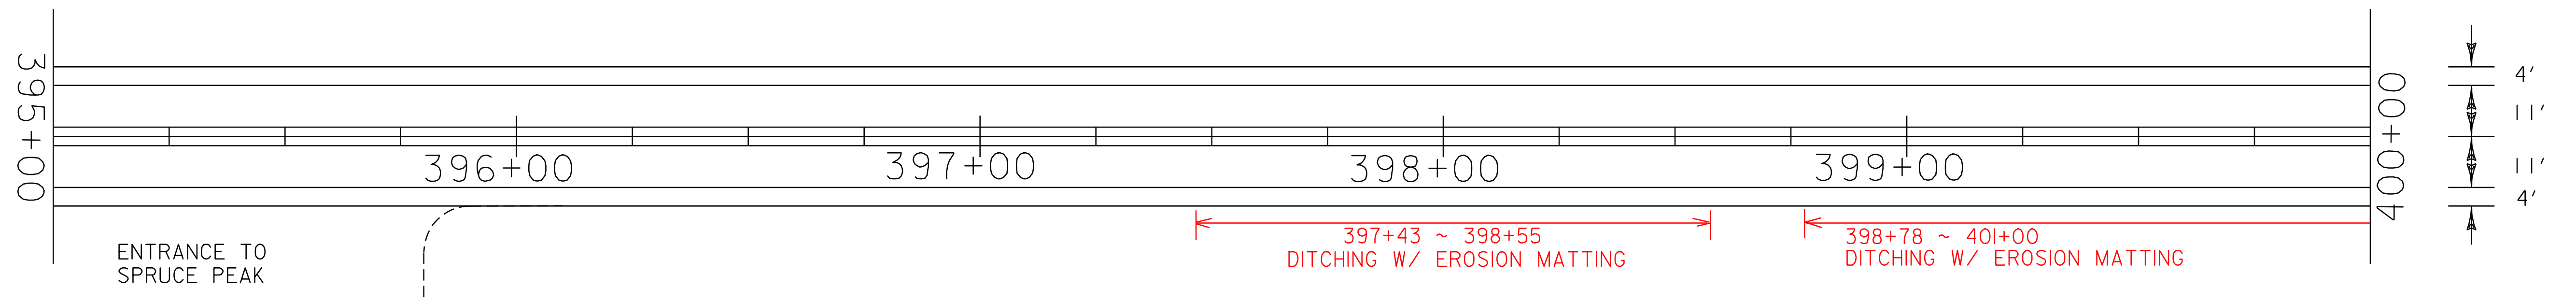

<b>PAVING PROJECT LAYOUT #41</b>	PROJECT NAME: STOWE	PLOT DATE: 11-JUN-2007 13:46
	PROJECT NUMBER: AC STP 2407(I)S	DRAWN BY: LOCKE
	FILE NAME: p04c048.dgn	CHECKED BY: PAVT MGMT
	PROJECT LEADER: WOOLLAVER DESIGNED BY: LOCKE p04c048i41.i	SHEET 50 OF 69