


SEE INDEX OF SHEETS & LIST OF STANDARDS ON SHEET 2



# STATE OF VERMONT AGENCY OF TRANSPORTATION



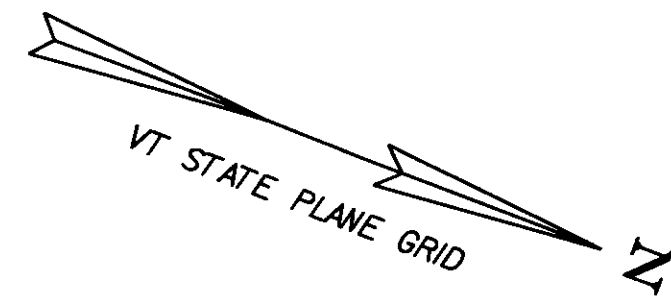


## PROPOSED IMPROVEMENT BRIDGE PROJECT TOWN OF CANAAN COUNTY OF ESSEX VT. 102 (MAJOR COLLECTOR) BRIDGE #16

**PROJECT LOCATION :** BEGINNING AT A POINT ON VT 102 APPROXIMATELY 2.0 MILES NORTH OF ITS JUNCTION WITH VT 26 AND PROCEEDING NORTHERLY APPROXIMATELY 0.1 MILES ALONG VT 102.

**PROJECT DESCRIPTION :** CONSTRUCT A NEW BRIDGE ON THE EXISTING ALIGNMENT, INCLUDING RELATED CHANNEL AND ROADWAY APPROACH WORK.

LENGTH OF STRUCTURE : 84 FEET.  
LENGTH OF ROADWAY : 416 FEET.  
LENGTH OF PROJECT : 500 FEET.

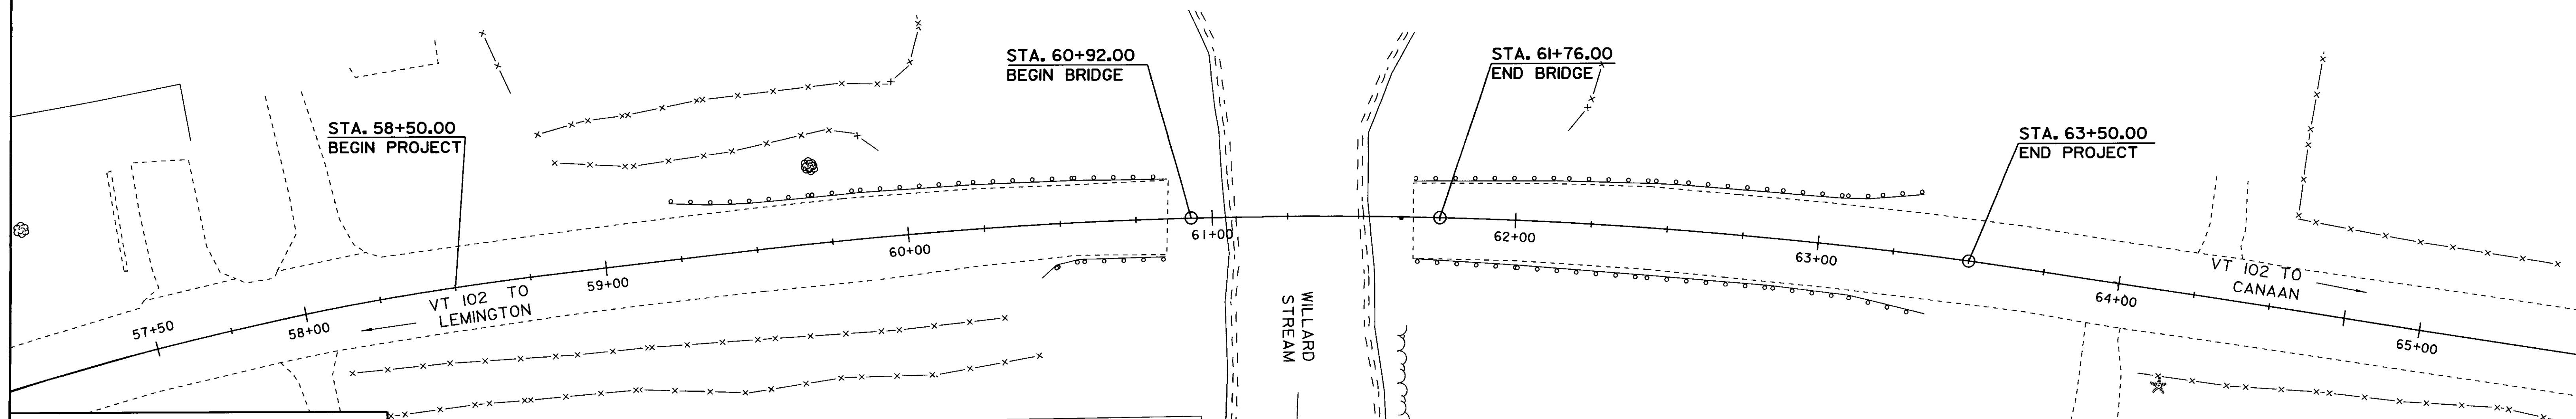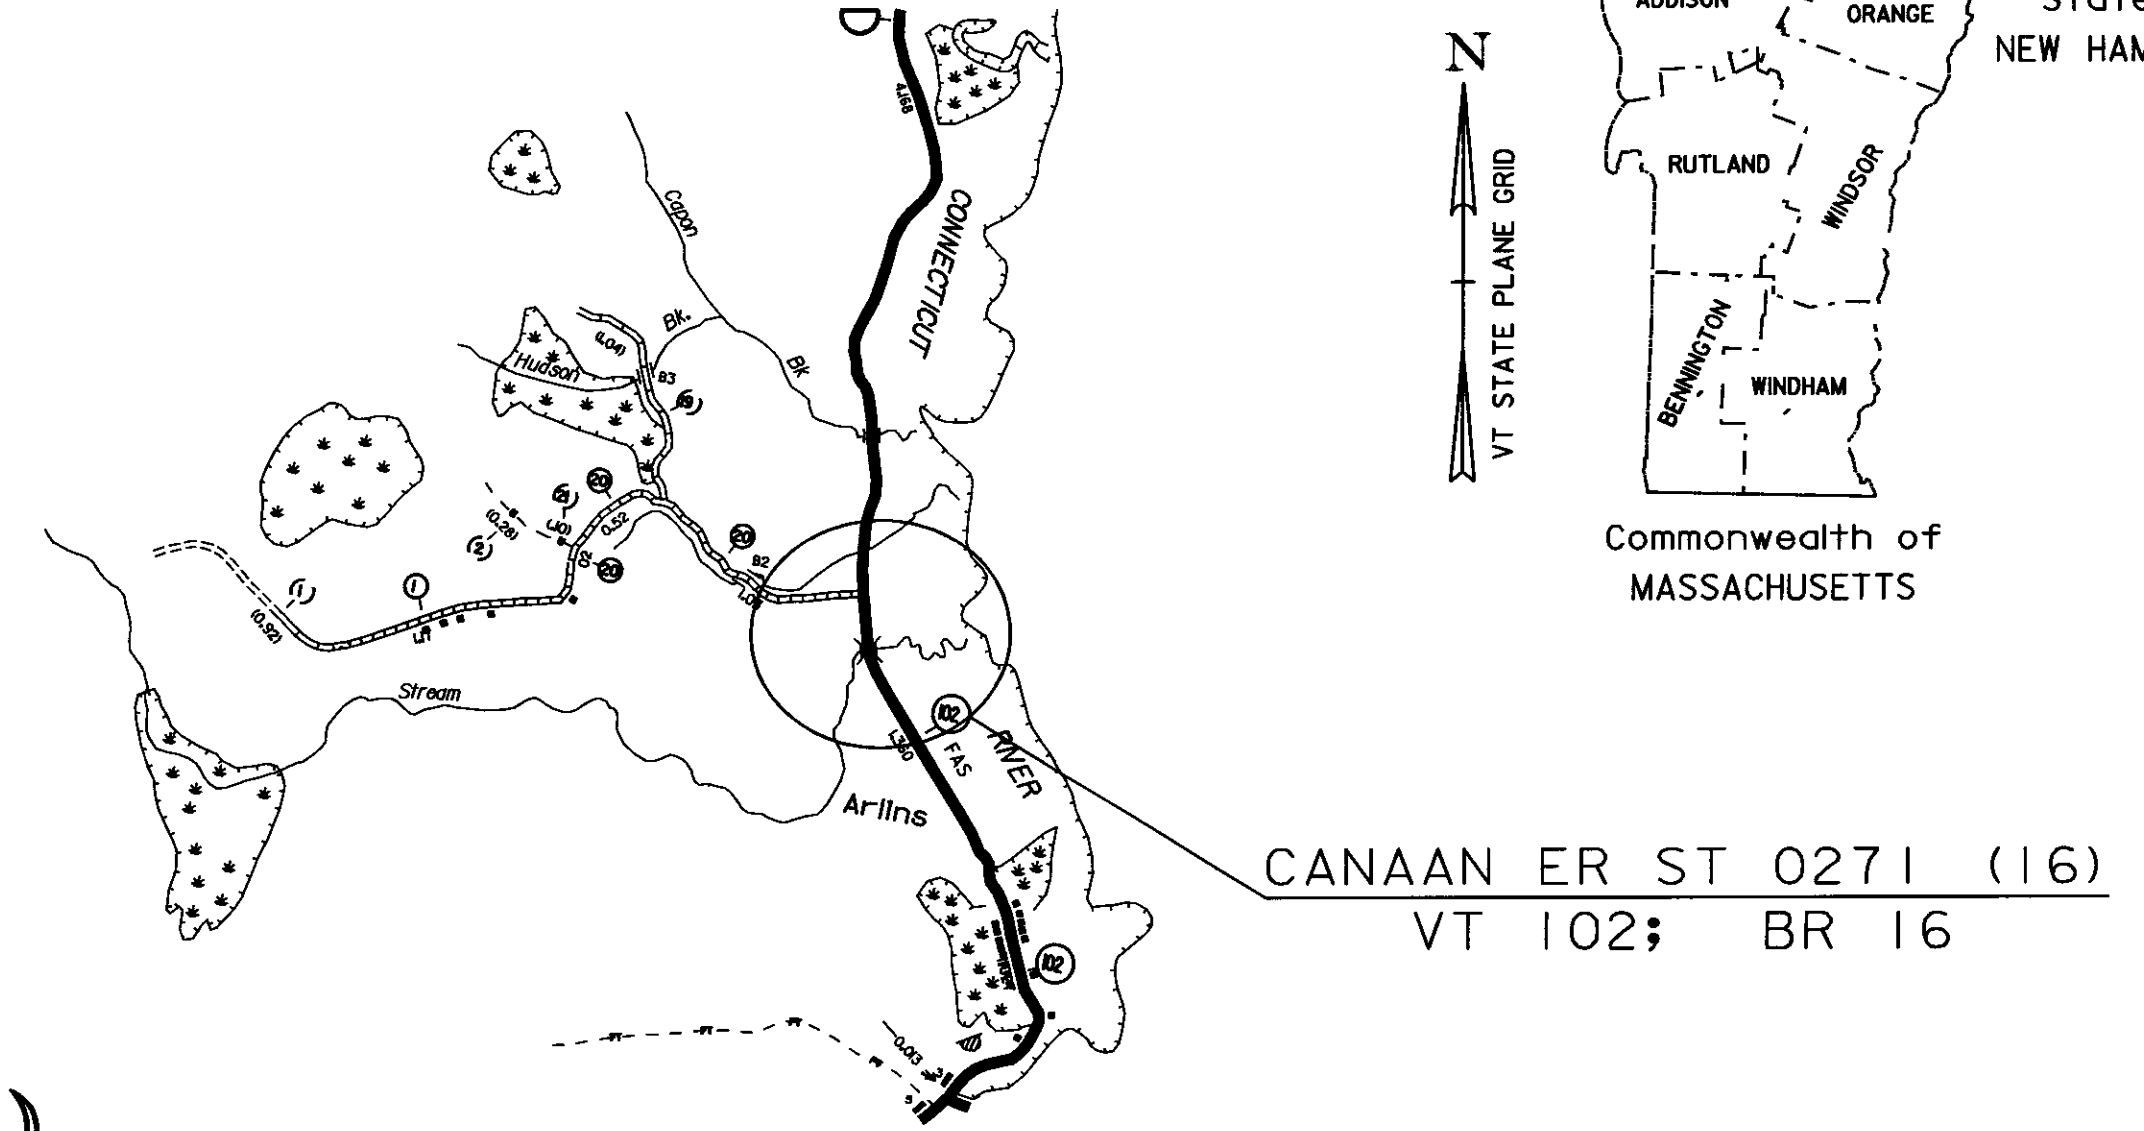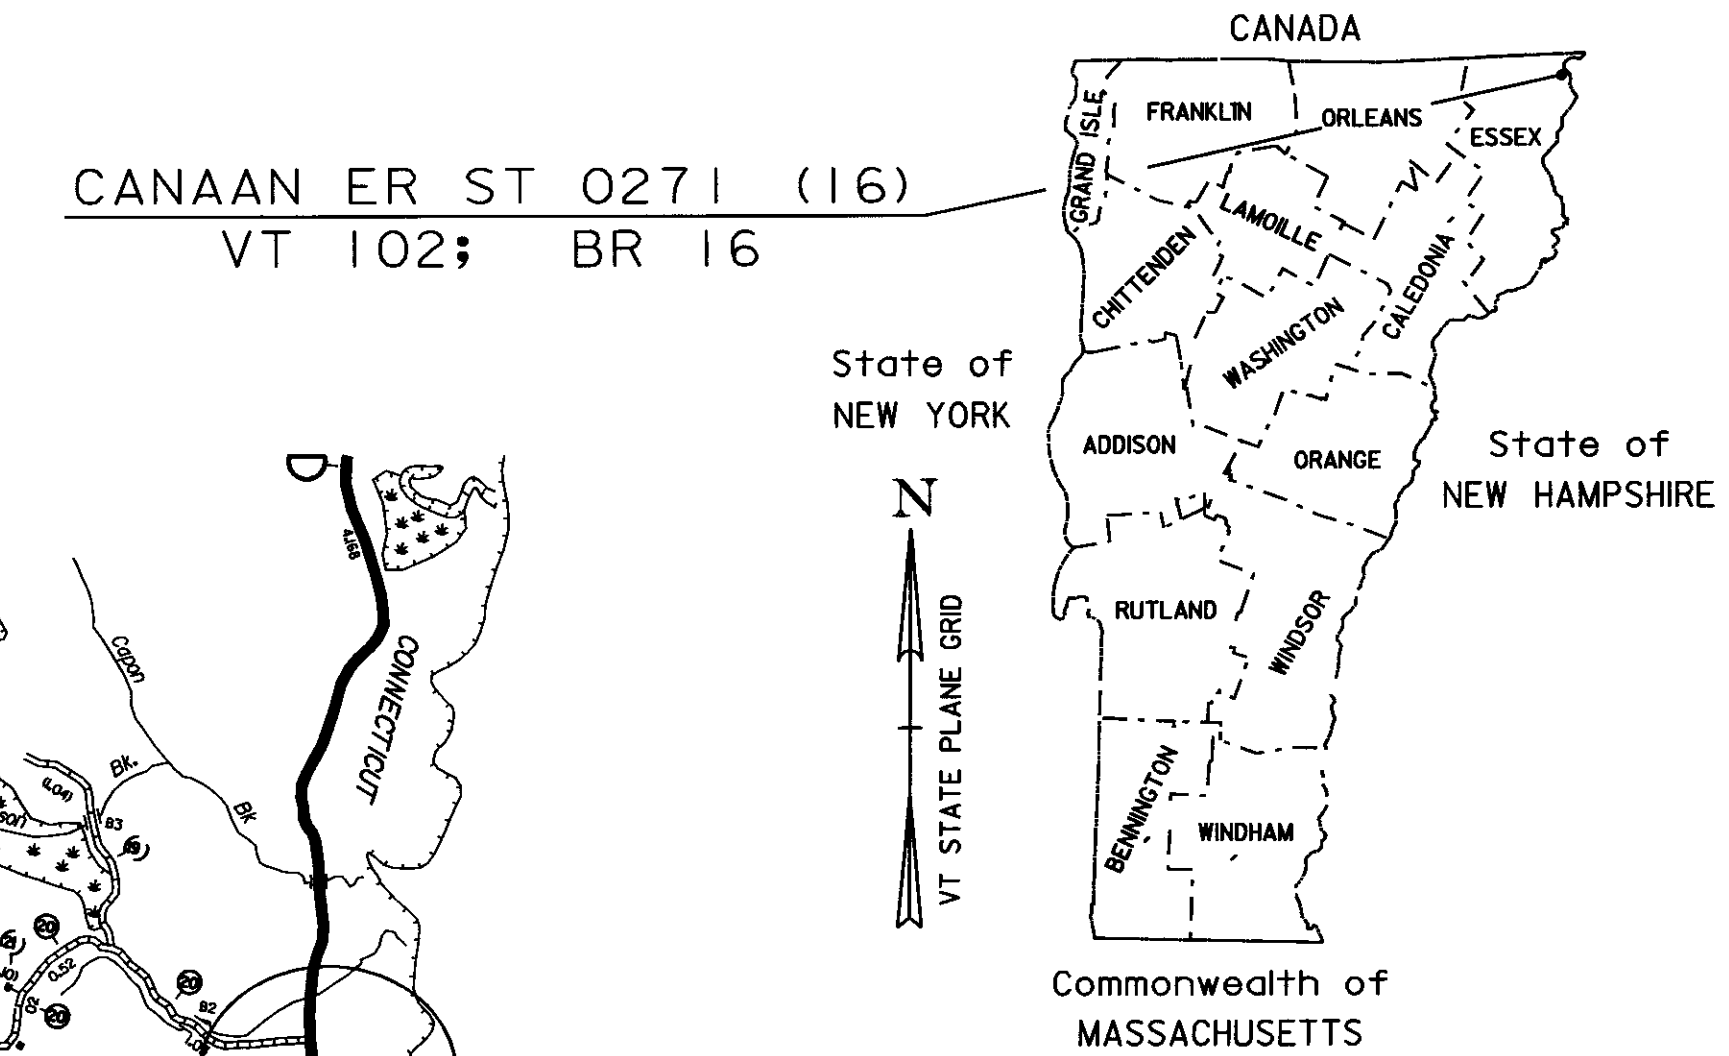

CONVENTIONAL SYMBOLS	
COUNTY LINE	
TOWN LINE	
LIMITS OF ACCESS	
POINT OF ACCESS	
FENCE LINE	
STONE WALL	
TRAVELED WAY	
GUARD RAIL	
RAILROAD	
SURVEY LINE	
CULVERT	
POWER POLE	
TELEPHONE POLE	
TREES	
CONTROL OF ACCESS	
PROPERTY LINE	
R.O.W. TAKING LINE	
SLOPE RIGHTS	
TOP OF CUT	
TOE OF SLOPE	

RECORD PLANS	
CONTRACTOR	WINTerset, INC - LYNDONVILLE, VT
RESIDENT ENGINEER	DOUG BUMPS
CONSTRUCTION BEGAN	OCTOBER 15, 2008
CONSTRUCTION COMPLETE	AUGUST 3, 2009
RECORD PLANS BY	DOUG BUMPS & C. PIERCE
I HEREBY CERTIFY THAT ALL THE CONSTRUCTION REQUIRED BY THIS SET OF DRAWINGS HAS BEEN ACCOMPLISHED AS INDICATED HEREIN	
BY	RESIDENT ENGINEER
DATE	6/15/10
NOTE Any further information concerning final quantities, amounts or other details relative to this project may be found at Central Files in the electronic archives	
SURVEYED BY : R. GILMAN	
SURVEYED DATE : OCT. 19, 2004	
DATUM	
VERTICAL:	NAVD 88
HORIZONTAL:	NAD 83 (96)

CONVENTIONAL SYMBOLS	
COUNTY LINE	
TOWN LINE	
LIMITS OF ACCESS	
POINT OF ACCESS	
FENCE LINE	
STONE WALL	
TRAVELED WAY	
GUARD RAIL	
RAILROAD	
SURVEY LINE	
CULVERT	
POWER POLE	
TELEPHONE POLE	
TREES	
CONTROL OF ACCESS	
PROPERTY LINE	
R.O.W. TAKING LINE	
SLOPE RIGHTS	
TOP OF CUT	
TOE OF SLOPE	

RECORD PLANS	
CONTRACTOR	WINTerset, INC - LYNDONVILLE, VT
RESIDENT ENGINEER	DOUG BUMPS
CONSTRUCTION BEGAN	OCTOBER 15, 2008
CONSTRUCTION COMPLETE	AUGUST 3, 2009
RECORD PLANS BY	DOUG BUMPS & C. PIERCE
I HEREBY CERTIFY THAT ALL THE CONSTRUCTION REQUIRED BY THIS SET OF DRAWINGS HAS BEEN ACCOMPLISHED AS INDICATED HEREIN	
BY	RESIDENT ENGINEER
DATE	6/15/10
NOTE Any further information concerning final quantities, amounts or other details relative to this project may be found at Central Files in the electronic archives	
SURVEYED BY : R. GILMAN	
SURVEYED DATE : OCT. 19, 2004	
DATUM	
VERTICAL:	NAVD 88
HORIZONTAL:	NAD 83 (96)

THESE PLANS ARE SUBJECT TO SUCH ENGINEERING CHANGES AS MAY BE REQUIRED BY THE FEDERAL HIGHWAY ADMINISTRATION OR THE DIRECTOR OF PROGRAM DEVELOPMENT.

CONSTRUCTION IS TO BE CARRIED ON IN ACCORDANCE WITH THESE PLANS AND THE STANDARD SPECIFICATIONS FOR CONSTRUCTION DATED 2006, AS APPROVED BY THE FEDERAL HIGHWAY ADMINISTRATION ON JUNE 15, 2006 FOR USE ON THIS PROJECT, INCLUDING ALL SUBSEQUENT REVISIONS AND SUCH REVISED SPECIFICATIONS AND SPECIAL PROVISIONS AS ARE INCORPORATED IN THESE PLANS.

DIRECTOR OF PROGRAM DEVELOPMENT	
APPROVED	DATE 7-28-09
PROJECT MANAGER : M. EVANS-MONGEON	
PROJECT NAME : CANAAN	
PROJECT NUMBER : ER ST 0271 (16)	
SHEET 1 OF 66 SHEETS	

