

4" YELLOW LINE (DOUBLE) STA. 62+25 - 65+15  
 4" WHITE LINE STA. 62+25 - 65+15 LT  
 STA. 62+25 - 65+15 RT

DELINEATOR WITH STEEL POST (TYPE I)  
 STA. 63+33.50 LT (BLUE)  
 STA. 63+36.50 RT (GREEN)

HEAVY DUTY STEEL BEAM GUARDRAIL, GALVANIZED  
 STA. 62+25.00 - 63+49.23 LT  
 STA. 62+25.00 - 63+49.54 RT

ANCHORS FOR HEAVY DUTY STEEL BEAM GUARDRAIL  
 STA. 63+39.00 LT  
 STA. 63+43.00 RT

REMOVAL AND DISPOSAL OF GUARDRAIL  
 STA. 62+25.00 - 63+37.35 RT  
 STA. 62+25.00 - 63+32.51 LT

CONSTRUCT DRIVE  
 STA. 64+33 LT, 12' - GRAVEL  
 STA. 63+98 RT, 14' - GRAVEL

END R.O.W. PROJECT  
 ER ST 0271(16)  
 STA. 65+30.83  
 24.32' RT.

SARACO, MICHAEL D. III  
 & MAGUIRE, KEVIN C.



END APPROACH  
 STA 65+15.00  
 65+30.83  
 25.18 LT.

SARACO, MICHAEL D. III  
 & MAGUIRE, KEVIN C.

RICHARDS, DENNIS B. & LISA G.

ADDITIONAL ROW ACQUIRED  
 2/9/73 BK. X PG. 332  
 CANAAN LAND RECORDS  
 FROM ROLAND & EUNICE RICHARDS

LINES SHOWN ON THIS PLAN AS EXISTING PROPERTY LINES P/L ARE BELIEVED TO BE ACCURATE BUT SHOULD NOT BE RELIED UPON FOR PURPOSES UNRELATED TO THE STATE OF VERMONT'S ACQUISITION OF LAND AND RIGHTS FOR THIS PROJECT.

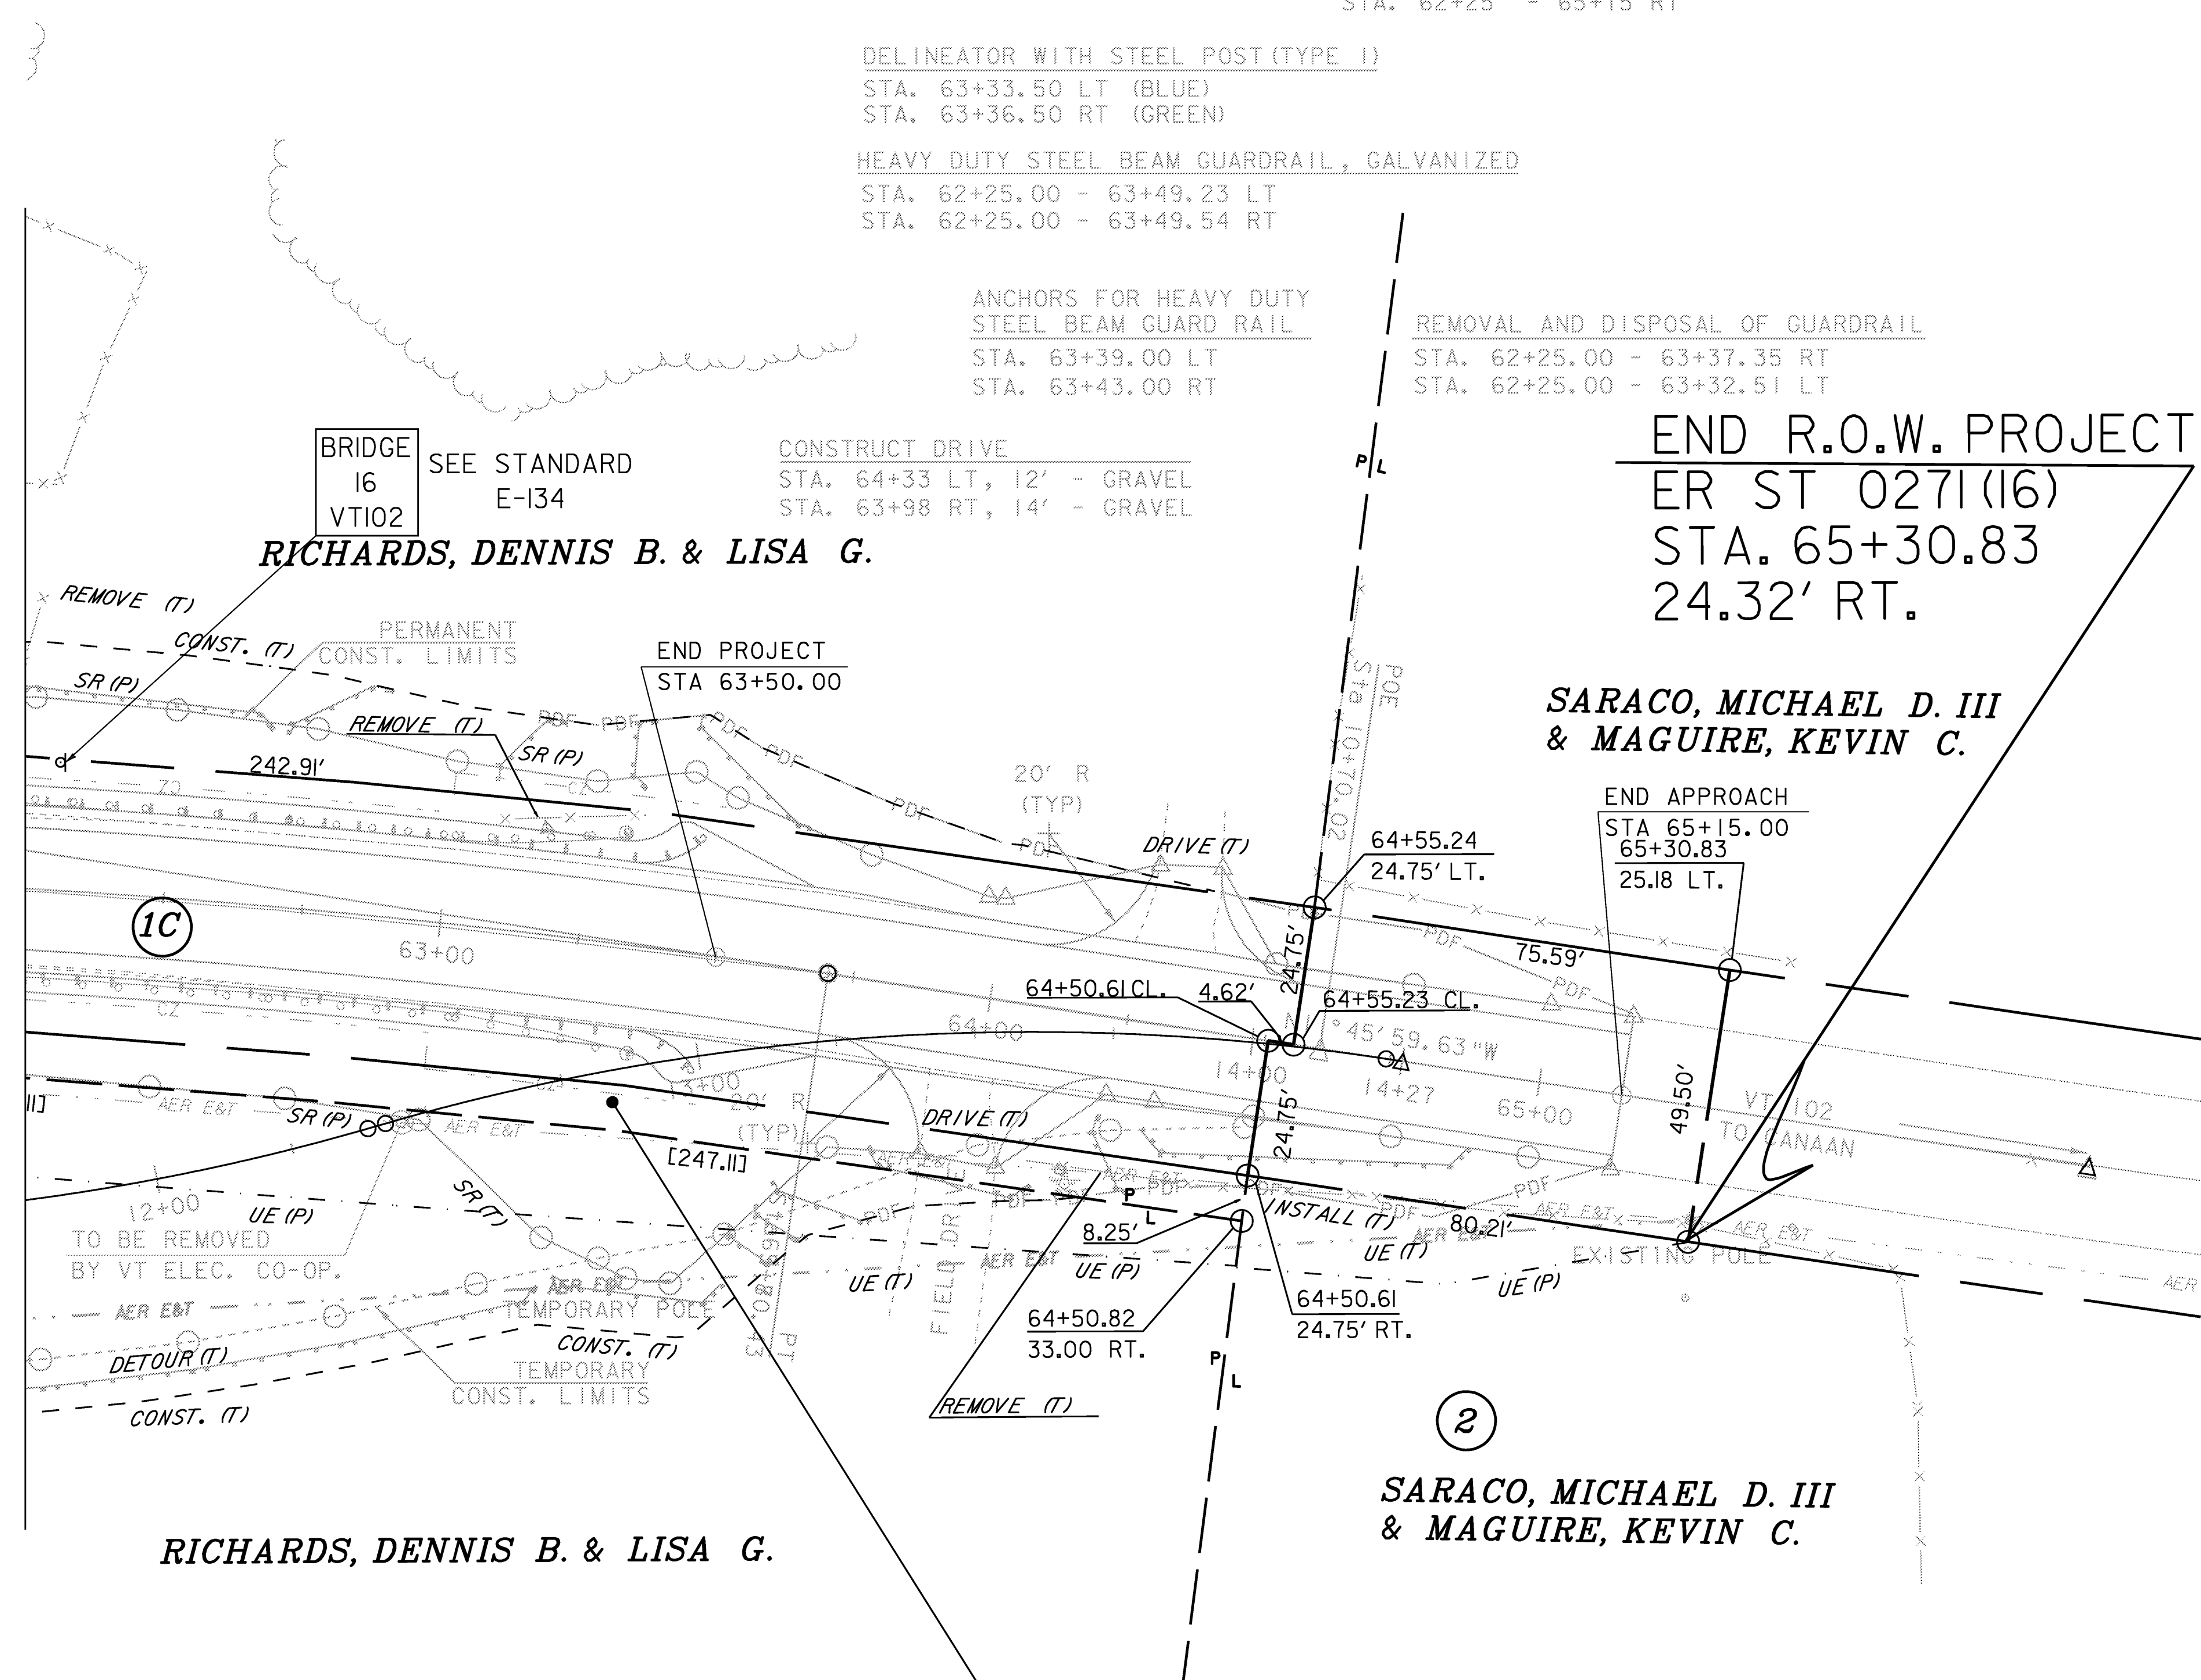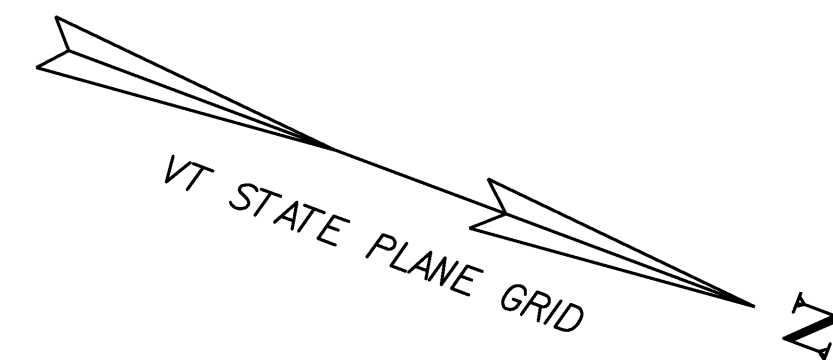

SCALE 1" = 20'-0"  
 20 0 20

**ROW LAYOUT SHEET #2**

PROJECT NAME: Canaan	PLOT DATE: 18-AUG-2008
PROJECT NUMBER: ER ST 0271(16)	DRAWN BY: L. DUQUETTE
FILE NAME: 04c098\struc\04c098bdr	CHECKED BY: S. SCRIBNER
PROJECT LEADER: M. Evans-Mongeon	DESIGNED BY: S. SCRIBNER
ROW SHEET 15 OF 15	SHEET 10 OF 66