


LEGEND

CLASS II WETLAND	
EXISTING COUNTOURS	
SOIL BOUNDARY	
WETLAND BUFFER ZONE	
AGRICULTURAL	
SILT FENCE	
PERM. CONSTRUCTION LIMITS	
TEMP. CONSTRUCTION LIMITS	
PROJECT DEMARCATION FENCE	
EROSION MATTING	
GEOTEXTILE FOR ROAD BED SEPERATOR	
BARRIER FENCE	
PROPOSED SEDIMENT DEWATERING LOCATION	

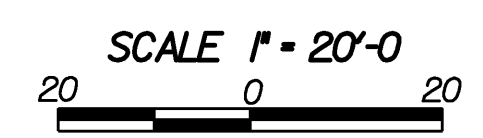

EROSION AND SEDIMENT CONTROL PLAN (2)

PROJECT NAME: Canaan	PLOT DATE: 18-AUG-2008
PROJECT NUMBER: ER ST 0271(16)	DRAWN BY: T. Husk
FILE NAME: Structures\X04c098erobdr.d	CHECKED BY: S. SCRIBNER
PROJECT LEADER: M. Evans-Mongeon	SHEET 20 OF 66
DESIGNED BY: S. Scribner	