

BEGIN APPROACH
STA 57+50.00
DETOUR STATION
7+00

BEGIN PROJECT
STA 58+50.00
30' R
(TYP)

STA. 60+65.00 MAINLINE
STA. 16+77.00 CHANNEL LINE
 $\Delta = 90^\circ$ TO TANGENT

BEGIN BRIDGE
STA 60+92.00


SPECIAL PROVISION
(DRY HYDRANT)

END BRIDGE
STA 61+76.00

STONE FILL
TYPE III

LEGEND

| | |
|---------------------|--|
| CLASS II WETLAND | |
| EXISTING CONTOURS | |
| SOIL BOUNDARY | |
| WETLAND BUFFER ZONE | |
| AGRICULTURAL | |

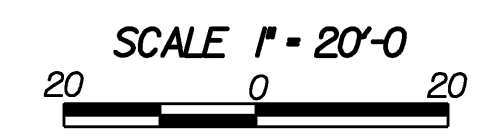

CONTOURS SHOWN ARE EXISTING CONTOURS,
SEE CROSS SECTIONS FOR PROPOSED CONTOURS.

FINAL CONDITIONS SITE PLAN (1)

| | | | |
|-----------------|---------------------------|--------------|-------------|
| PROJECT NAME: | Canaan | PLOT DATE: | 18-AUG-2008 |
| PROJECT NUMBER: | ER ST 0271(16) | DRAWN BY: | T. Husk |
| FILE NAME: | Structures\04c098erobdr.d | DESIGNED BY: | S. Scribner |
| PROJECT LEADER: | M. Evans-Mongeon | CHECKED BY: | S. SCRIBNER |
| DESIGNED BY: | S. Scribner | SHEET 21 | OF 66 |

MATCHLINE STA 62+25