


LEGEND

CLASS II WETLAND	
EXISTING COUNTOURS	
SOIL BOUNDARY	
WETLAND BUFFER ZONE	
AGRICULTURAL	

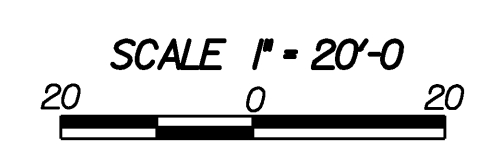

CONTOURS SHOWN ARE EXISTING CONTOURS,
SEE CROSS SECTIONS FOR PROPOSED CONTOURS.

FINAL CONDITIONS SITE PLAN (2)

PROJECT NAME:	Canaan	PLOT DATE:	18-AUG-2008
PROJECT NUMBER:	ER ST 0271(16)	DRAWN BY:	T. Husk
FILE NAME:	Structures\04c098erobdr.d	DESIGNED BY:	S. Scribner
PROJECT LEADER:	M. Evans-Mongeon	CHECKED BY:	S. SCRIBNER
			SHEET 22 OF 66