


**PLAN**

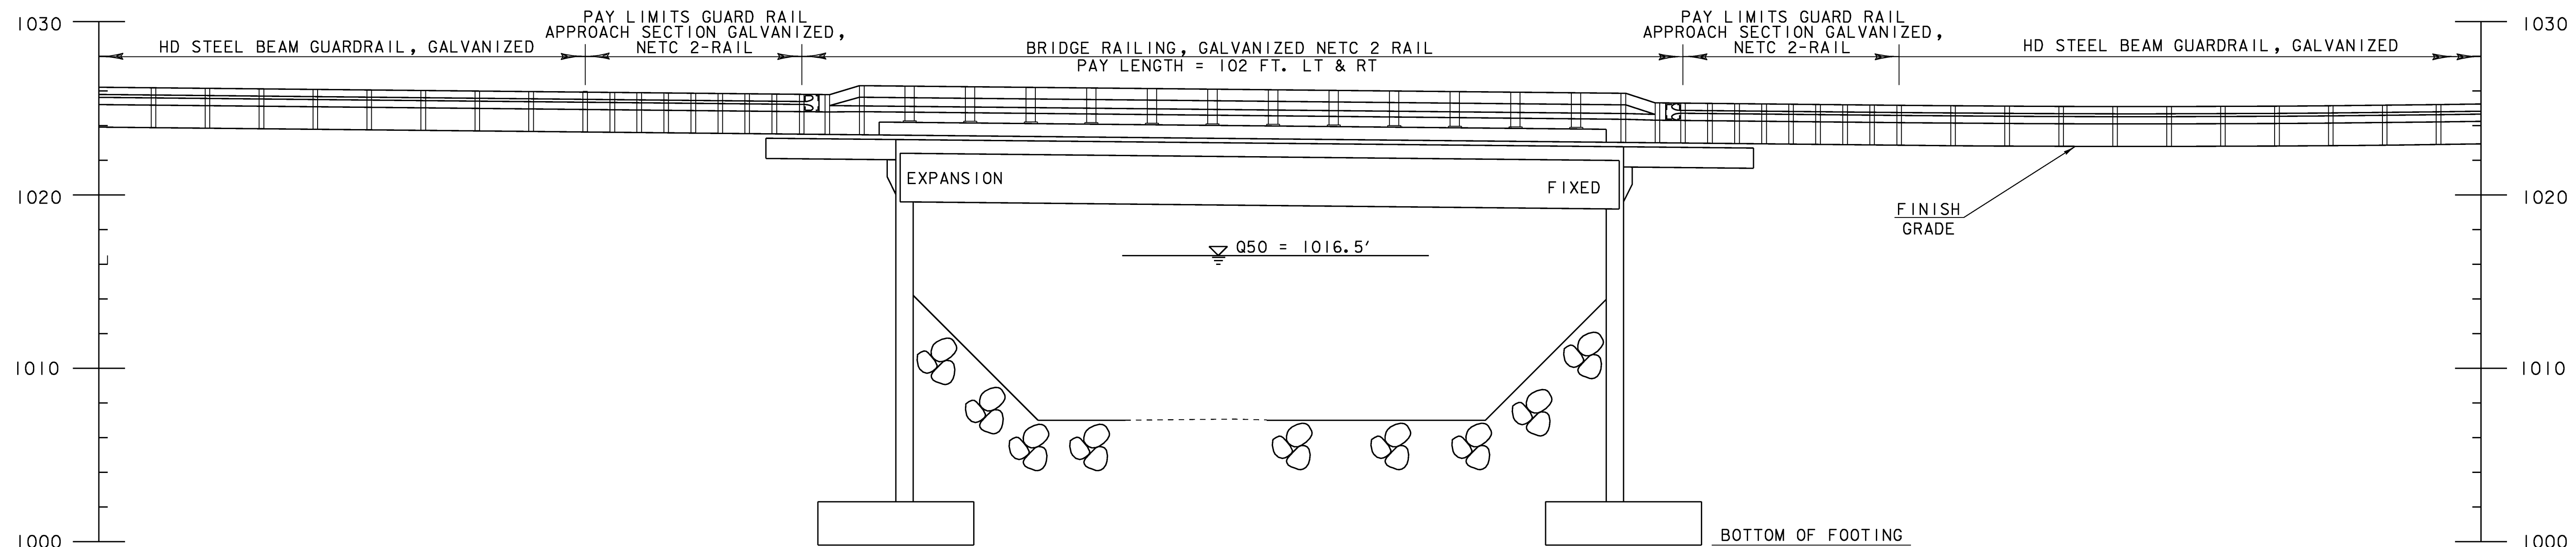

**ELEVATION**

SCALE 1" = 10'-0"  
 10 0 10

**PLAN AND ELEVATION**

PROJECT NAME:	Canaan	PLOT DATE:	18-AUG-2008
PROJECT NUMBER:	ER ST 0271(16)	DRAWN BY:	L. DUQUETTE
FILE NAME:	Structures/04c098pe.dgn	CHECKED BY:	S. SCRIBNER
PROJECT LEADER:	M. Evans-Mongeon	SHEET 31	OF 66