

MATCHLINE STA 62+25

END PROJECT
STA 63+50.00


END APPROACH
STA 65+15.00

TO BE REMOVED
BY VT ELEC. CO-OP.

TEMPORARY POLE

EXISTING POLE

VT 102
TO CANAAN

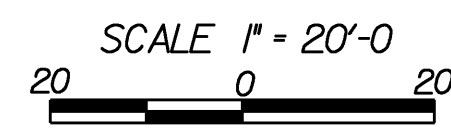

UTILITIES SHEET #2

PROJECT NAME:	Canaan	PLOT DATE:	18-AUG-2008
PROJECT NUMBER:	ER ST 0271(16)	DRAWN BY:	L. DUQUETTE
FILE NAME:	04c098\str\04c098u11bdr	DESIGNED BY:	S. Scribner
		CHECKED BY:	S. SCRIBNER
			SHEET 33 OF 66