


FRAMING PLAN

NOTE: CAMBER AND DEFLECTION MEASUREMENTS ARE GIVEN IN INCHES TO THE NEAREST SIXTEENTH. MEASUREMENTS INCLUDE BEAM SELF-WEIGHT.


DRIP PLATE  
SEE DETAIL

\*\* CL BEARING #1  
STA. 60+93.00  
ABUTMENT 1

\*\* CL BEARING #2  
STA. 61+75.00  
ABUTMENT 2

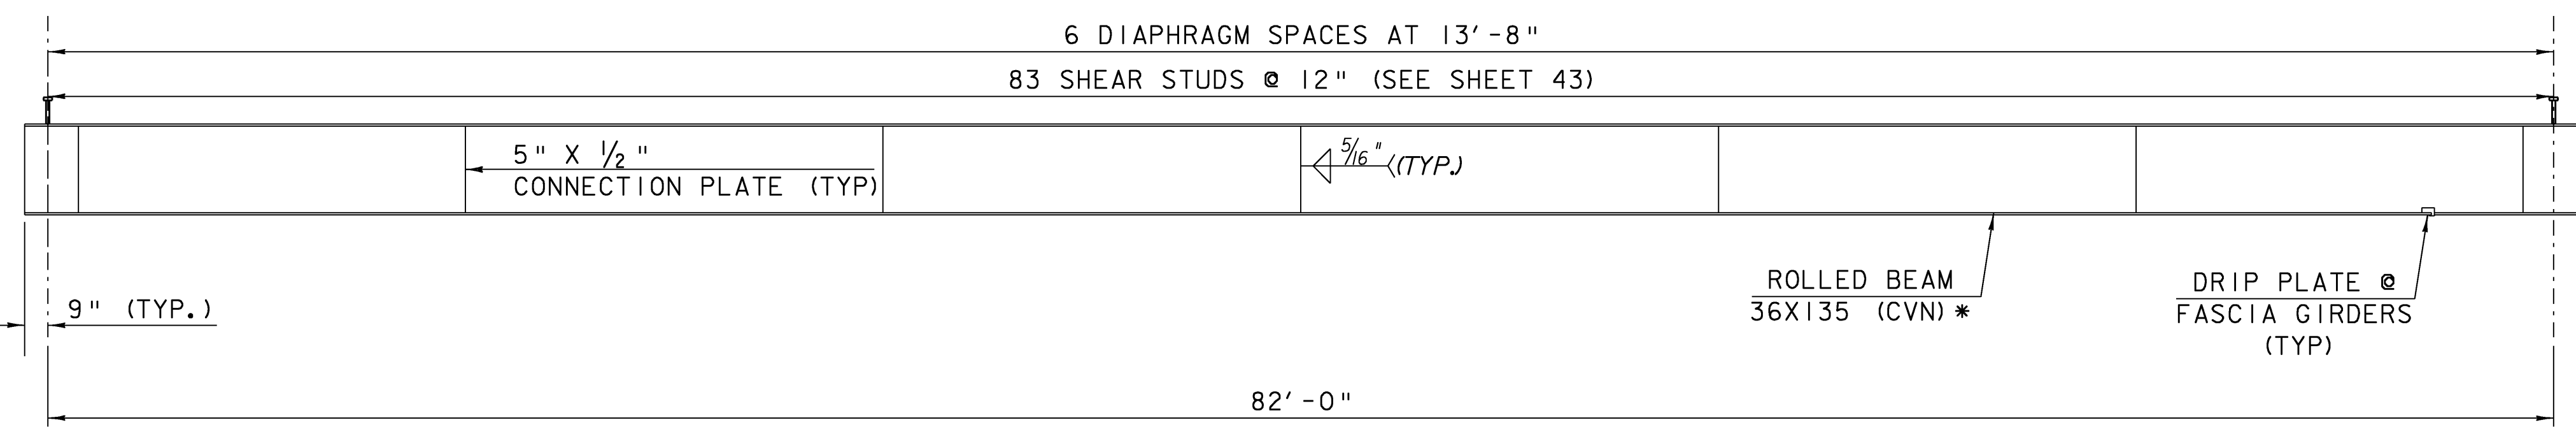

ROLLED BEAMS

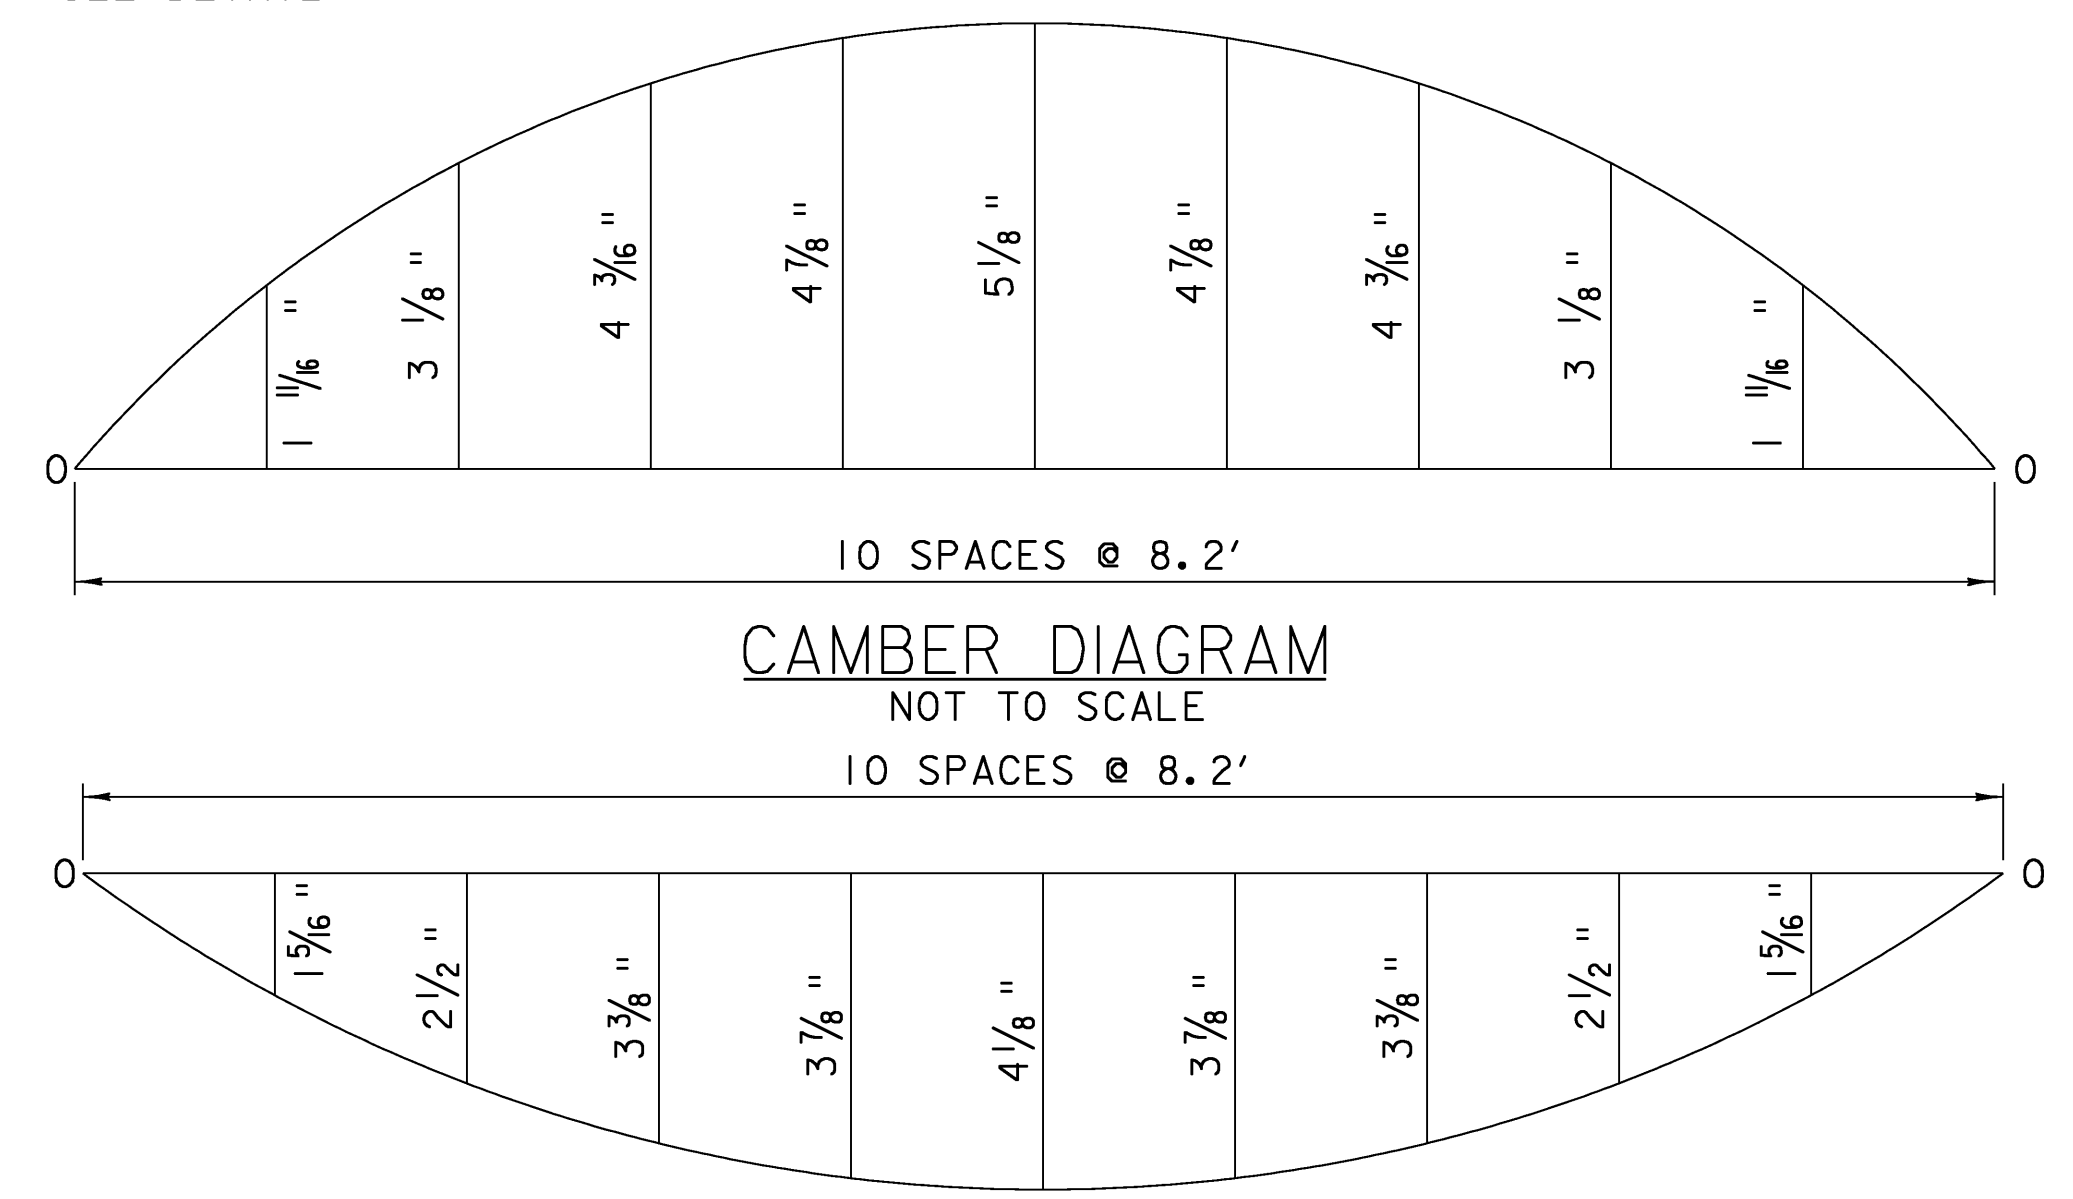

CAMBER DIAGRAM

DEAD LOAD DEFLECTION DIAGRAM

SEE SHEET 42 FOR  
DETAILS

SCALE 1/4" = 1'-0"  
1 0 2 4 6

\* CVN - SHALL MEET CHARPY V-NOTCH REQUIREMENTS FOR MAIN MEMBERS AS INDICATED IN SECTION 714 OF THE STANDARD SPECIFICATIONS  
\*\* HOLES FOR TRANSVERSE ABUTMENT REINFORCING STEEL NOT SHOWN. SEE SHEET 40

**FRAMING PLAN**

PROJECT NAME:	CANAAN	PLOT DATE:	18-AUG-2008
PROJECT NUMBER:	ER ST 0271(16)	DRAWN BY:	L. DUQUETTE
FILE NAME:	04c098/struc./s04c098sup	CHECKED BY:	S. SCRIBNER
DESIGNED BY:	S. SCRIBNER	SHEET	36 OF 66