



ABUTMENT NO. 1 PLAN

SCALE 3/16" = 1'-0"
0 2 4 6 8

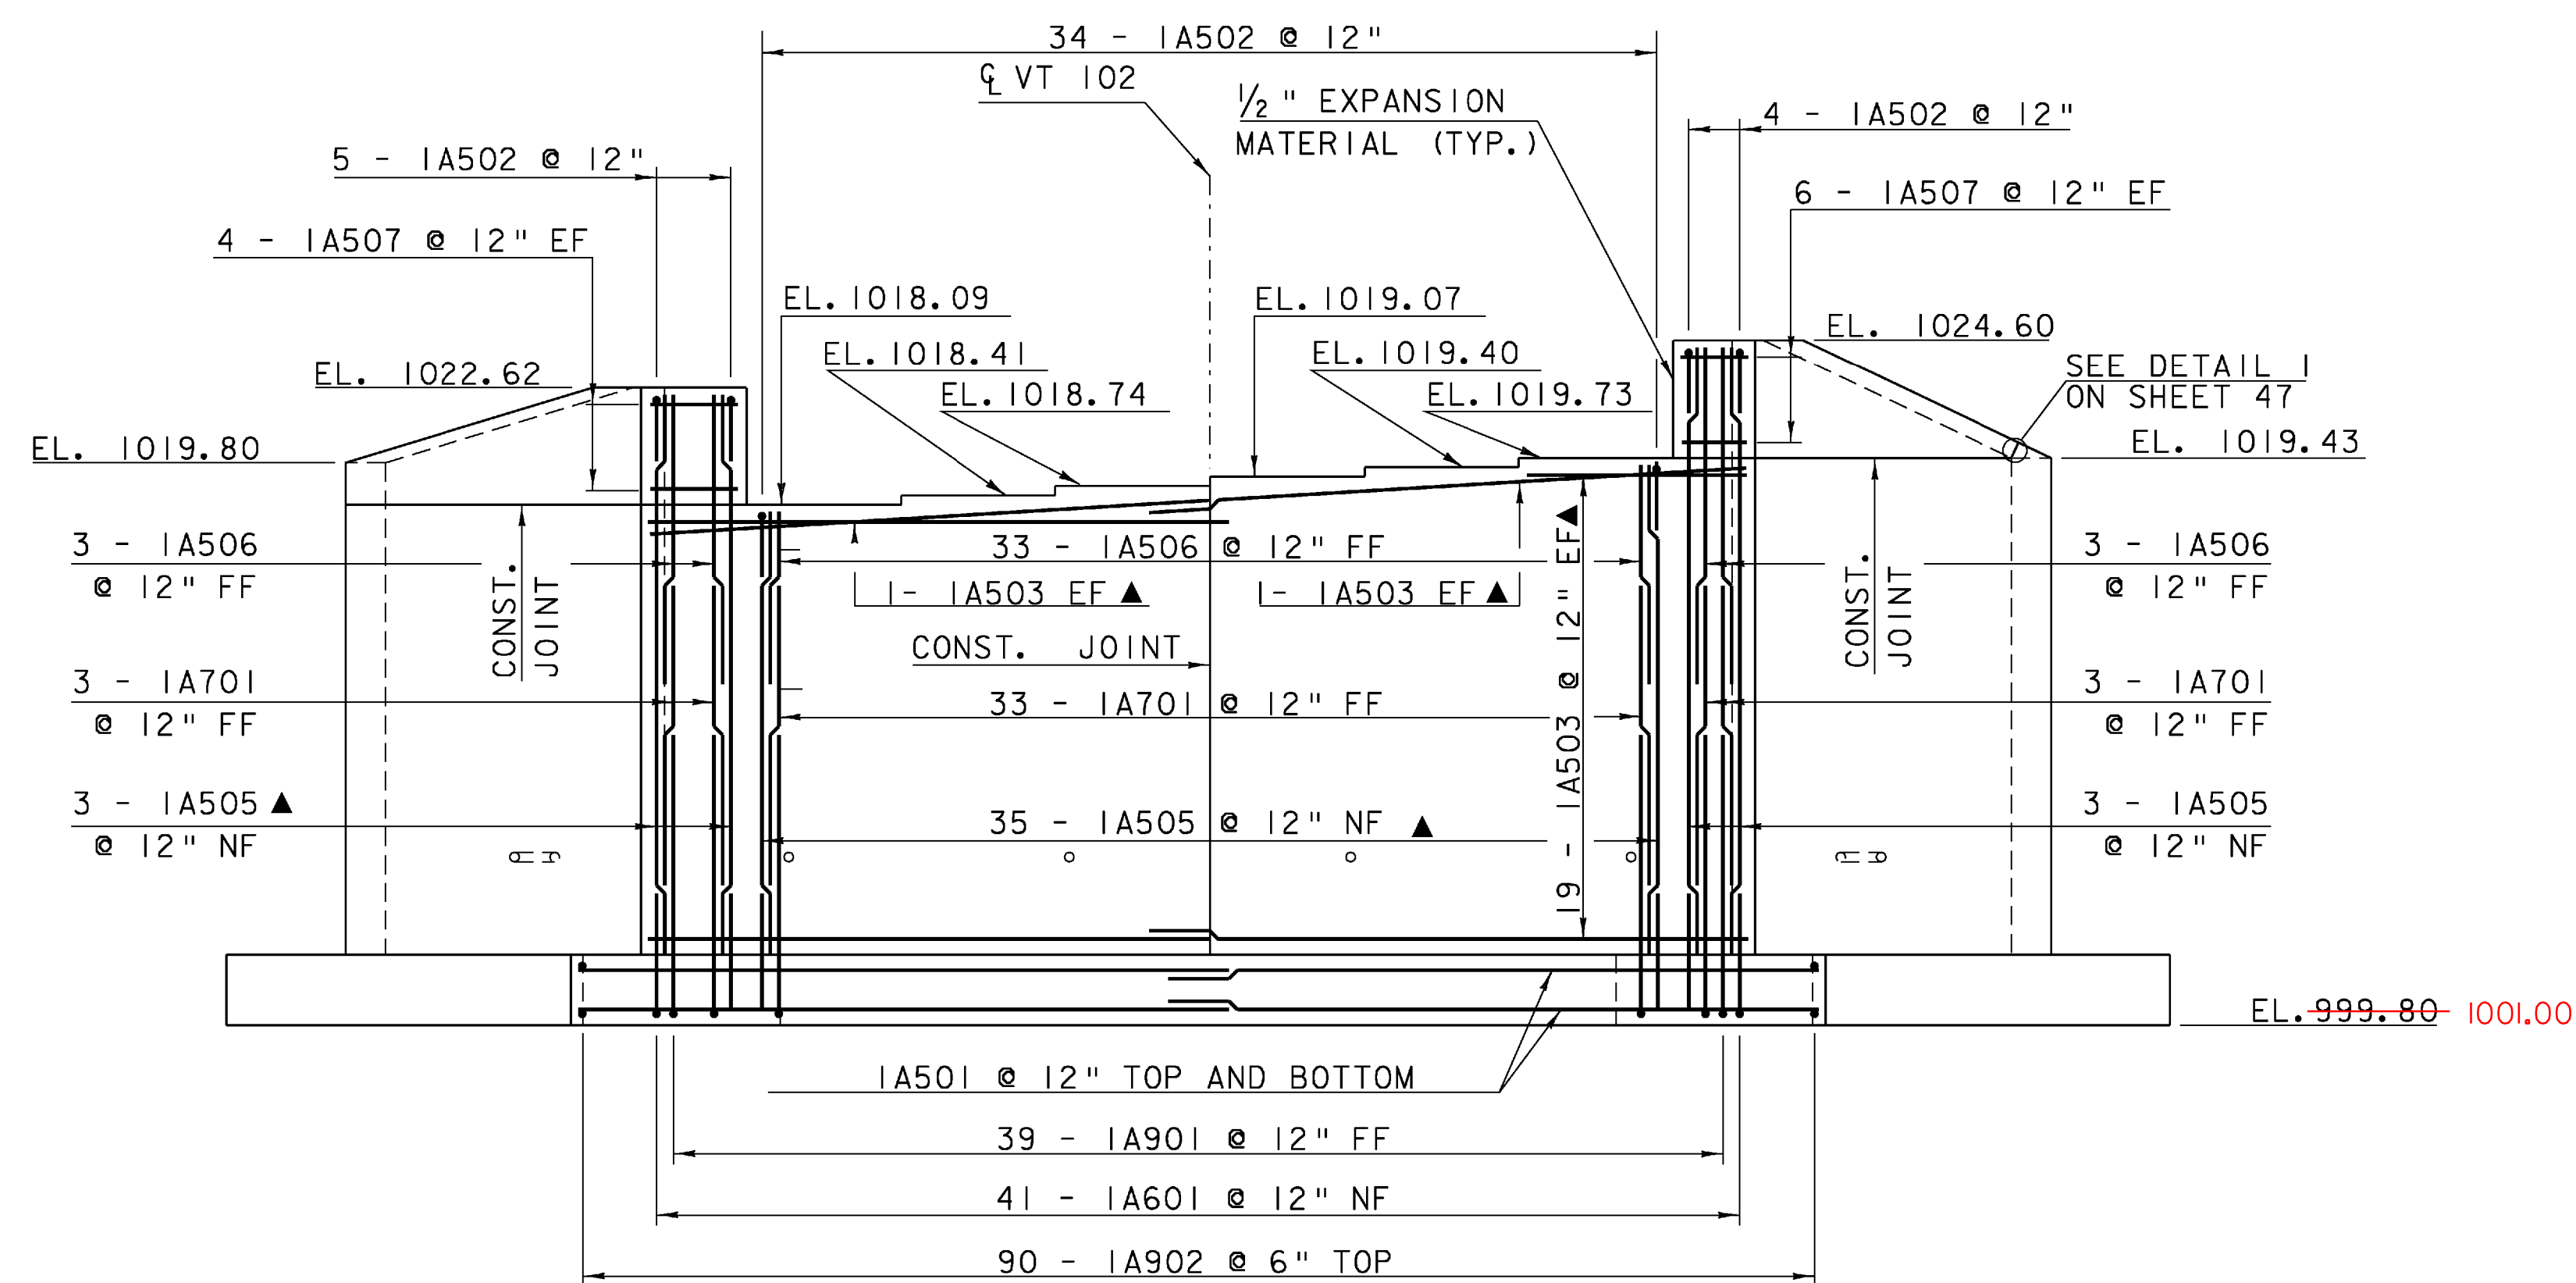

ABUTMENT NO. 1 ELEVATION

SCALE 3/16" = 1'-0"
0 2 4 6 8

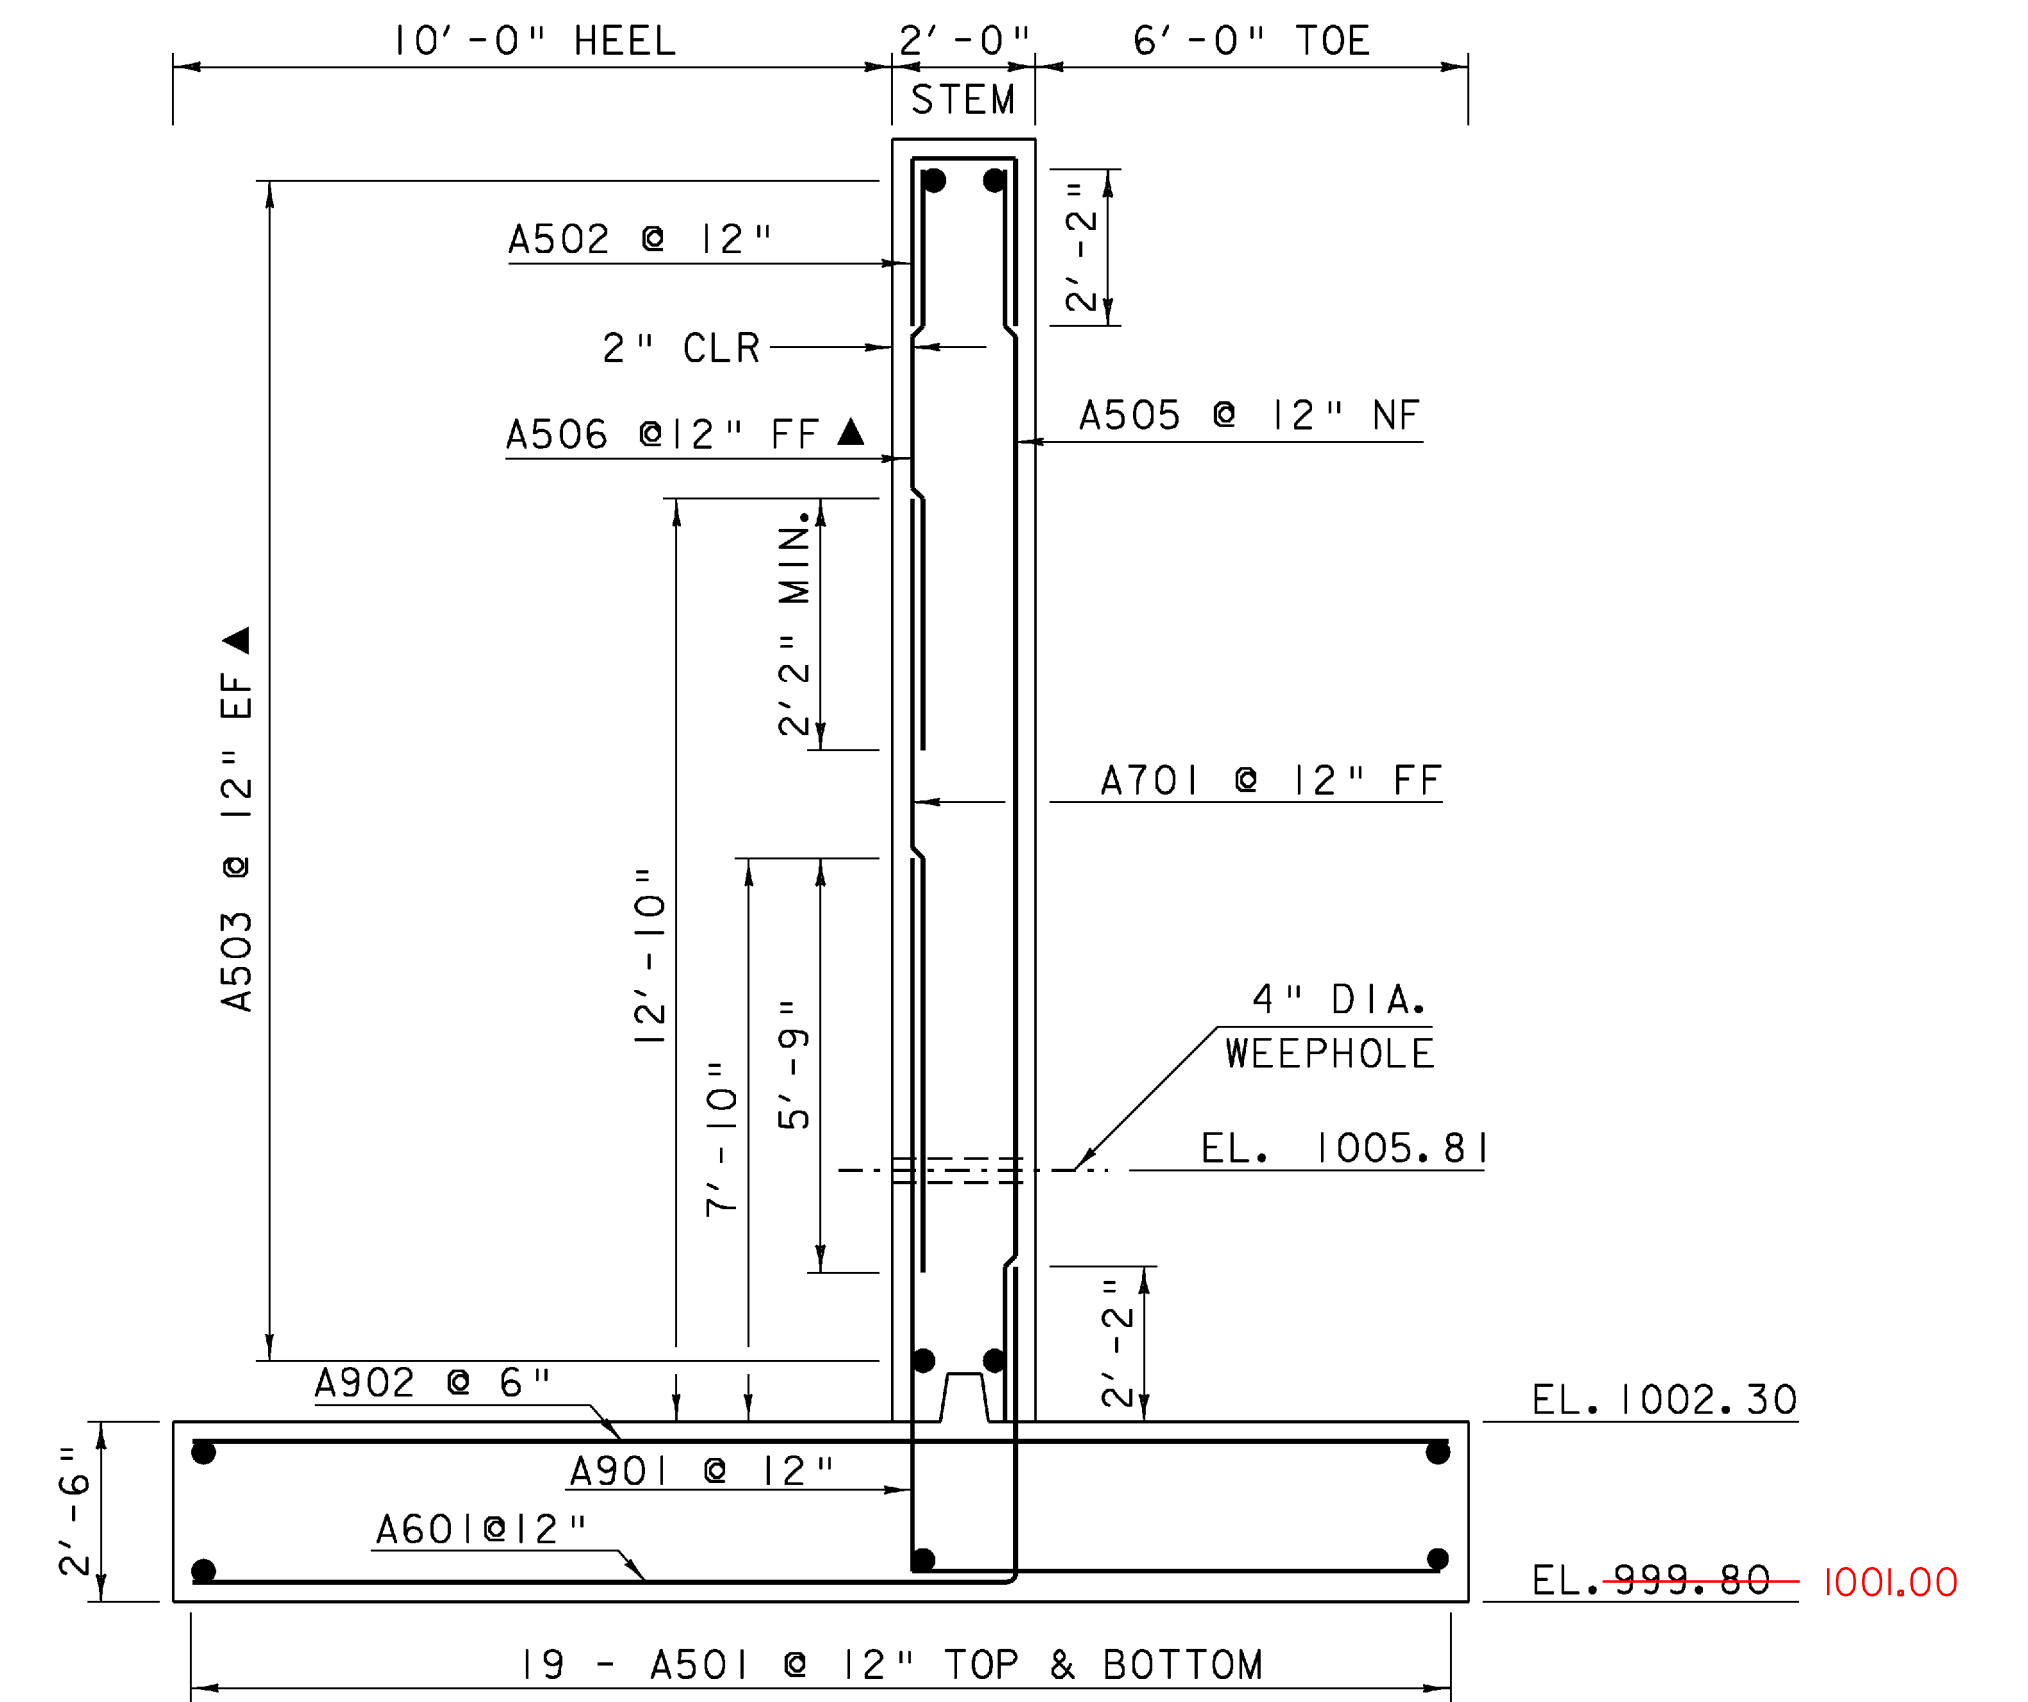

ABUTMENT TYPICAL

SCALE 3/8" = 1'-0"
0 1 2 3 4

NOTE:

- NF = NEAR FACE
- FF = FAR FACE
- EF = EACH FACE
- ▲ = CUT TO FIT IN FIELD
- 3" CLEAR, UNLESS OTHERWISE SPECIFIED ON THE PLANS.
- 2'-2" BAR LAP UNLESS OTHERWISE SPECIFIED ON THE PLANS.

ALL DIMENSIONS ARE TAKEN FROM THE MAJOR CHORD NOT FROM THE C OF VT 102

ABUTMENT #1 DETAILS

PROJECT NAME: CANAAN
PROJECT NUMBER: ER ST 0271(16)

FILE NAME: 04c098/s+ruc./s04c098sup	PLOT DATE: 18-AUG-2008
PROJECT LEADER: M. EVANS-MONGEON	DRAWN BY: C. JOLLY
DESIGNED BY: S. SCRIBNER	CHECKED BY: S. SCRIBNER
	SHEET 44 OF 66