


ABUTMENT NO. 1 FOOTING REINFORCING PLAN

SCALE  $\frac{3}{16}'' = 1'-0$   
 1 0 2 4 6 8

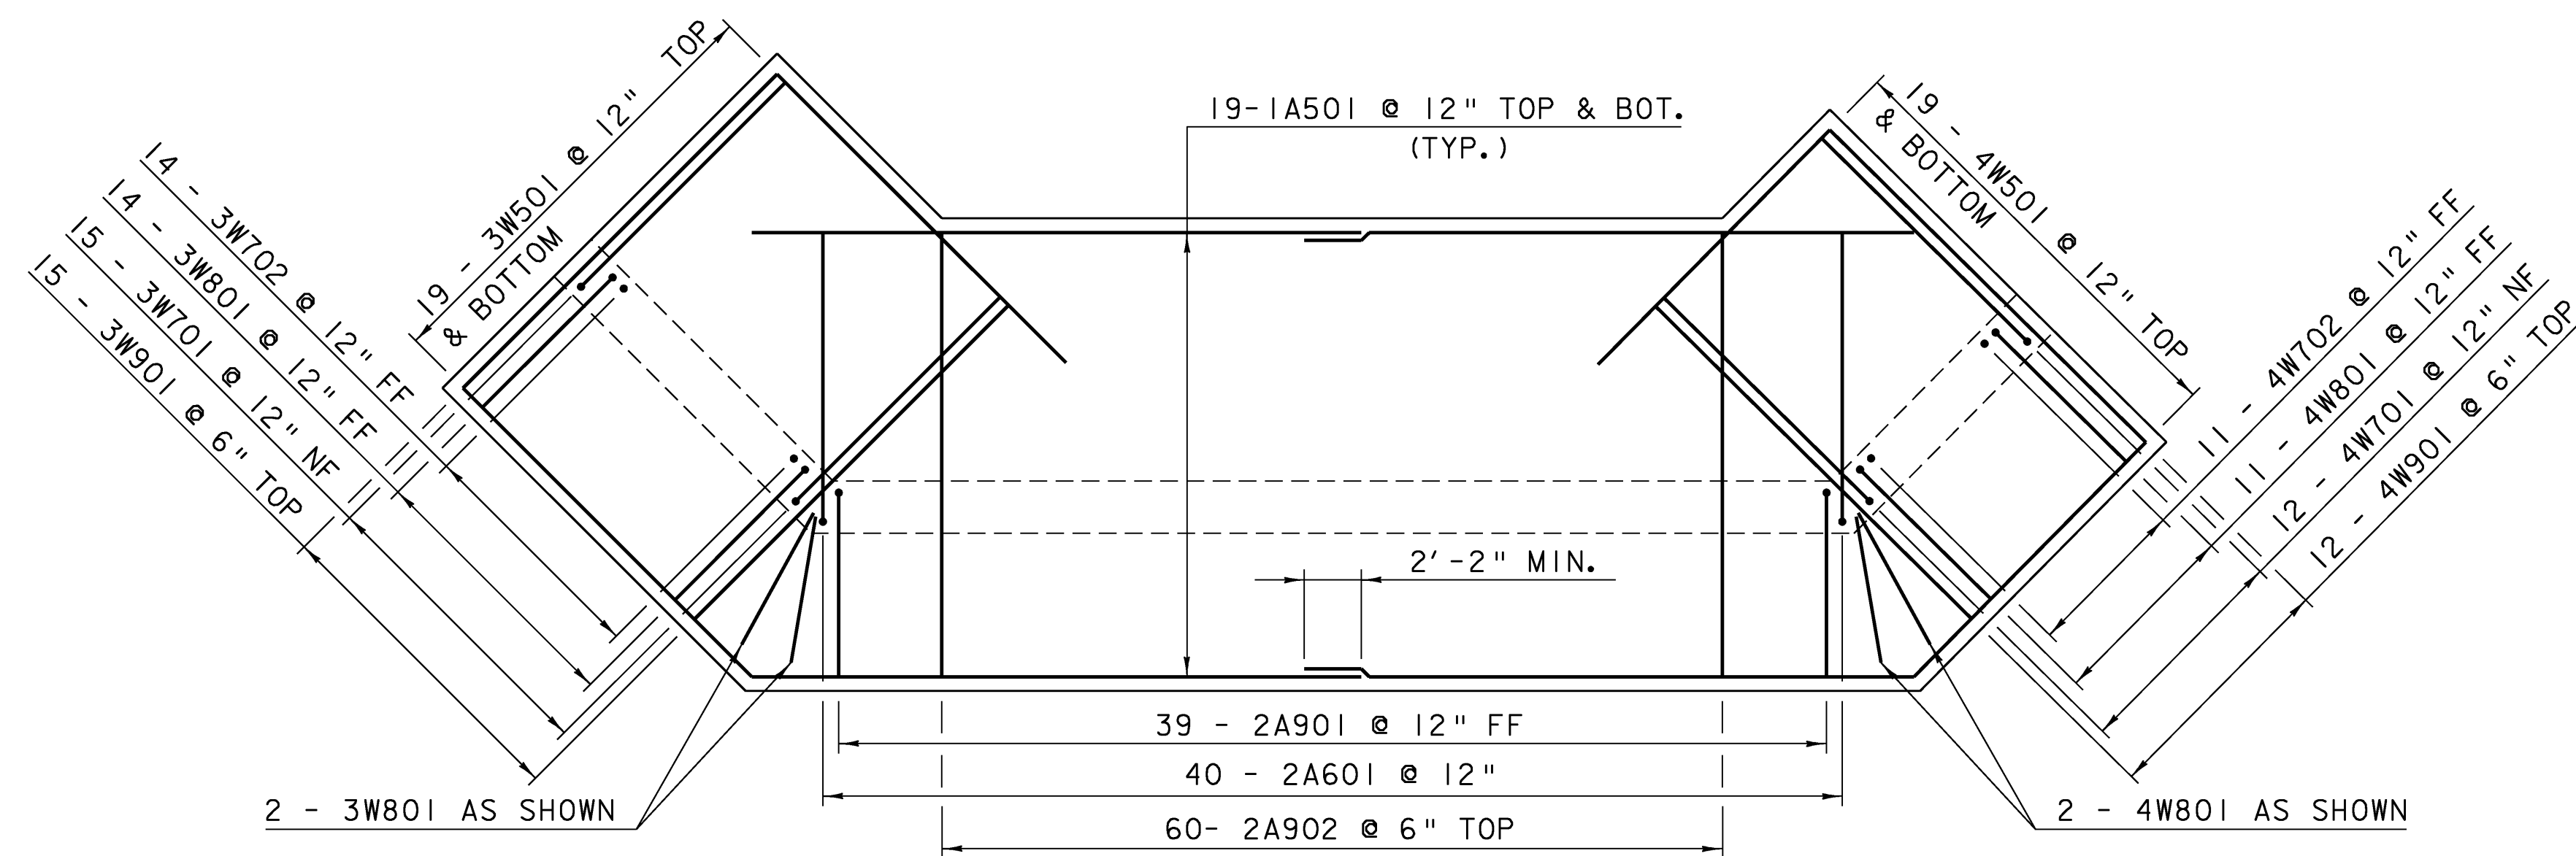

ABUTMENT NO. 2 FOOTING REINFORCING PLAN

SCALE  $\frac{3}{16}'' = 1'-0$   
 1 0 2 4 6 8

**NOTE:**

- NF = NEAR FACE
- FF = FAR FACE
- EF = EACH FACE
- ▲ = CUT TO FIT IN FIELD
- 3" CLEAR, UNLESS OTHERWISE SPECIFIED ON THE PLANS.
- 2'-2" BAR LAP UNLESS OTHERWISE SPECIFIED ON THE PLANS.

**FOOTING REINFORCING PLAN**

PROJECT NAME: CANAAN  
 PROJECT NUMBER: ER ST 0271(16)

FILE NAME: 04c098/struc./s04c098sup PLOT DATE: 18-AUG-2008  
 PROJECT LEADER: M. EVANS-MONGEON DRAWN BY: C. JOLLY  
 DESIGNED BY: S. SCRIBNER CHECKED BY: S. SCRIBNER  
 SHEET 46 OF 66