


SCALE 1" = 10'-0"
 10 0 10

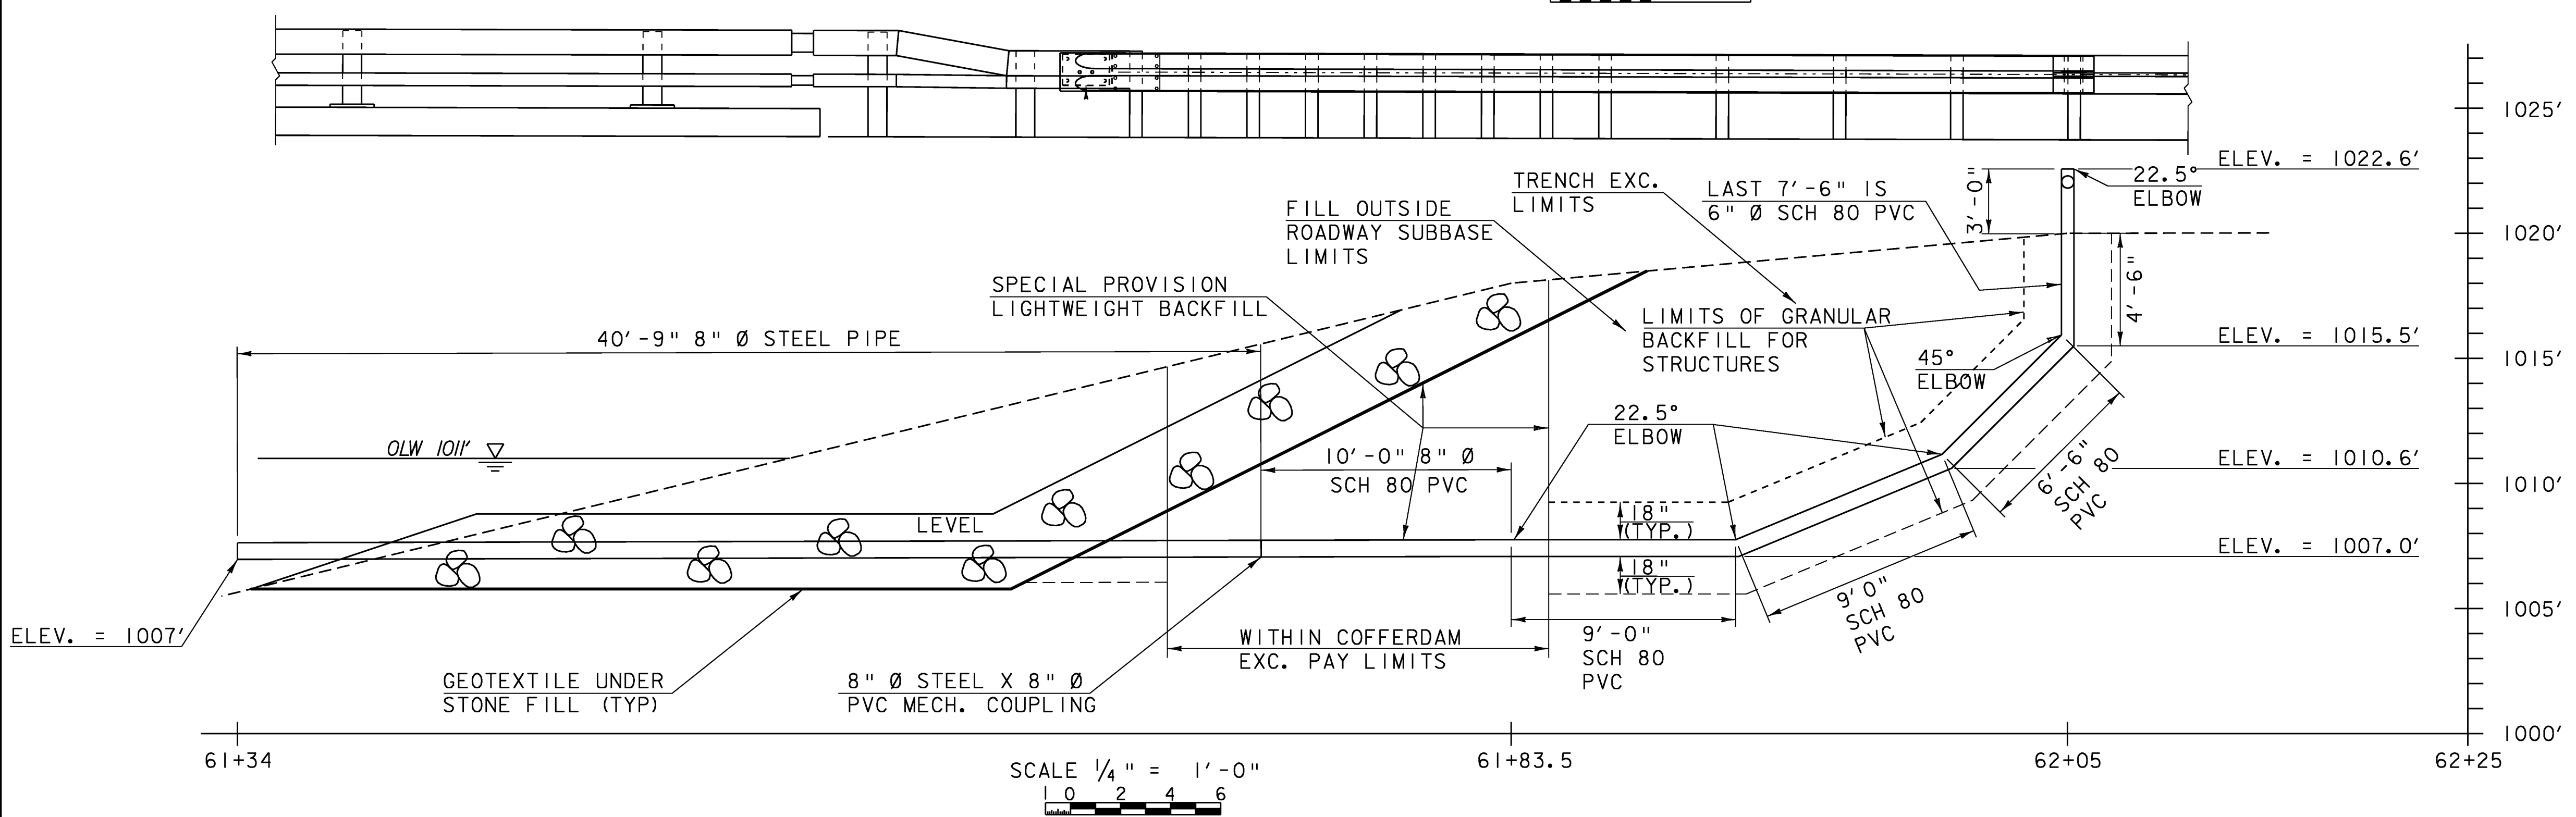

SCALE 1/4" = 1'-0"
 1 0 2 4 6

*CARE SHALL BE GIVEN THAT ANY EXCAVATION OUTSIDE THE COFFERDAM EXCAVATION LIMITS AND CHANNEL EXCAVATION LIMITS FOR THE PURPOSE OF PLACING THE DRY HYDRANT WILL BE PAID UNDER TRENCH EXCAVATION LIMITS

- NOTE:
1. VERIFY LENGTH TO DEEPEST CHANNEL POINT IN FIELD PRIOR TO INSTALLATION
 2. SEE CHANNEL CROSS SECTION 17+00

DRY HYDRANT DETAIL

PROJECT NAME:	Canaan	FILE NAME:	Structures\X04c098xs.dgn	PLOT DATE:	19-AUG-2008
PROJECT NUMBER:	ER ST 027(16)	PROJECT LEADER:	M. Evans-Mongeon	DRAWN BY:	L. DUQUETTE
		DESIGNED BY:	S. Scribner	CHECKED BY:	S. SCRIBNER
					SHEET 50 OF 66