




57+64

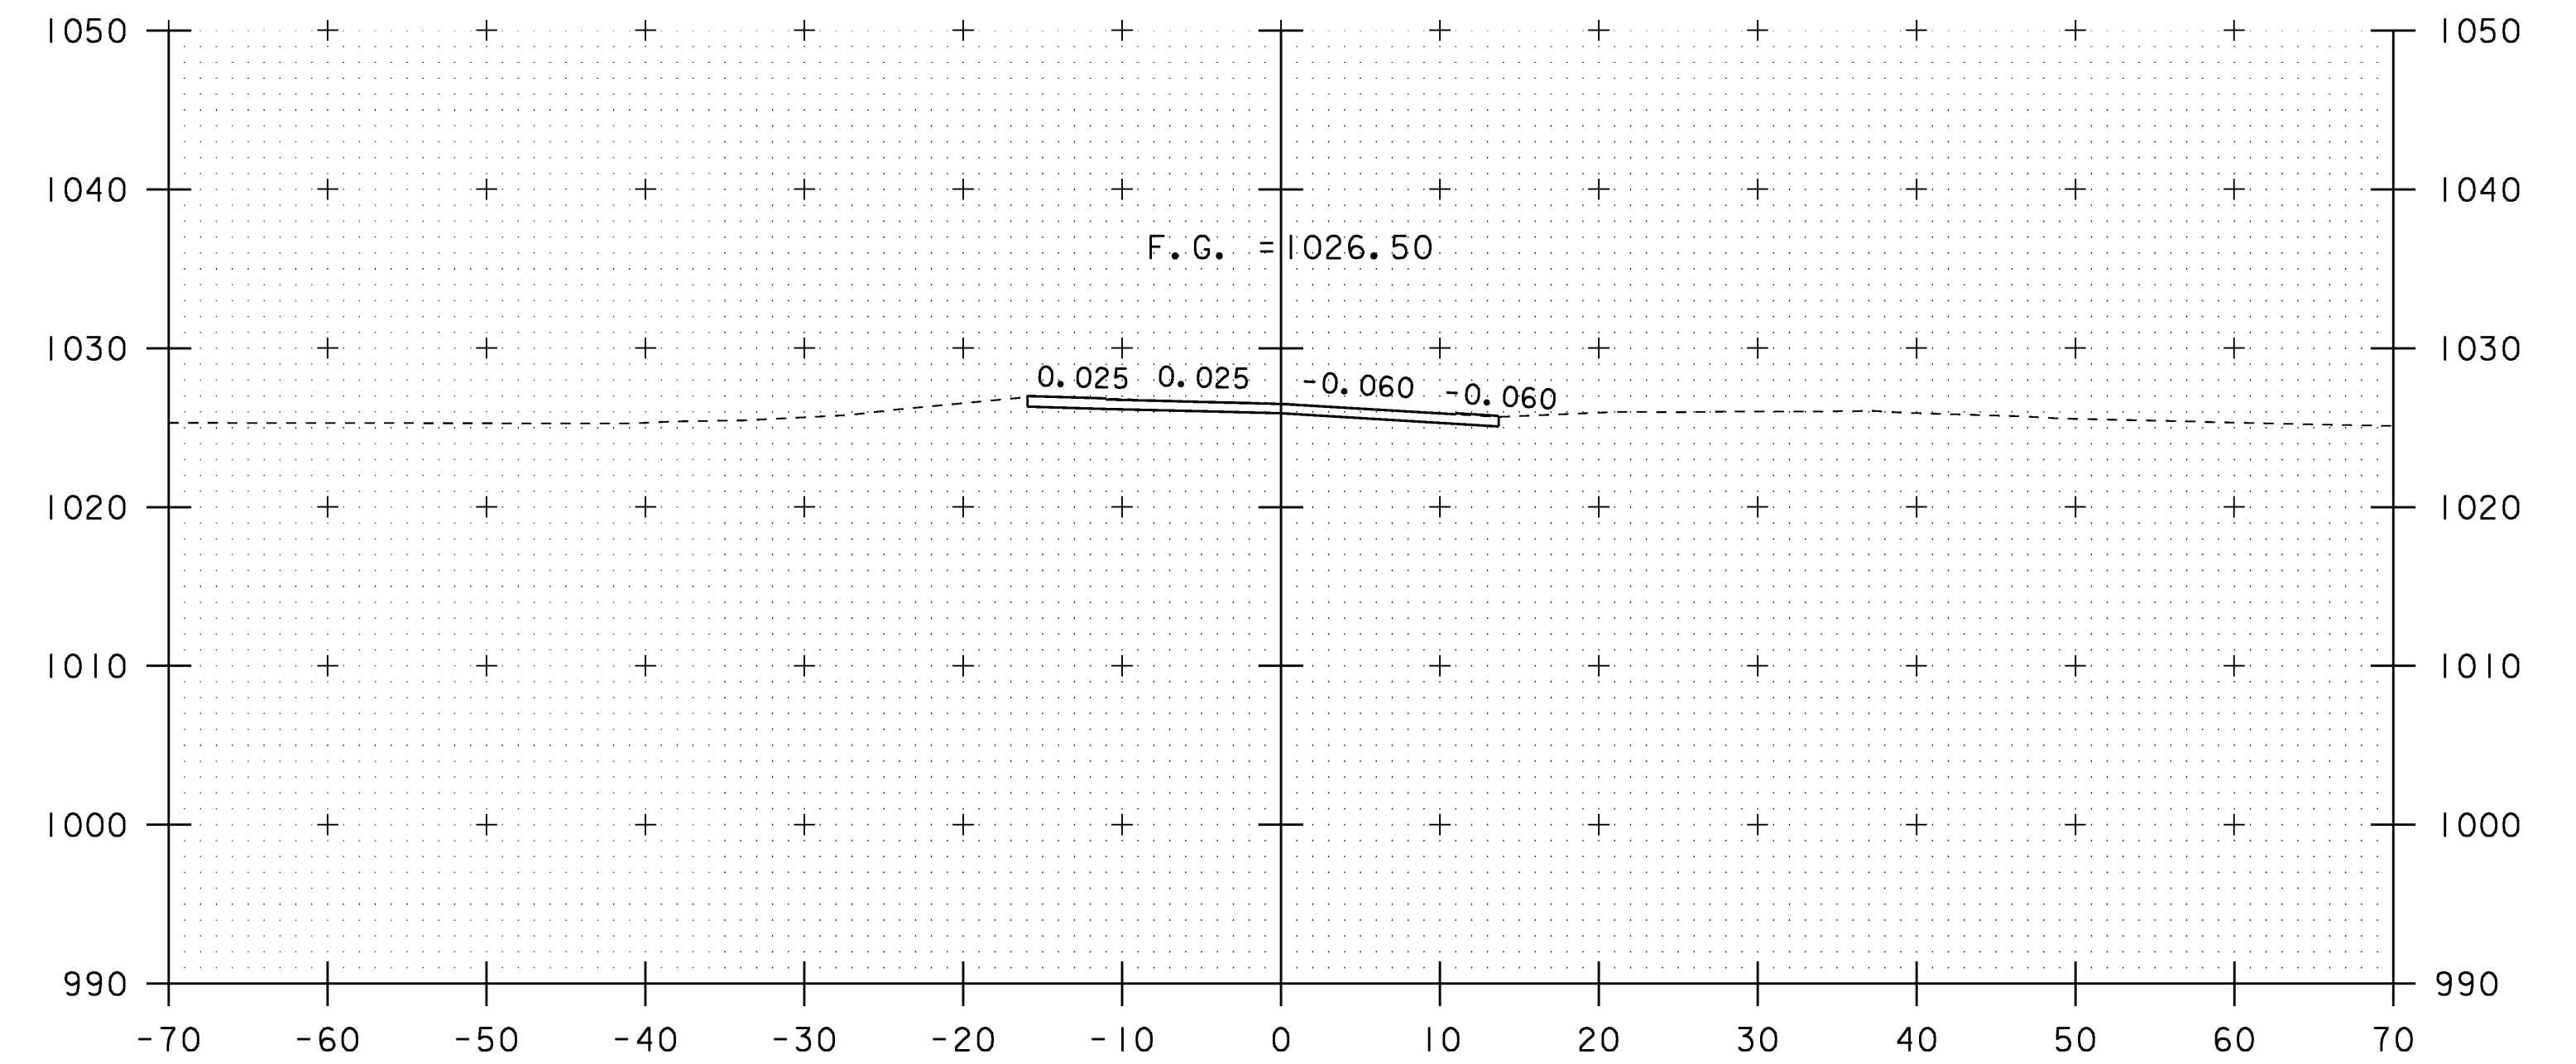

58+00

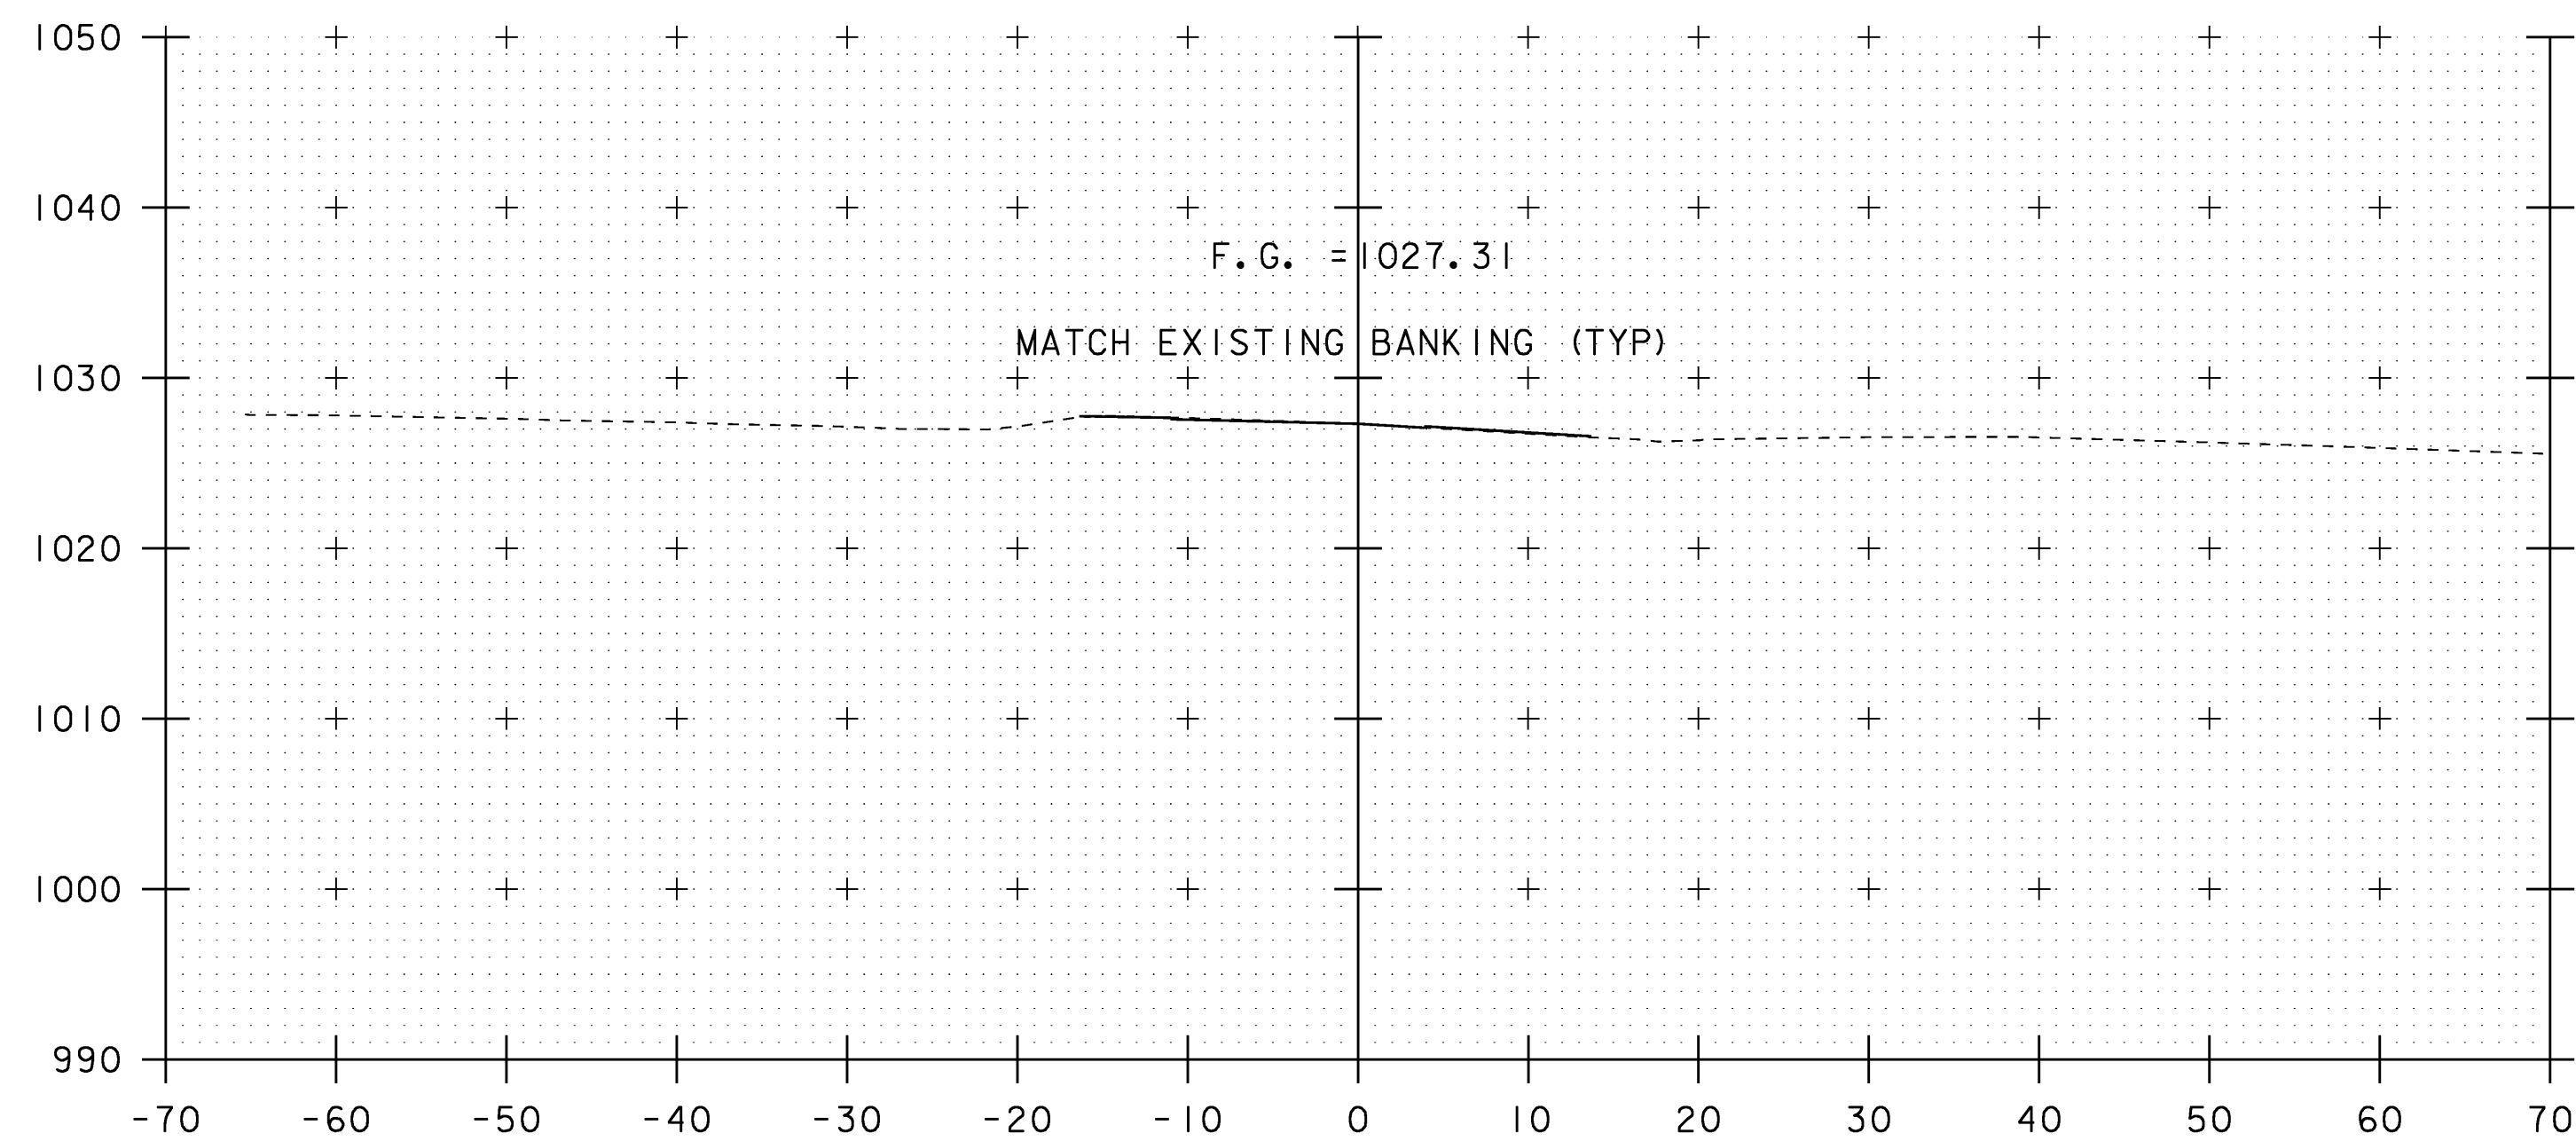


57+50

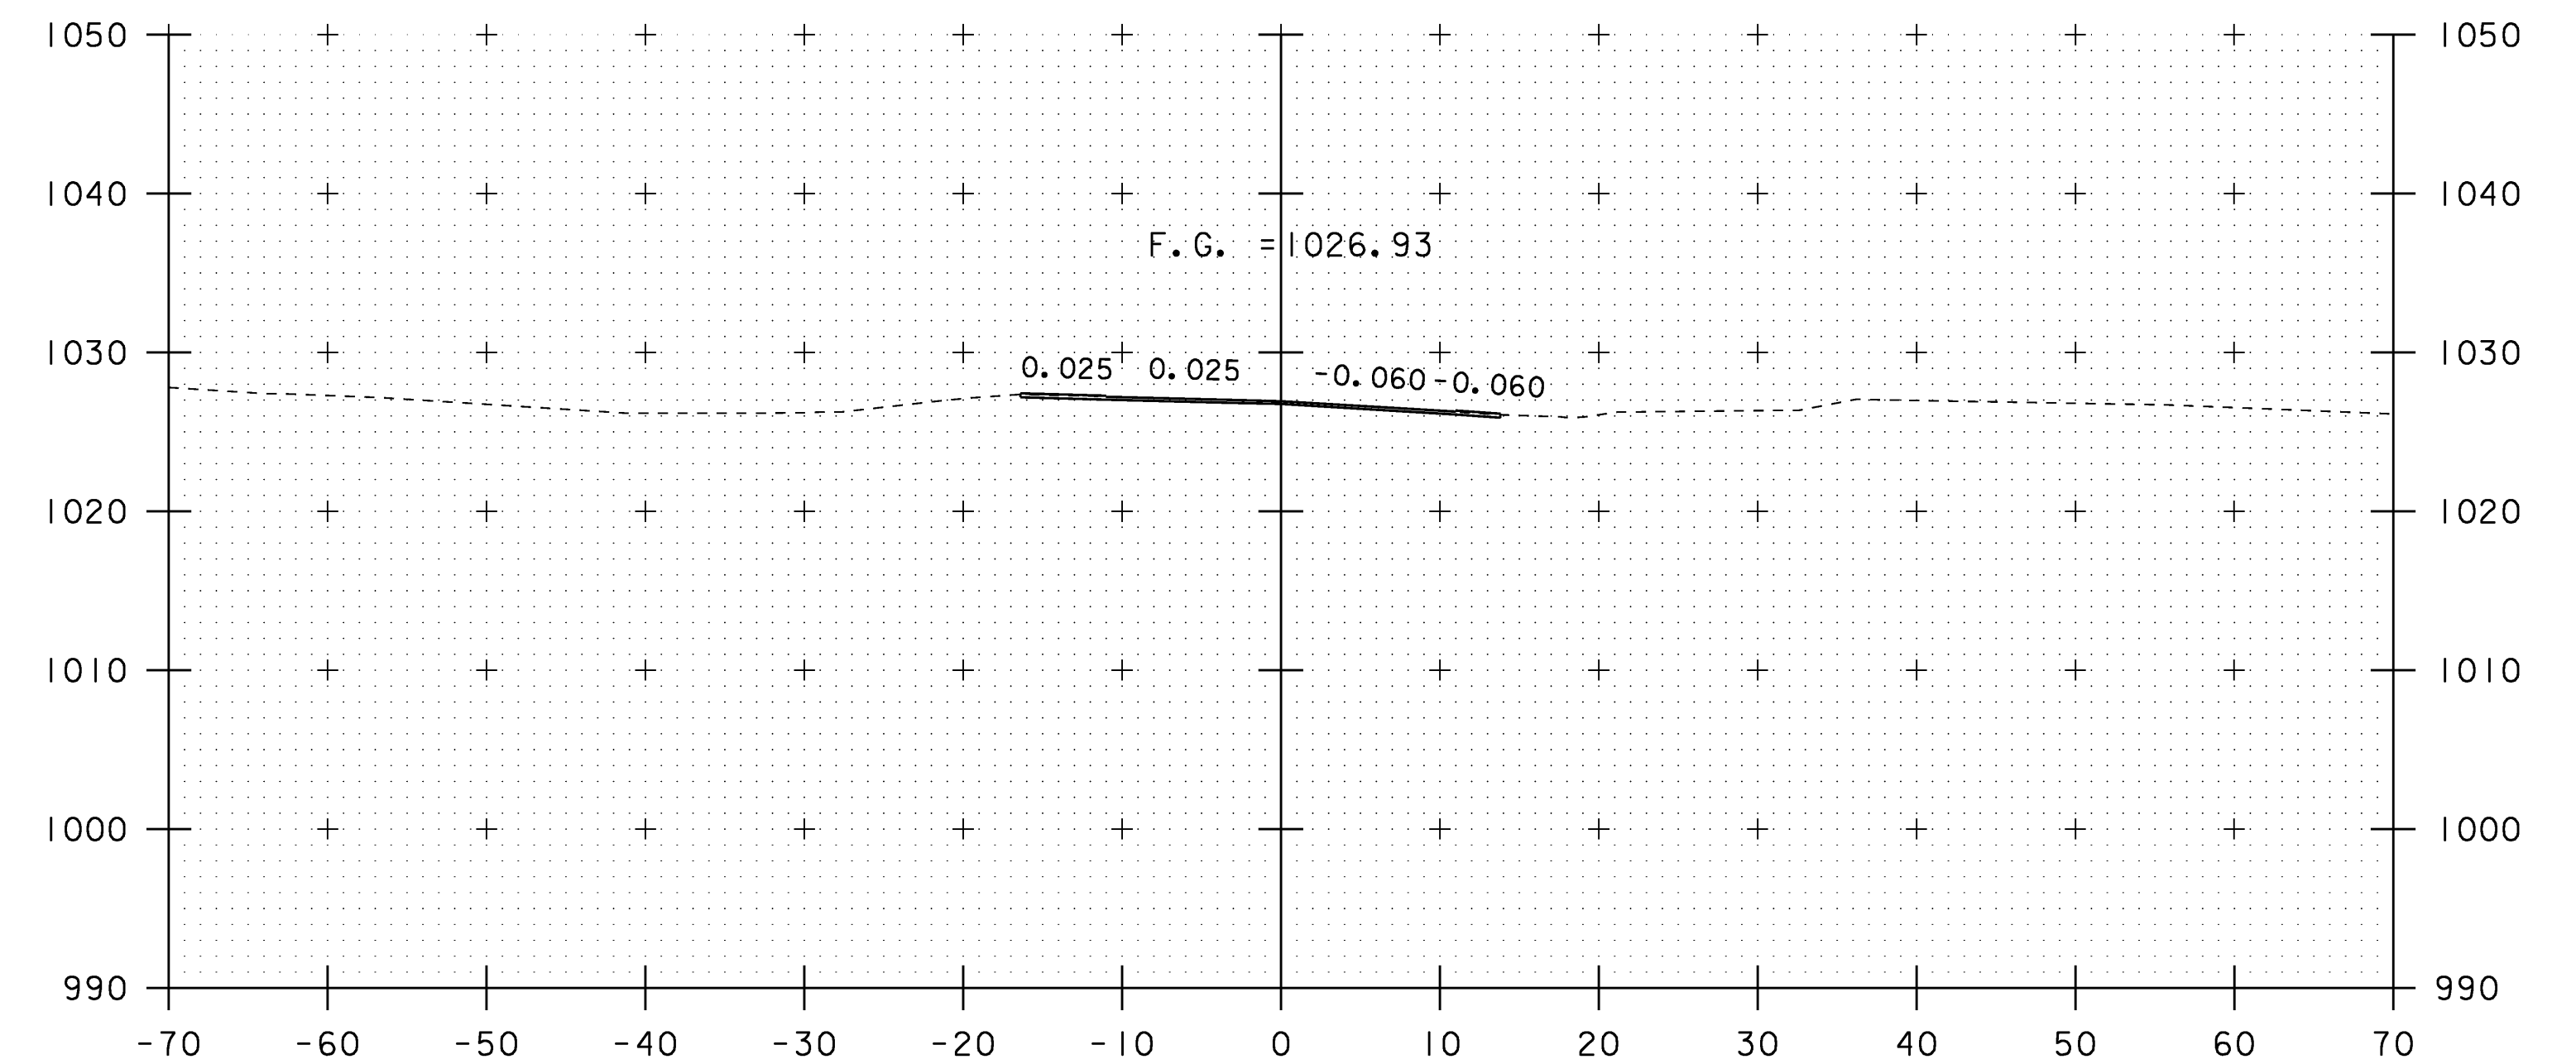

57+75

STA. 57+50  
BEGIN APPROACH  
MATCH EXISTING GRADE AND BANKING

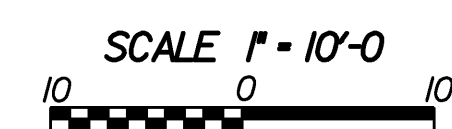

**VT 102 CROSS SECTIONS (1)**

PROJECT NAME:	CANAAN	FILE NAME:	/str2/04c098/x04c098xs.dgn	PLOT DATE:	18-AUG-2008
PROJECT NUMBER:	ER ST 0271(16)	PROJECT LEADER:	EVANS-MONGEON	DRAWN BY:	HUSK
		DESIGNED BY:	SCRIBNER	CHECKED BY:	SCRIBNER
		x04c098r.xsl		SHEET 52	OF 66