




59+25

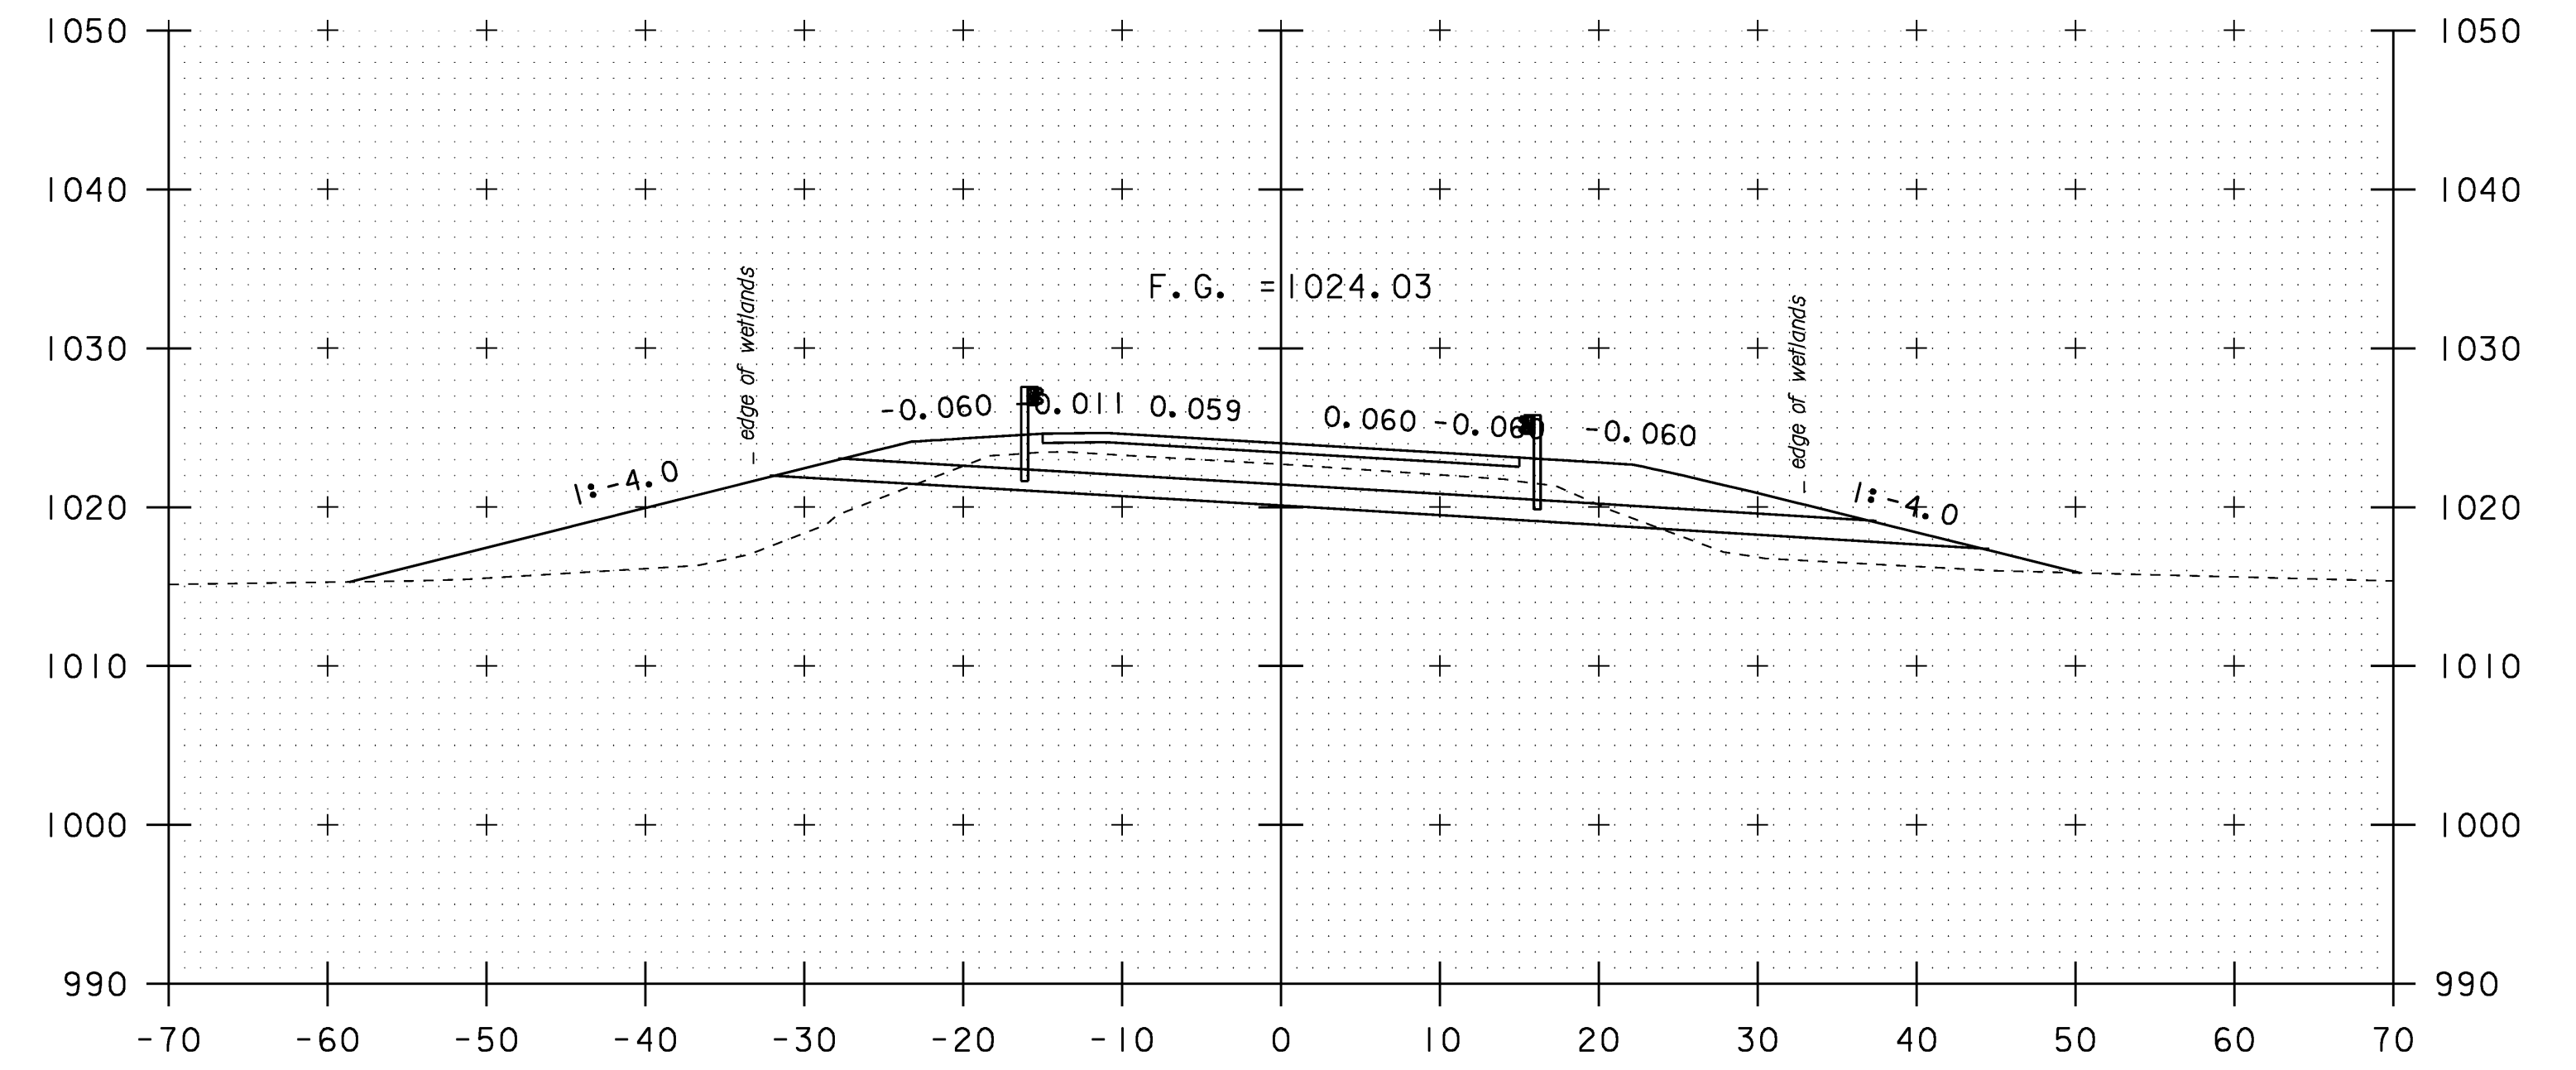

59+75

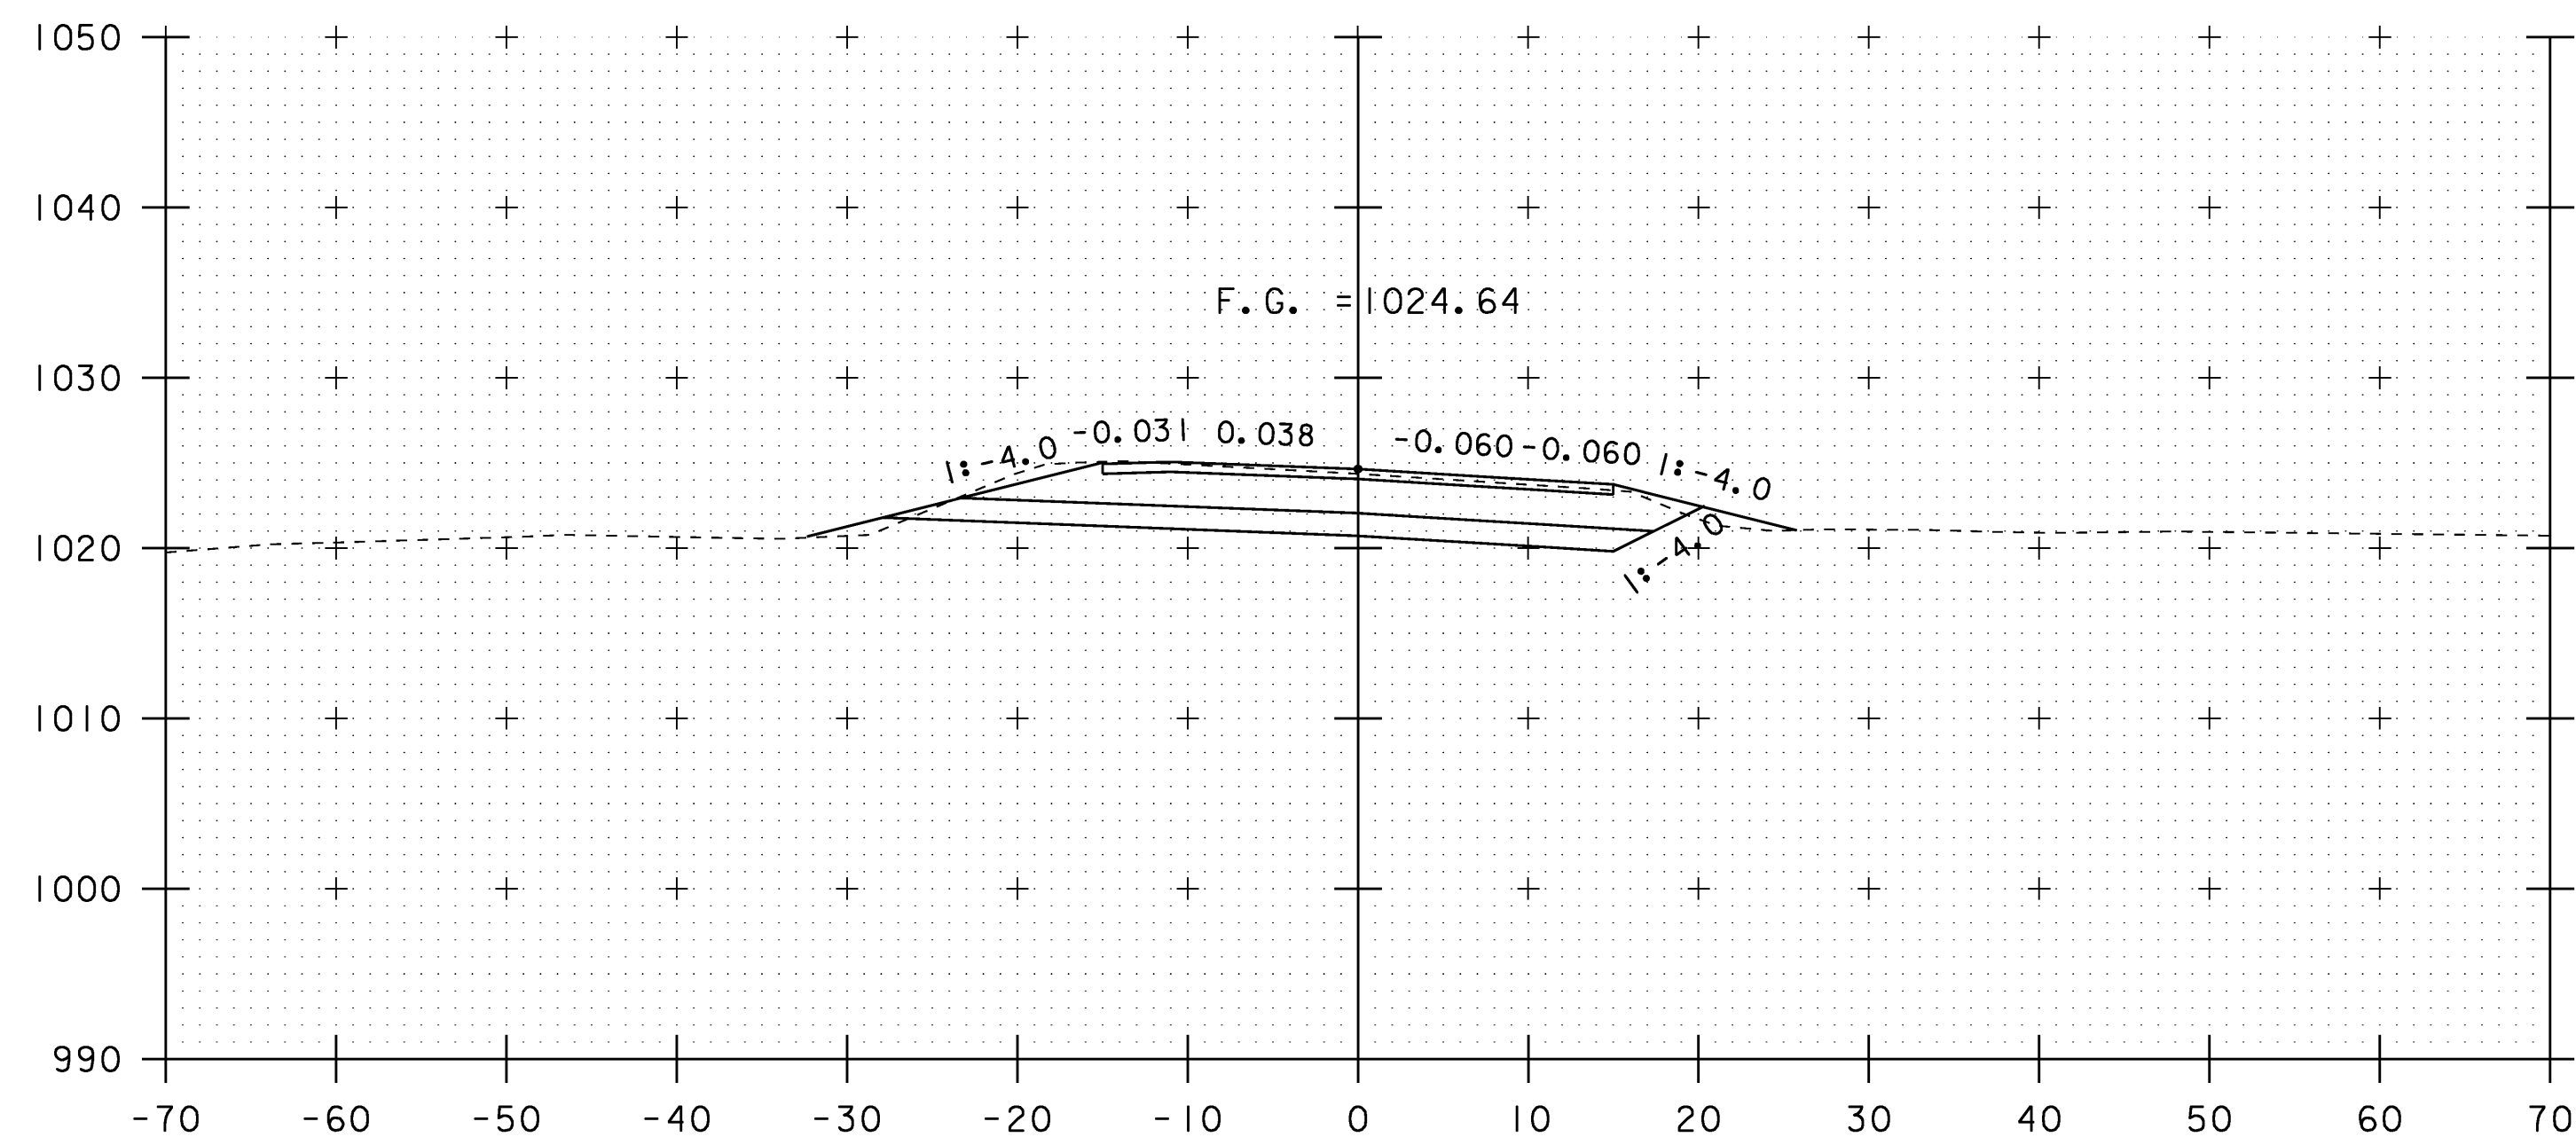

59+00

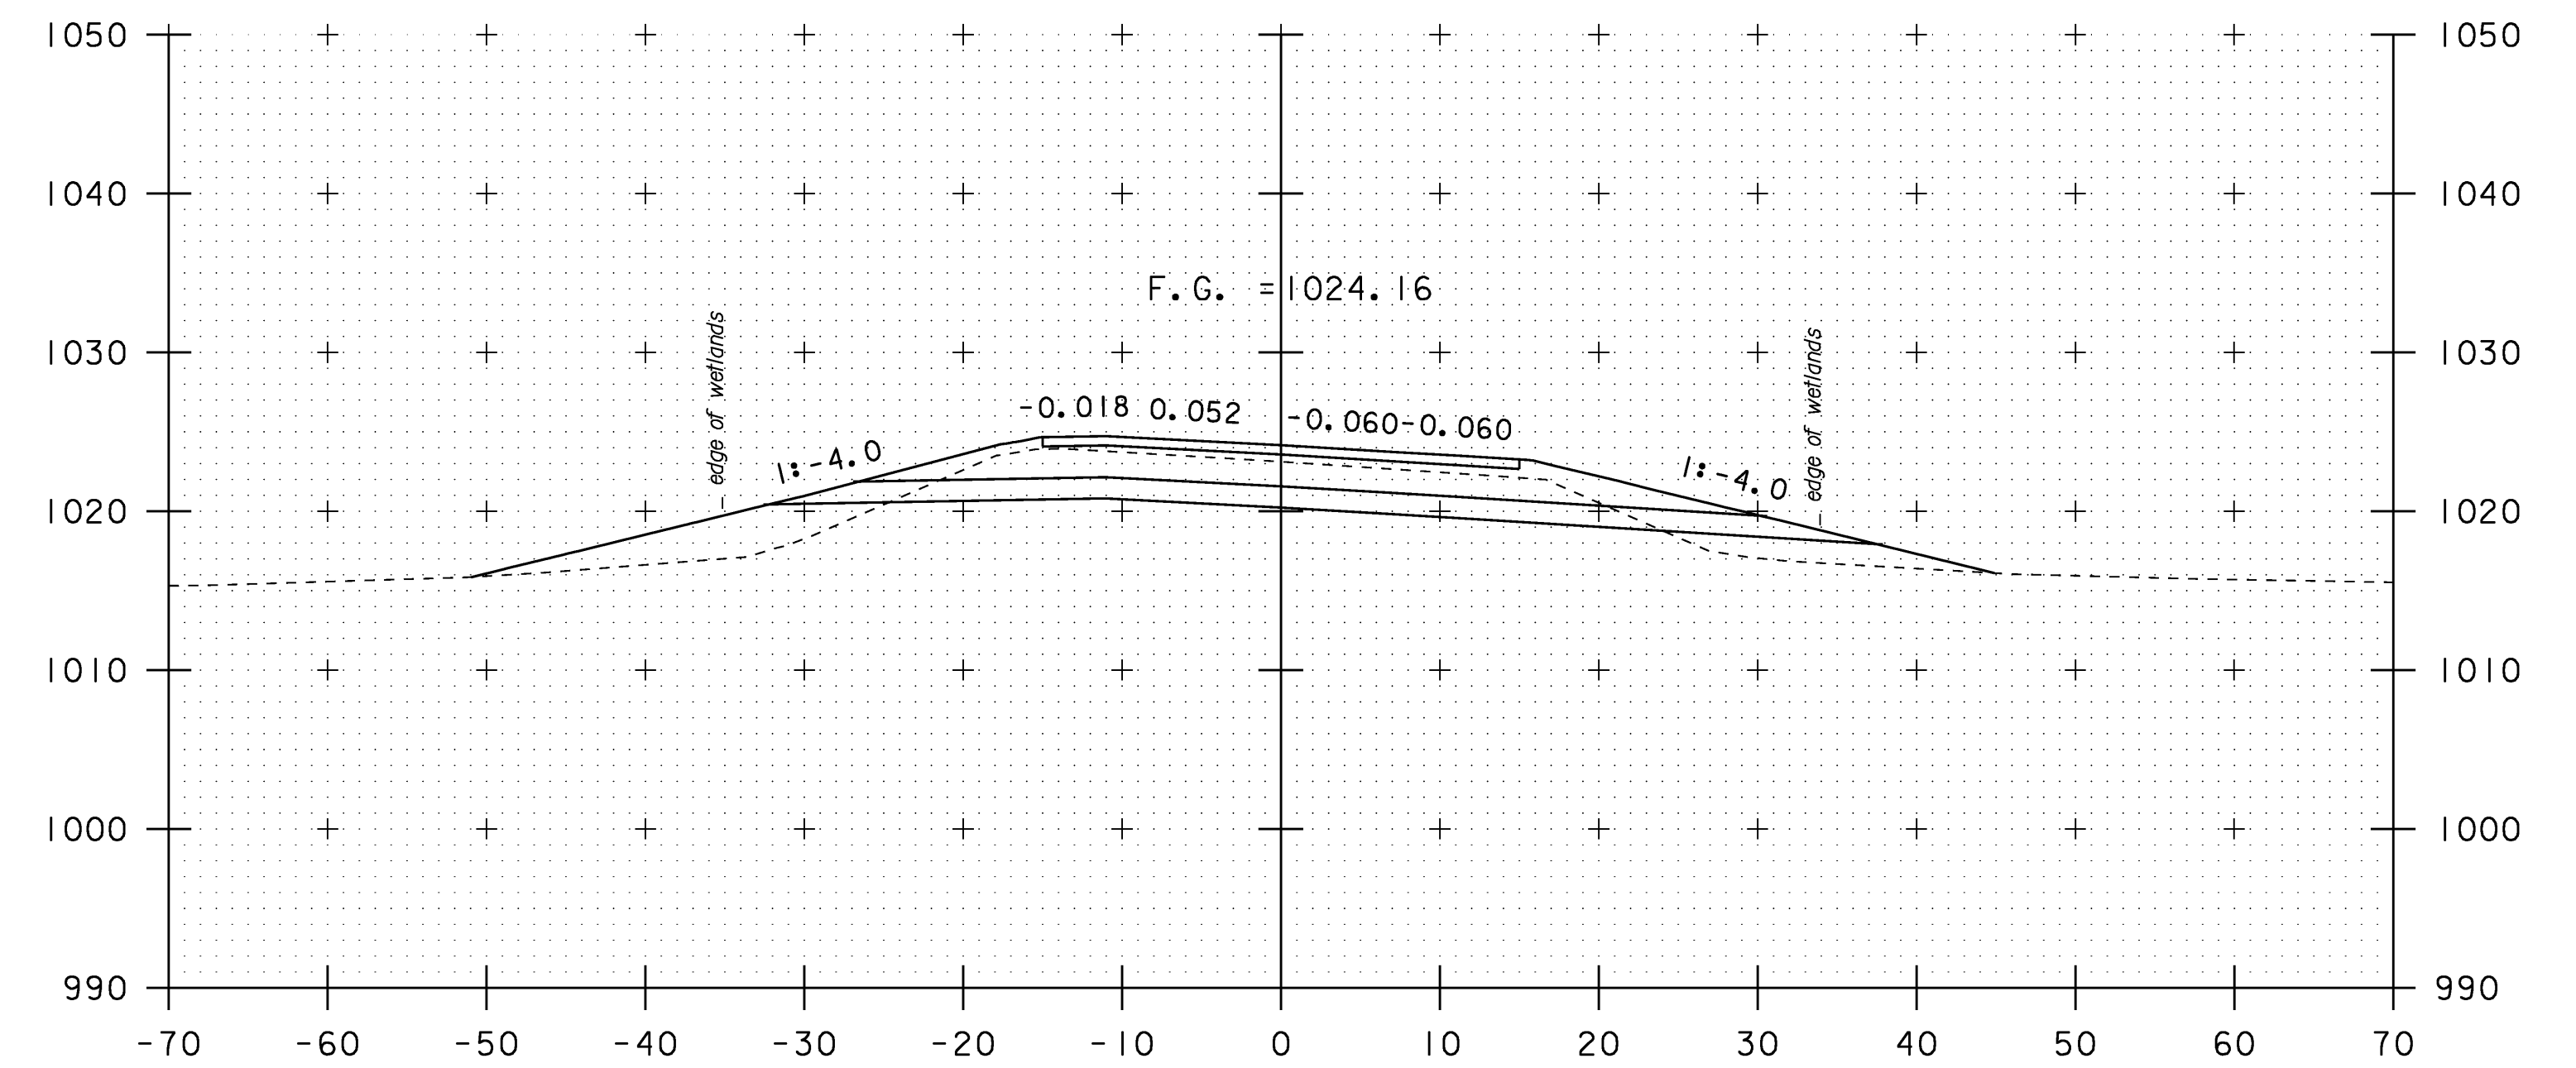

59+50

SCALE 1" = 10'-0"

VT 102 CROSS SECTIONS (3)

PROJECT NAME:	CANAAN		
PROJECT NUMBER:	ER ST 0271(16)		
FILE NAME:	/str2/04c098/x04c098bdr.dgn	PLOT DATE:	18-AUG-2008
PROJECT LEADER:	EVANS-MONGEON	DRAWN BY:	HUSK
DESIGNED BY:	SCRIBNER	CHECKED BY:	SCRIBNER
x04c098rxs3.1		SHEET 54	OF 66