




63+00

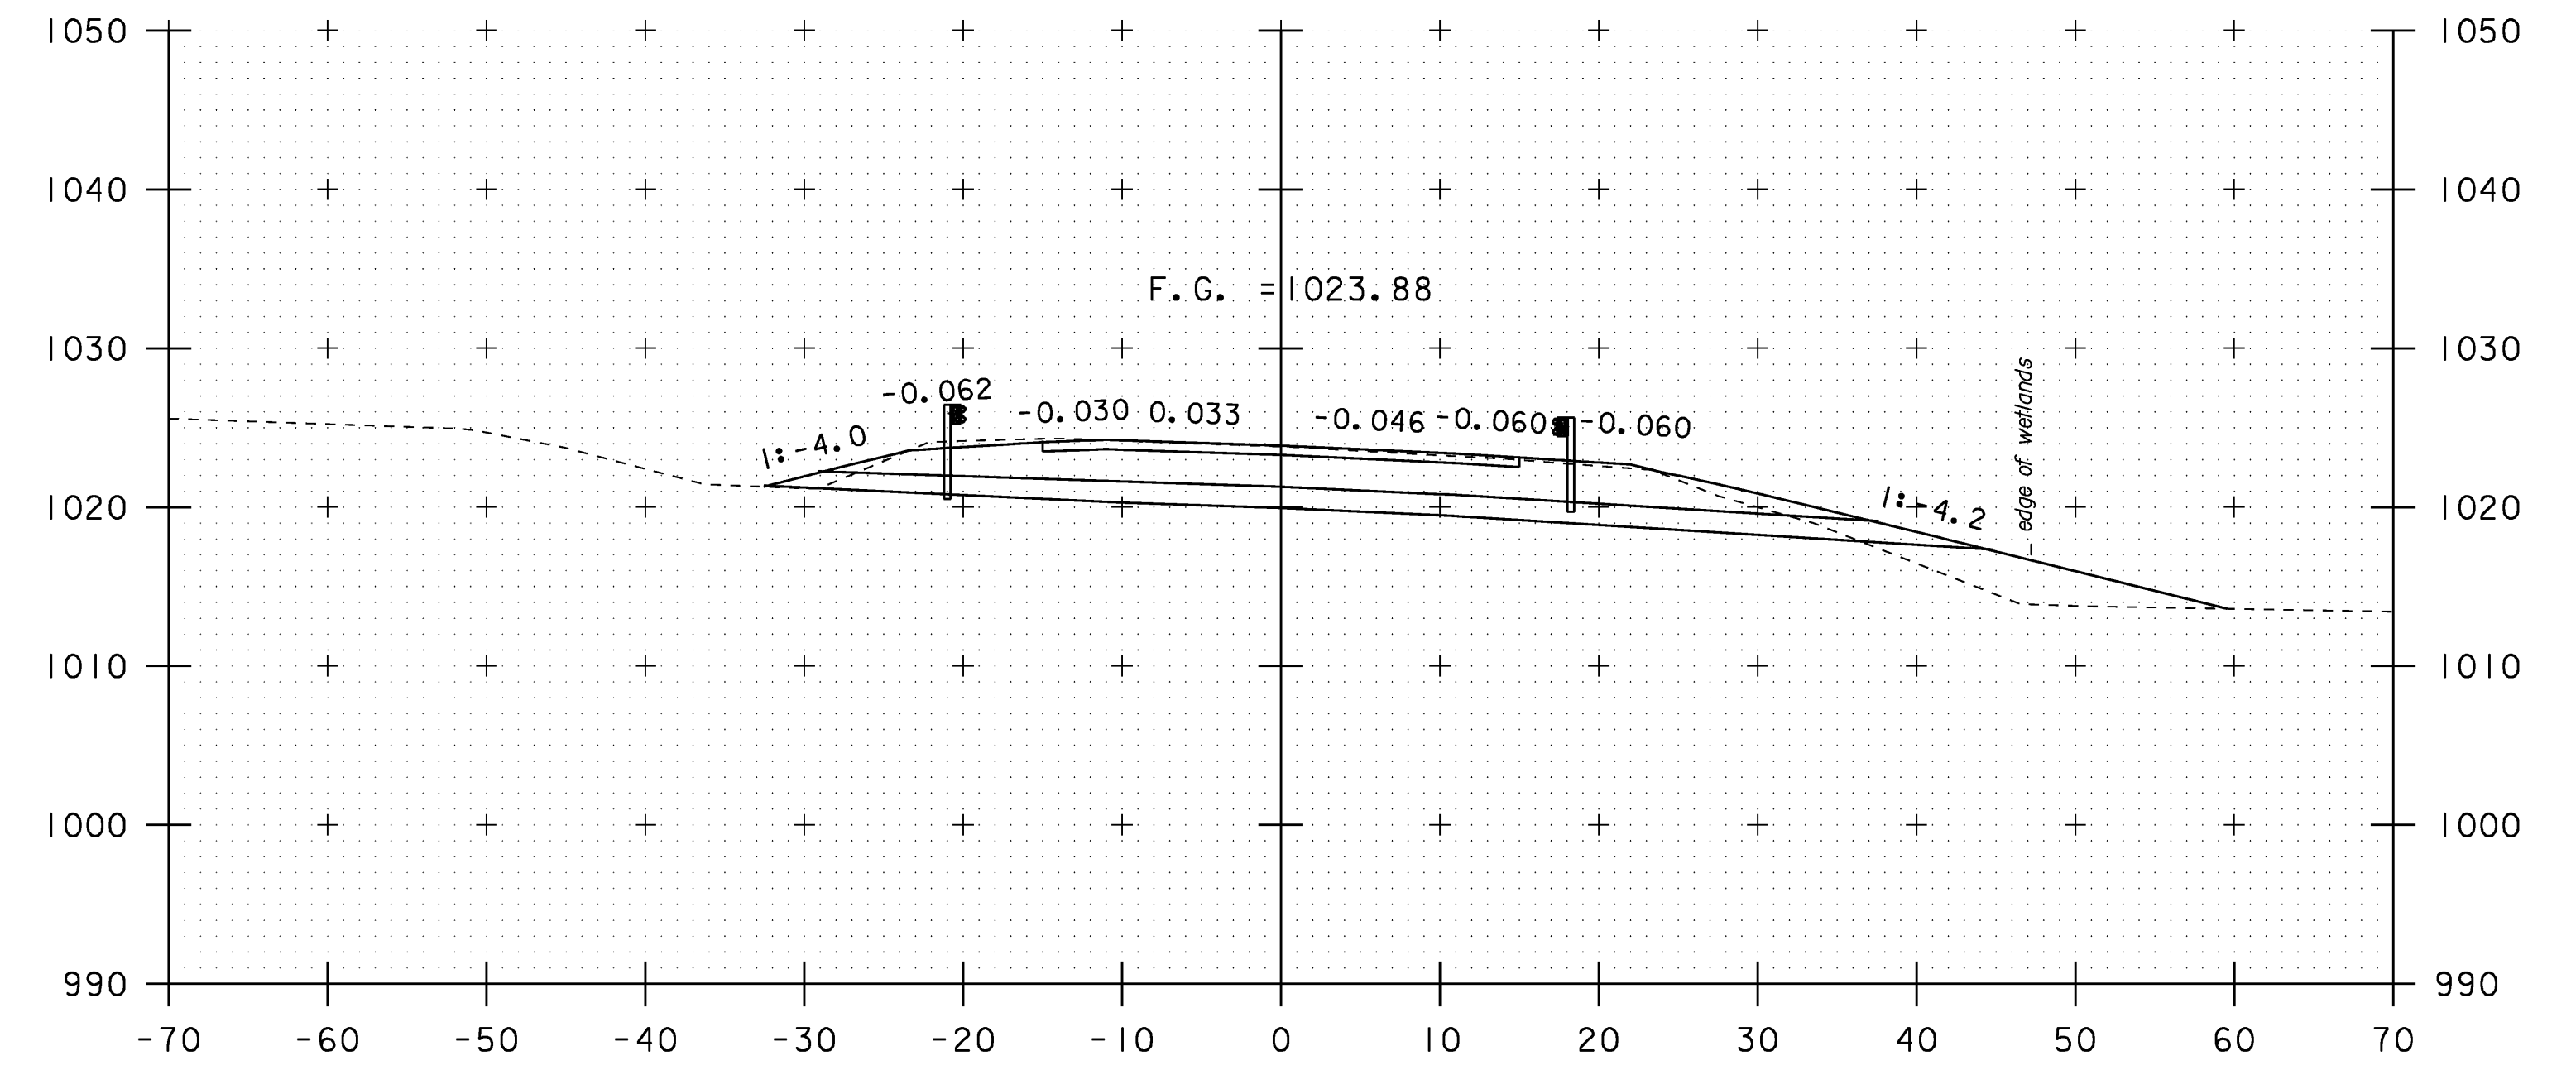

63+42

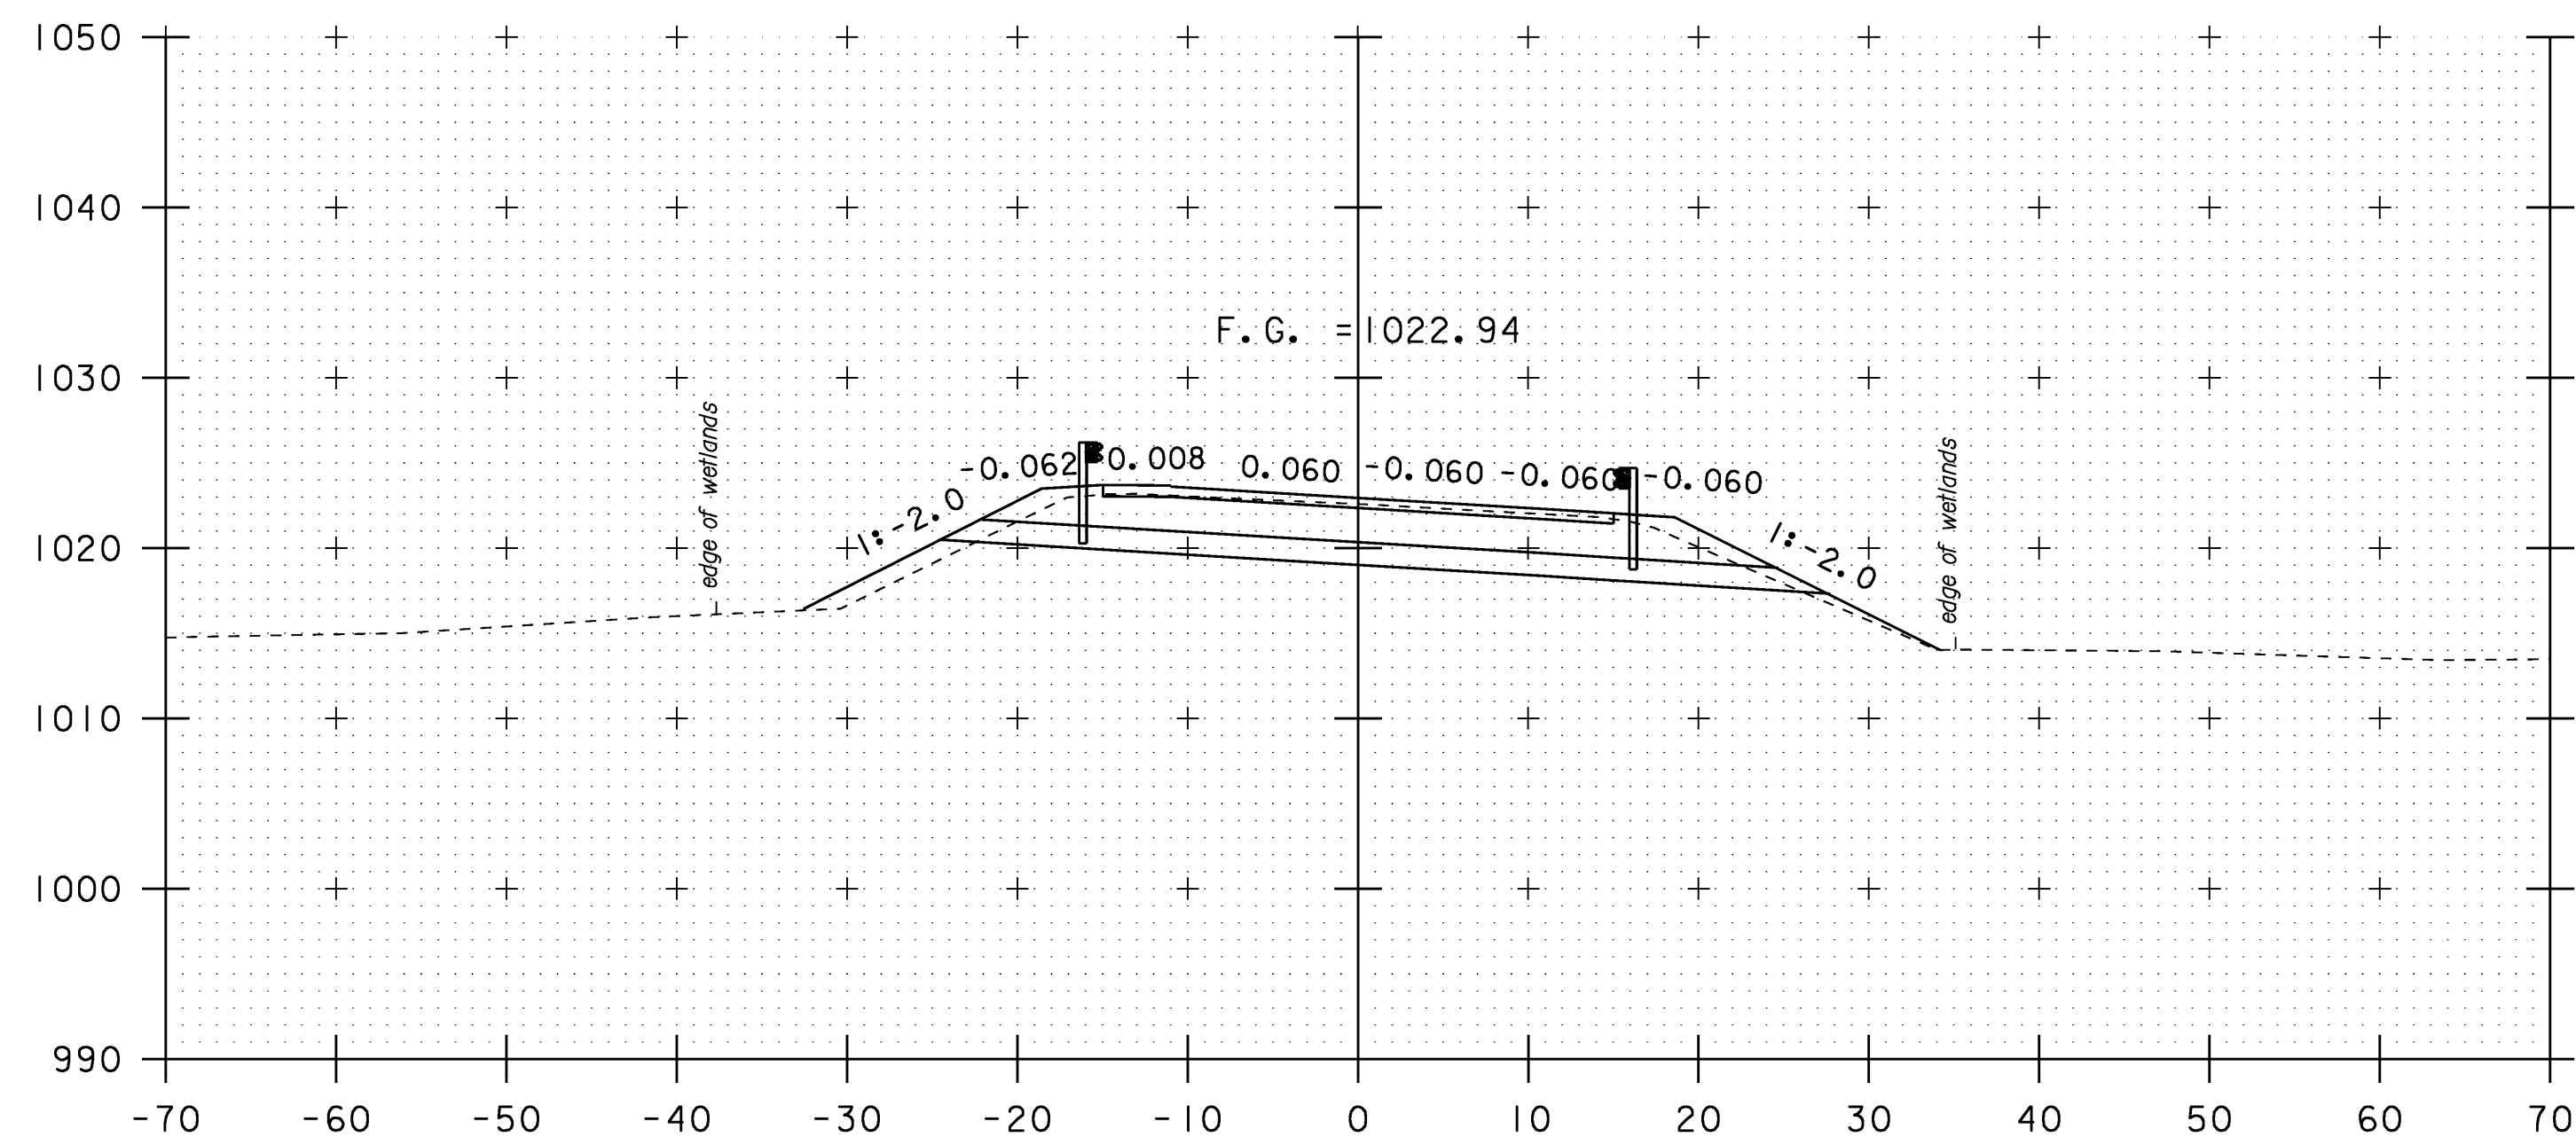

62+75

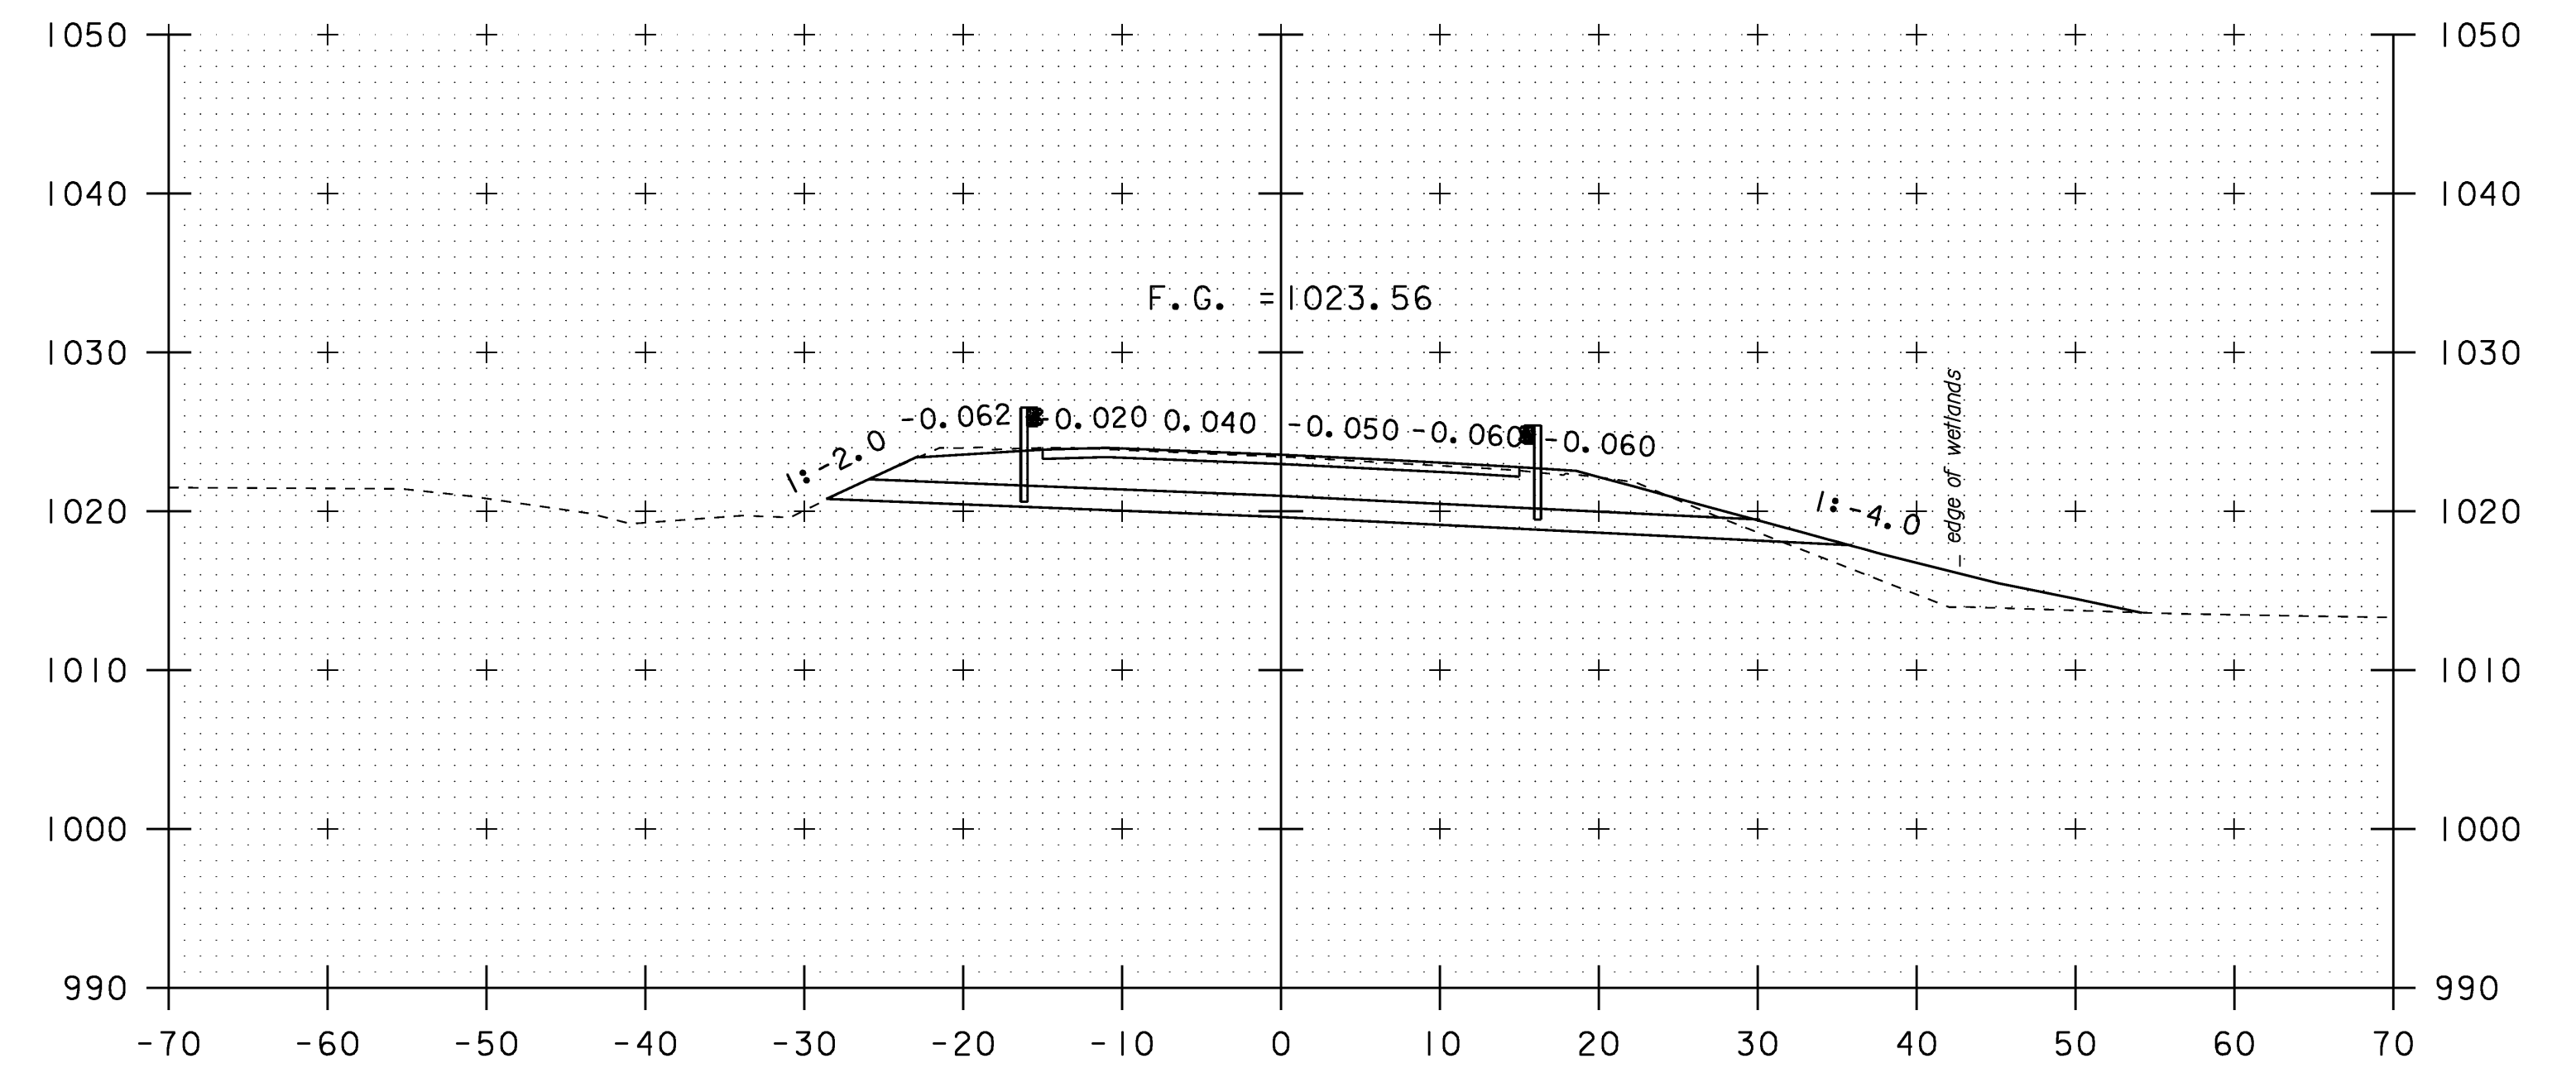

63+25

SCALE 1" = 10'-0"

**VT 102 CROSS SECTIONS (7)**

PROJECT NAME:	CANAAN		
PROJECT NUMBER:	ER ST 0271 (16)		
FILE NAME:	/str2/04c098/x04c098bdr.dgn	PLOT DATE:	18-AUG-2008
PROJECT LEADER:	EVANS-MONGEON	DRAWN BY:	HUSK
DESIGNED BY:	SCRIBNER	CHECKED BY:	SCRIBNER
x04c098rxs7.1		SHEET 58	OF 66