




64+32

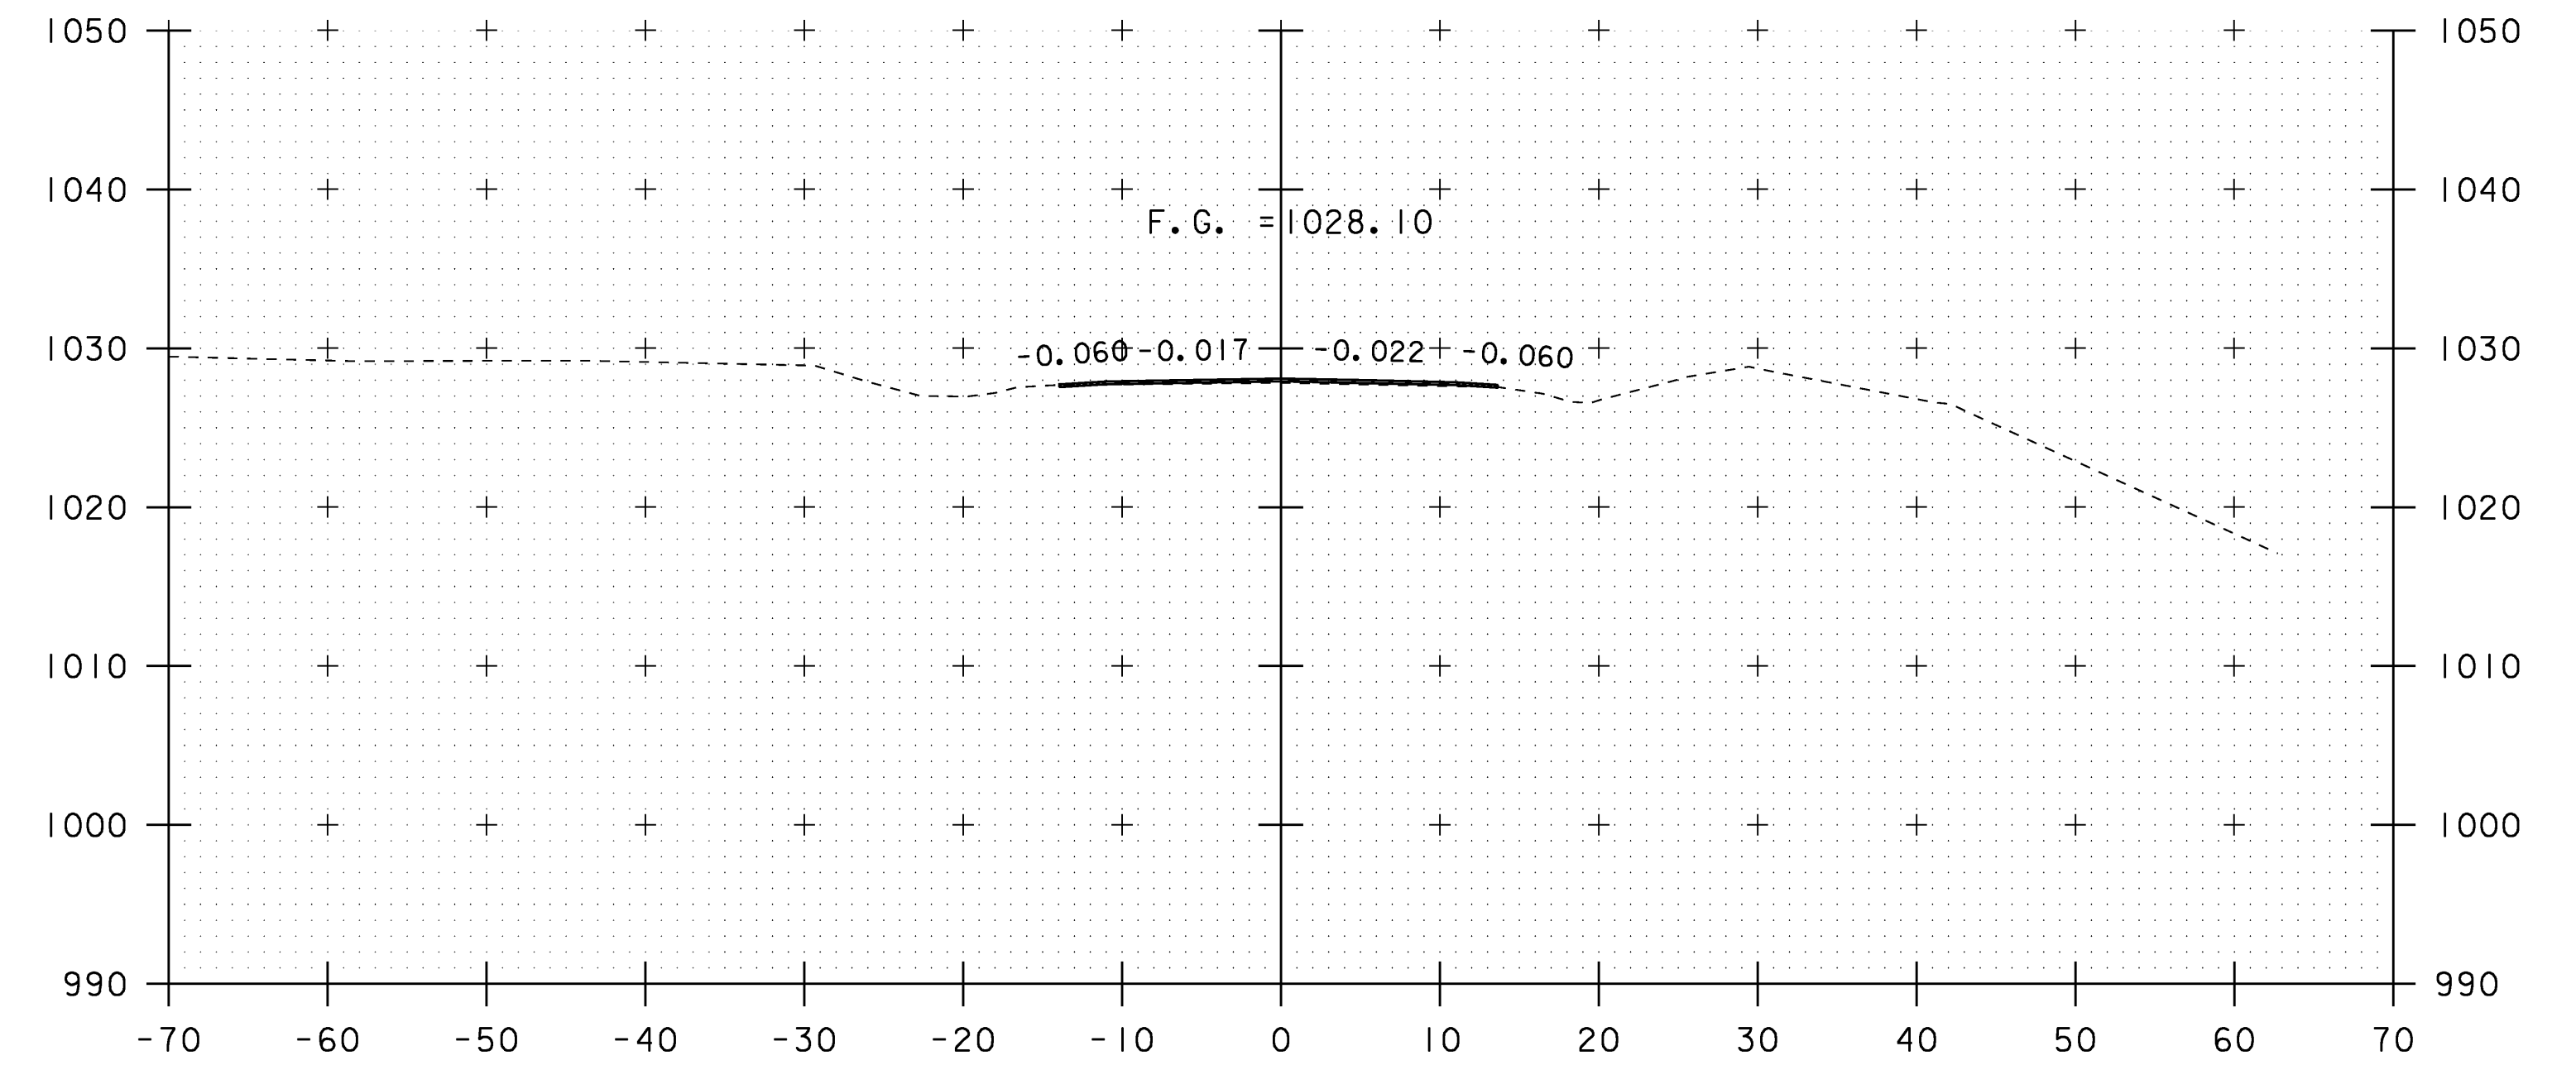


64+75

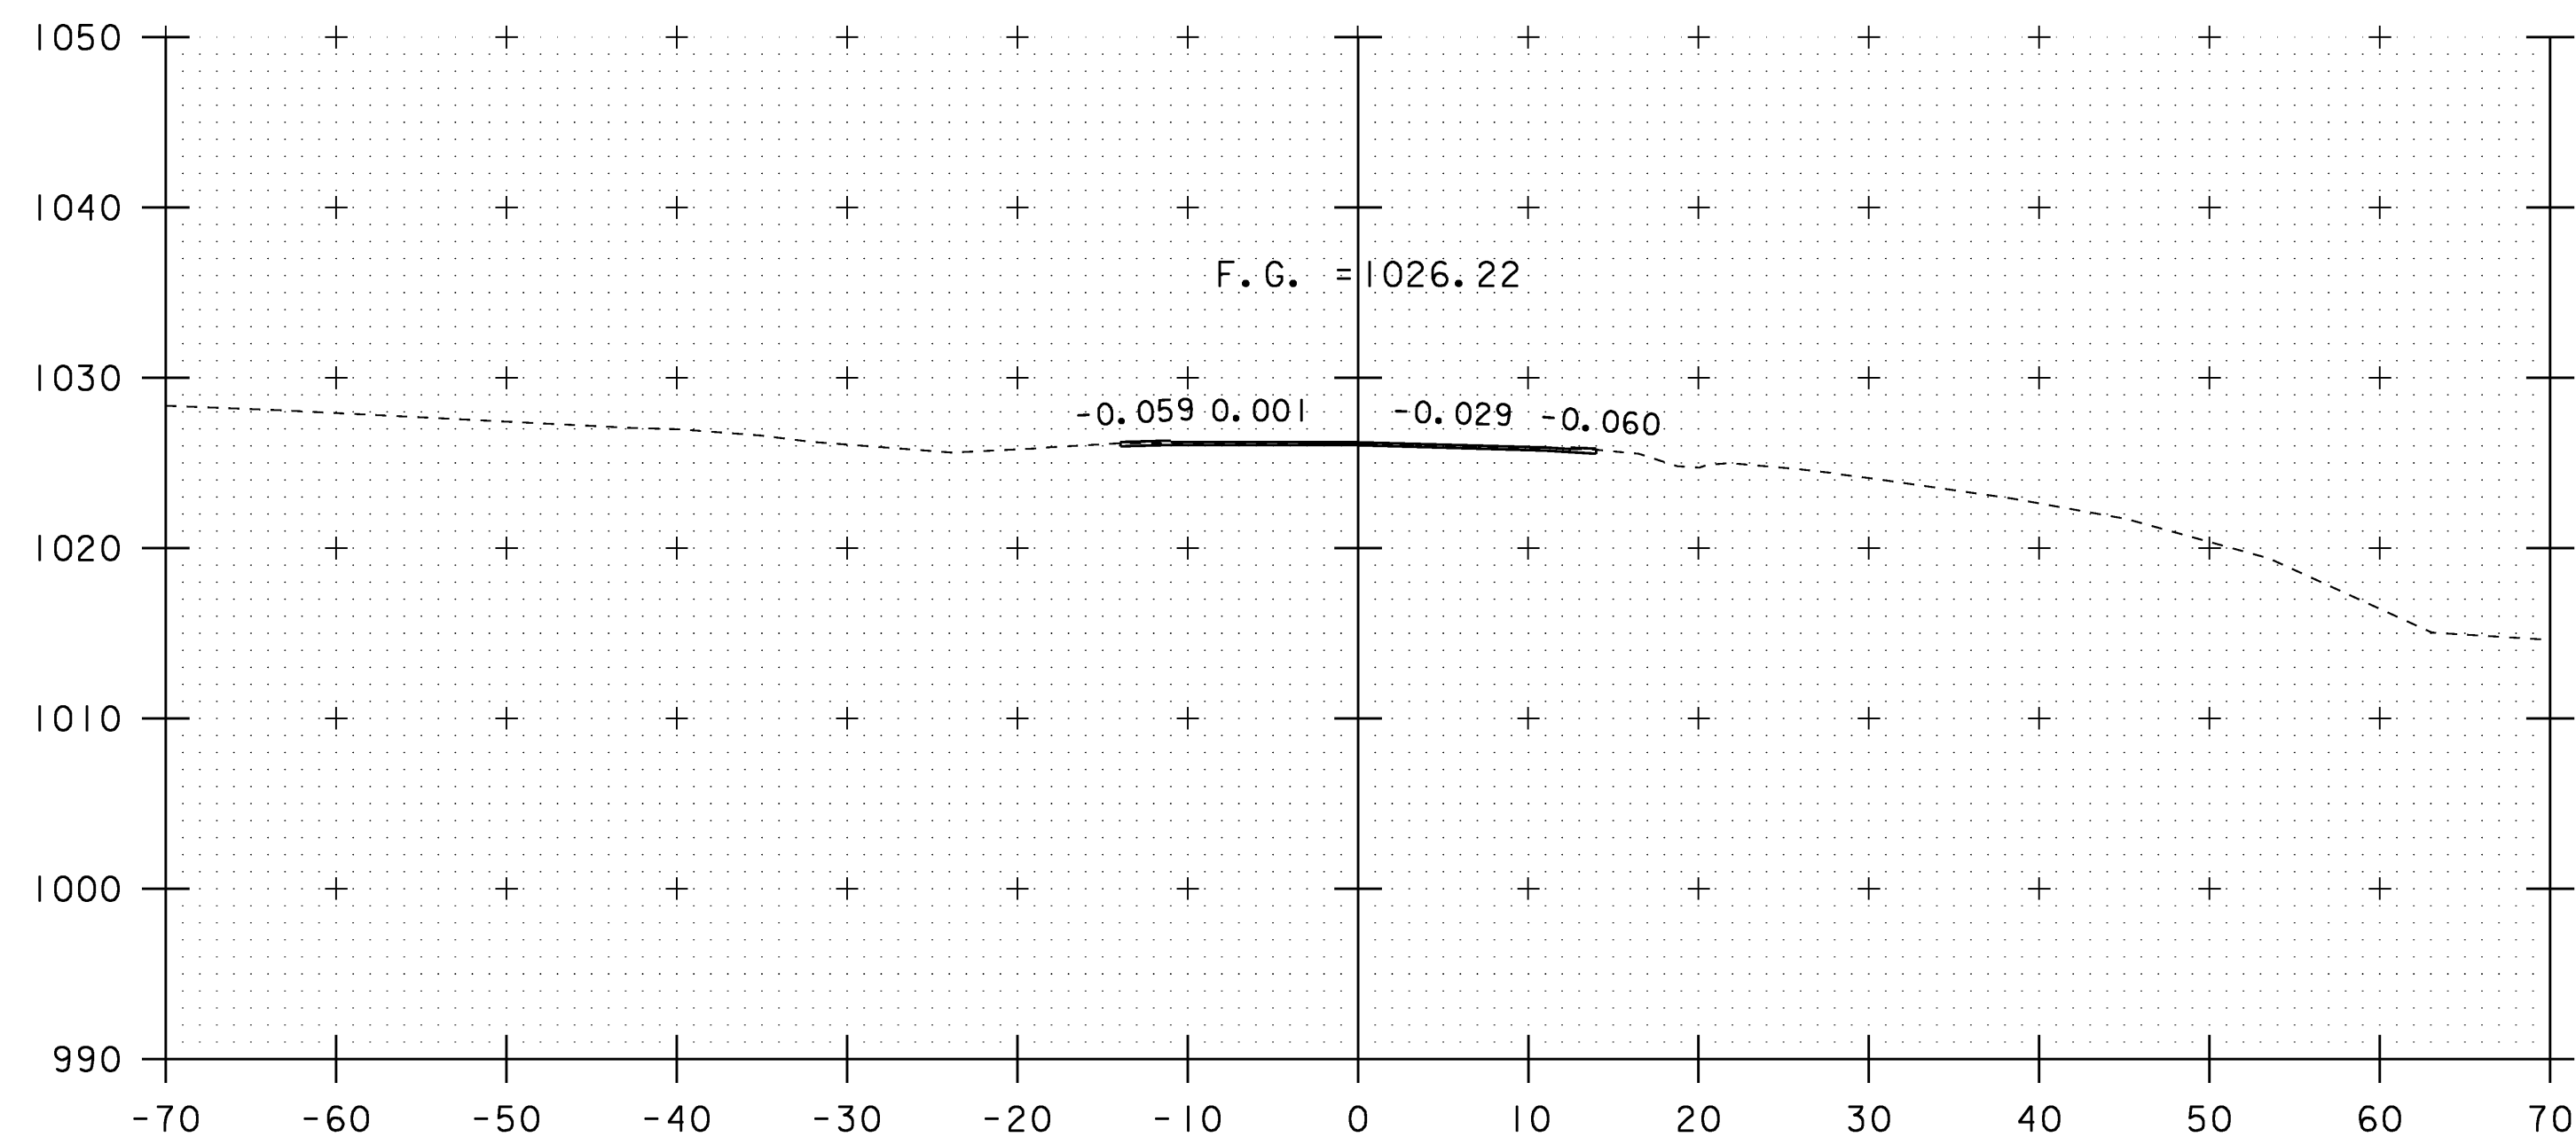

64+25

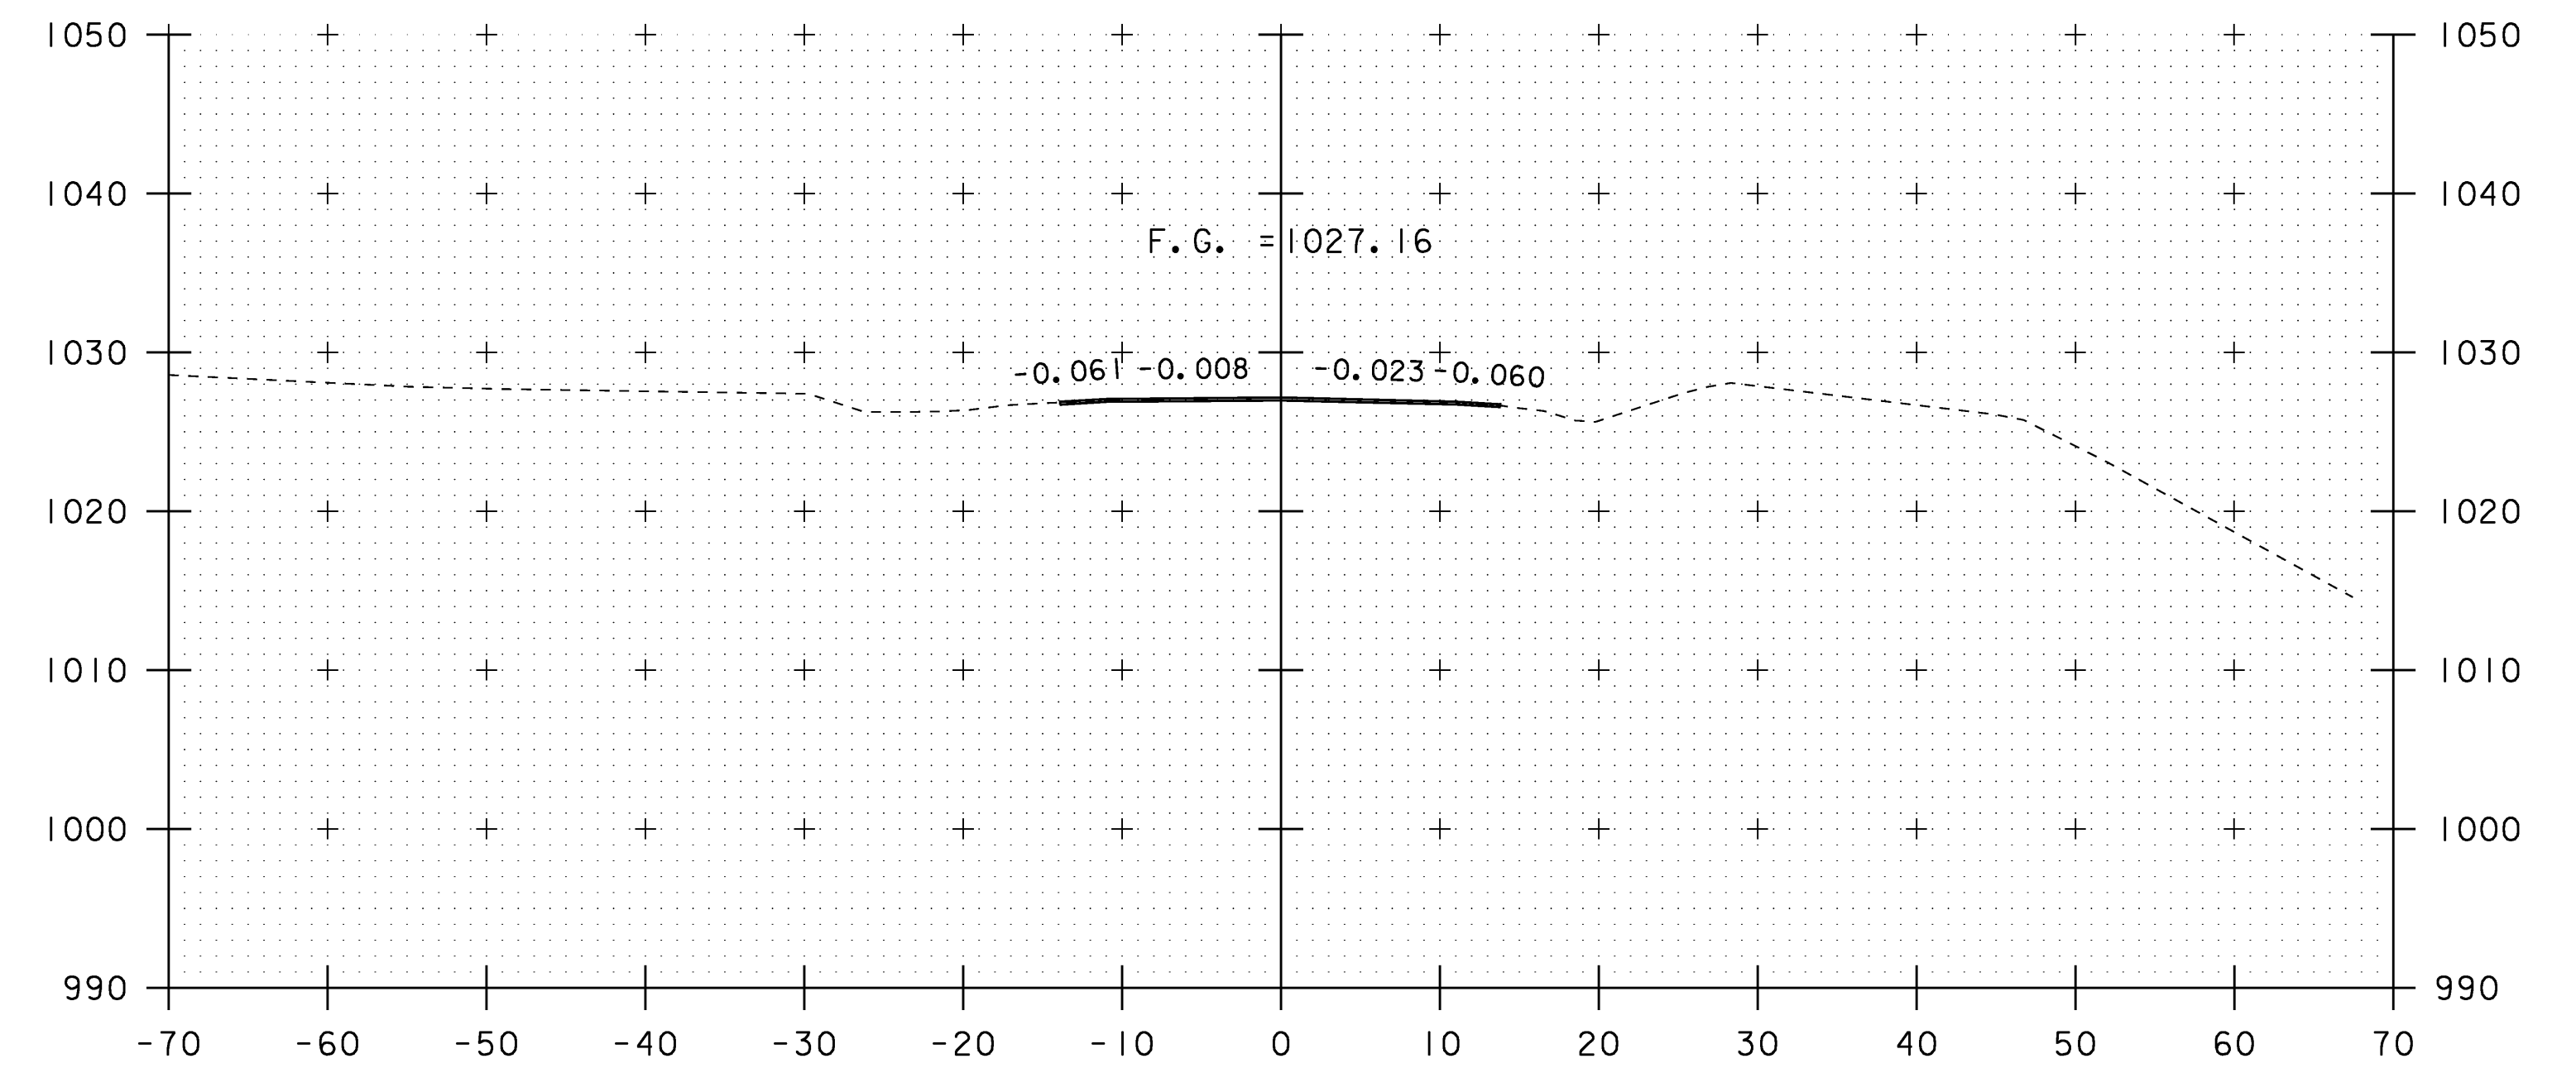

64+50

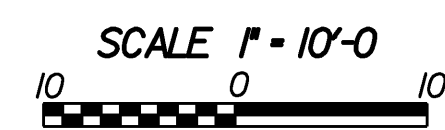

**VT 102 CROSS SECTIONS (9)**

PROJECT NAME:	CANAAN		
PROJECT NUMBER:	ER ST 027I (16)		
FILE NAME:	/str2/04c098/x04c098bdr.dgn	PLOT DATE:	18-AUG-2008
PROJECT LEADER:	EVANS-MONGEON	DRAWN BY:	HUSK
DESIGNED BY:	SCRIBNER	CHECKED BY:	SCRIBNER
x04c098rxs9.1		SHEET	60 OF 66