



STA. 65+15
 END APPROACH
 MATCH EXISTING GRADE AND BANKING

65+15

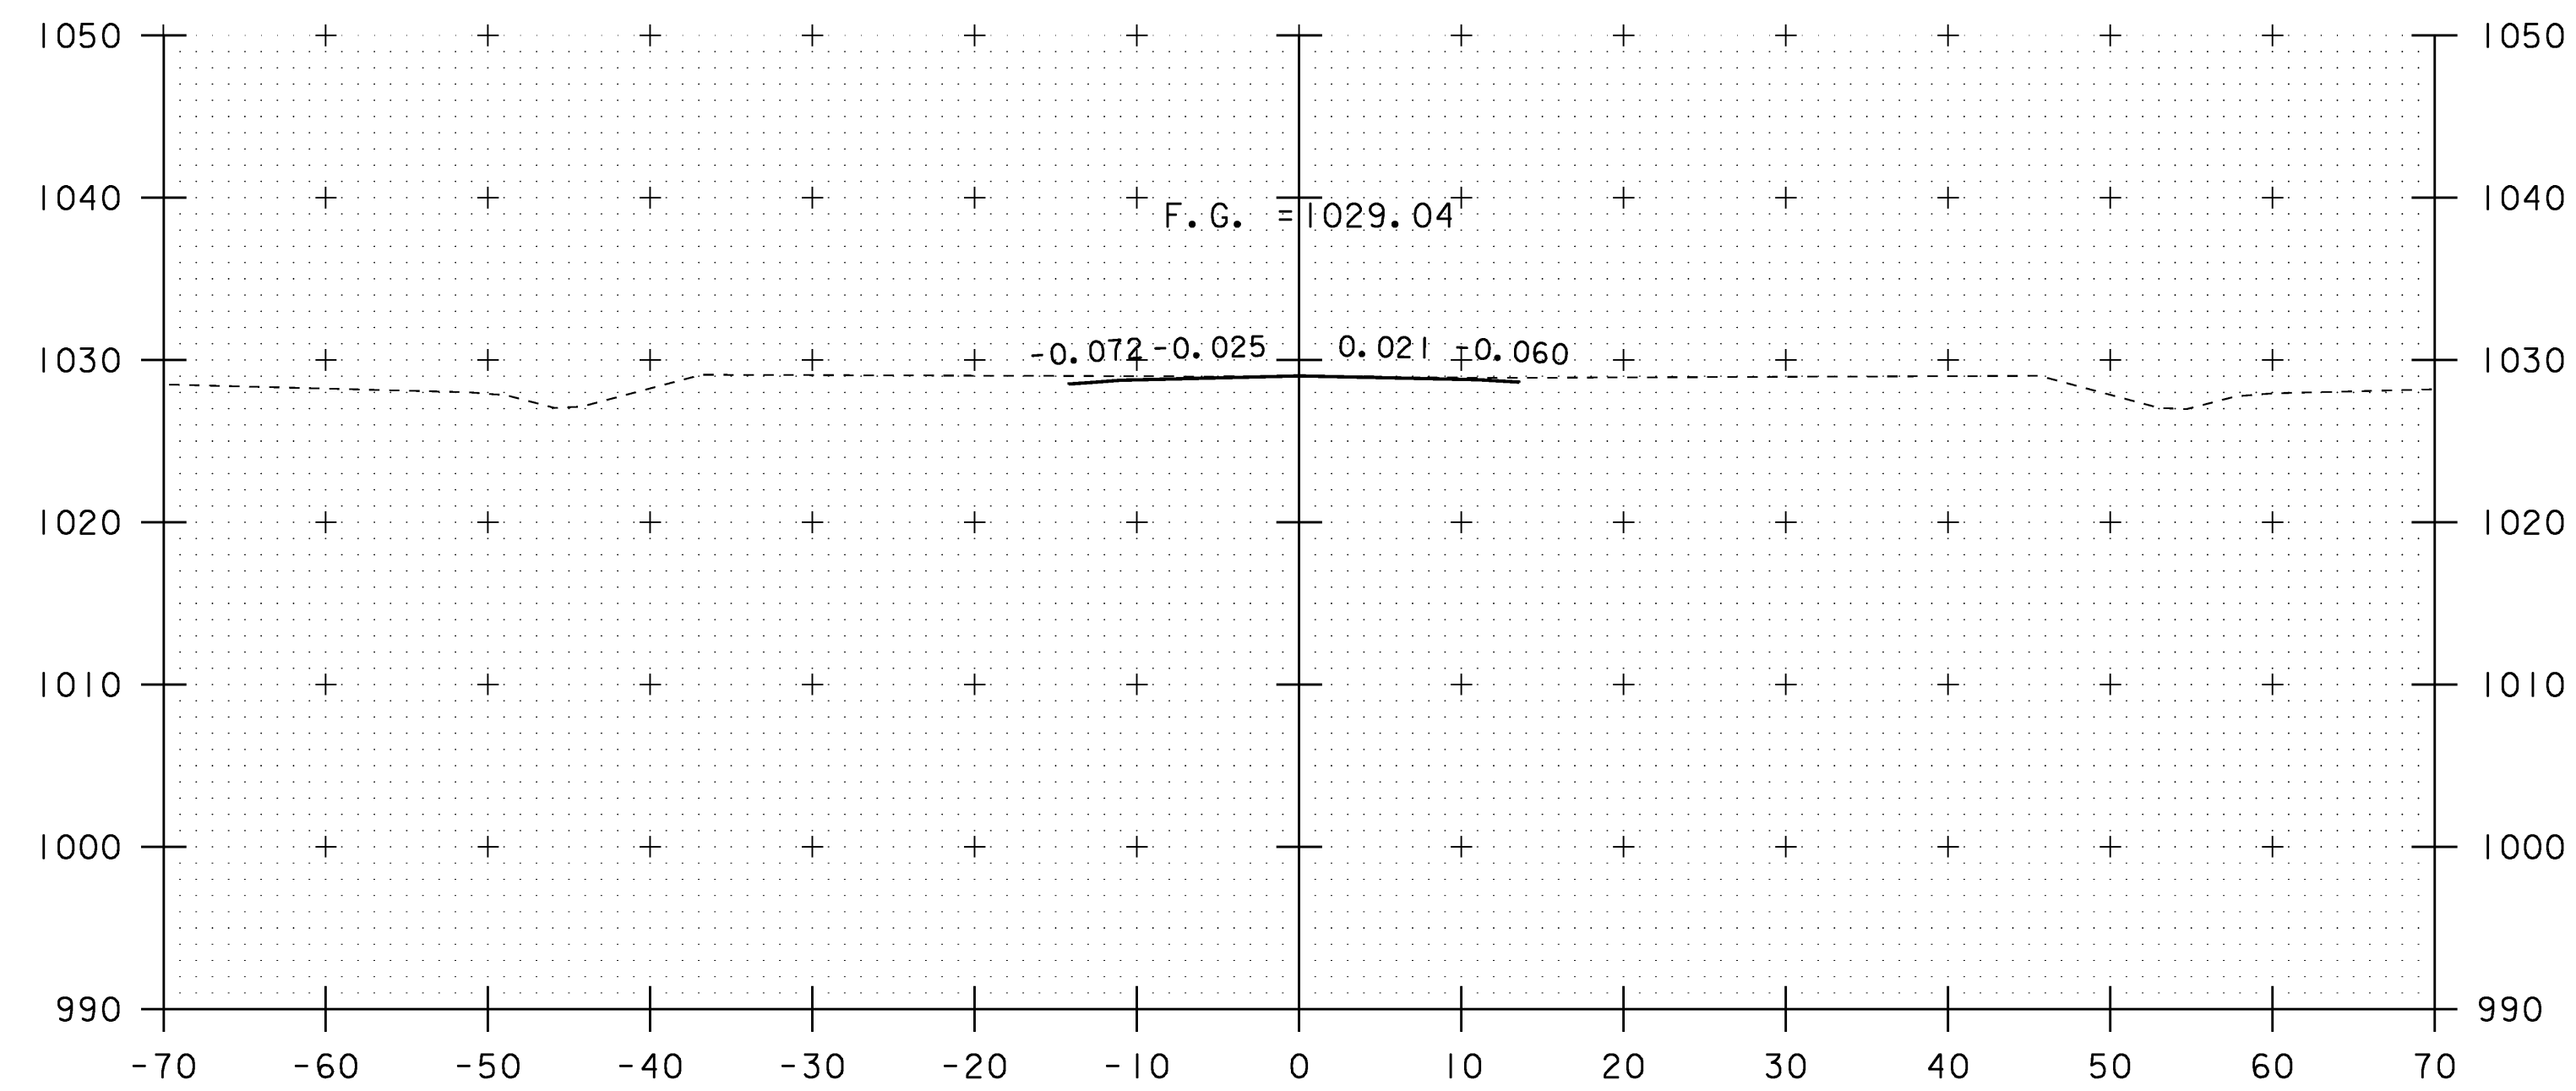

65+00

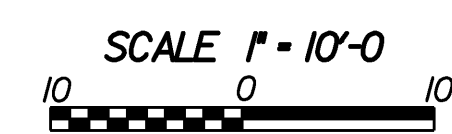

VT 102 CROSS SECTIONS (10)

PROJECT NAME:	CANAAN		
PROJECT NUMBER:	ER ST 0271(16)		
FILE NAME:	/str2/04c098/x04c098bdr.dgn	PLOT DATE:	18-AUG-2008
PROJECT LEADER:	EVANS-MONGEON	DRAWN BY:	HUSK
DESIGNED BY:	SCRIBNER	CHECKED BY:	SCRIBNER
x04c098r.xsl0.1		SHEET 61	OF 66