



BANKING DIAGRAM

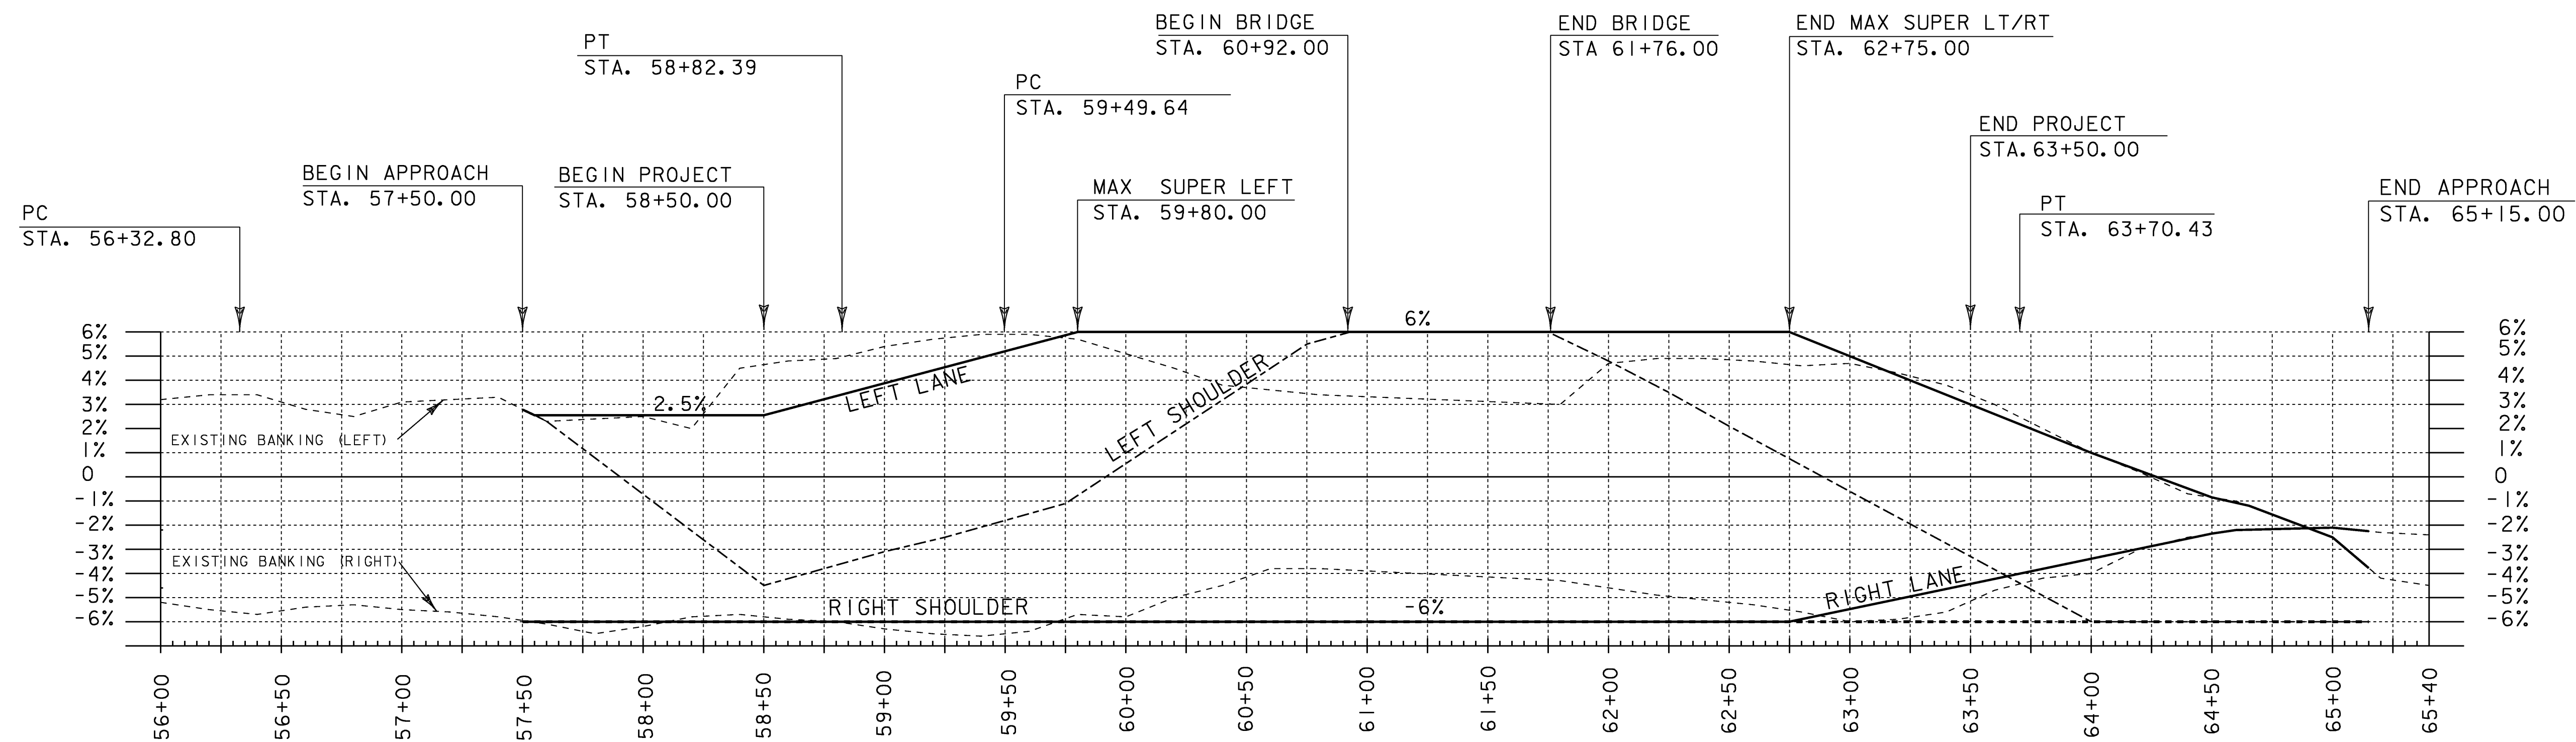

40 SCALE

MATERIAL TRANSITIONS

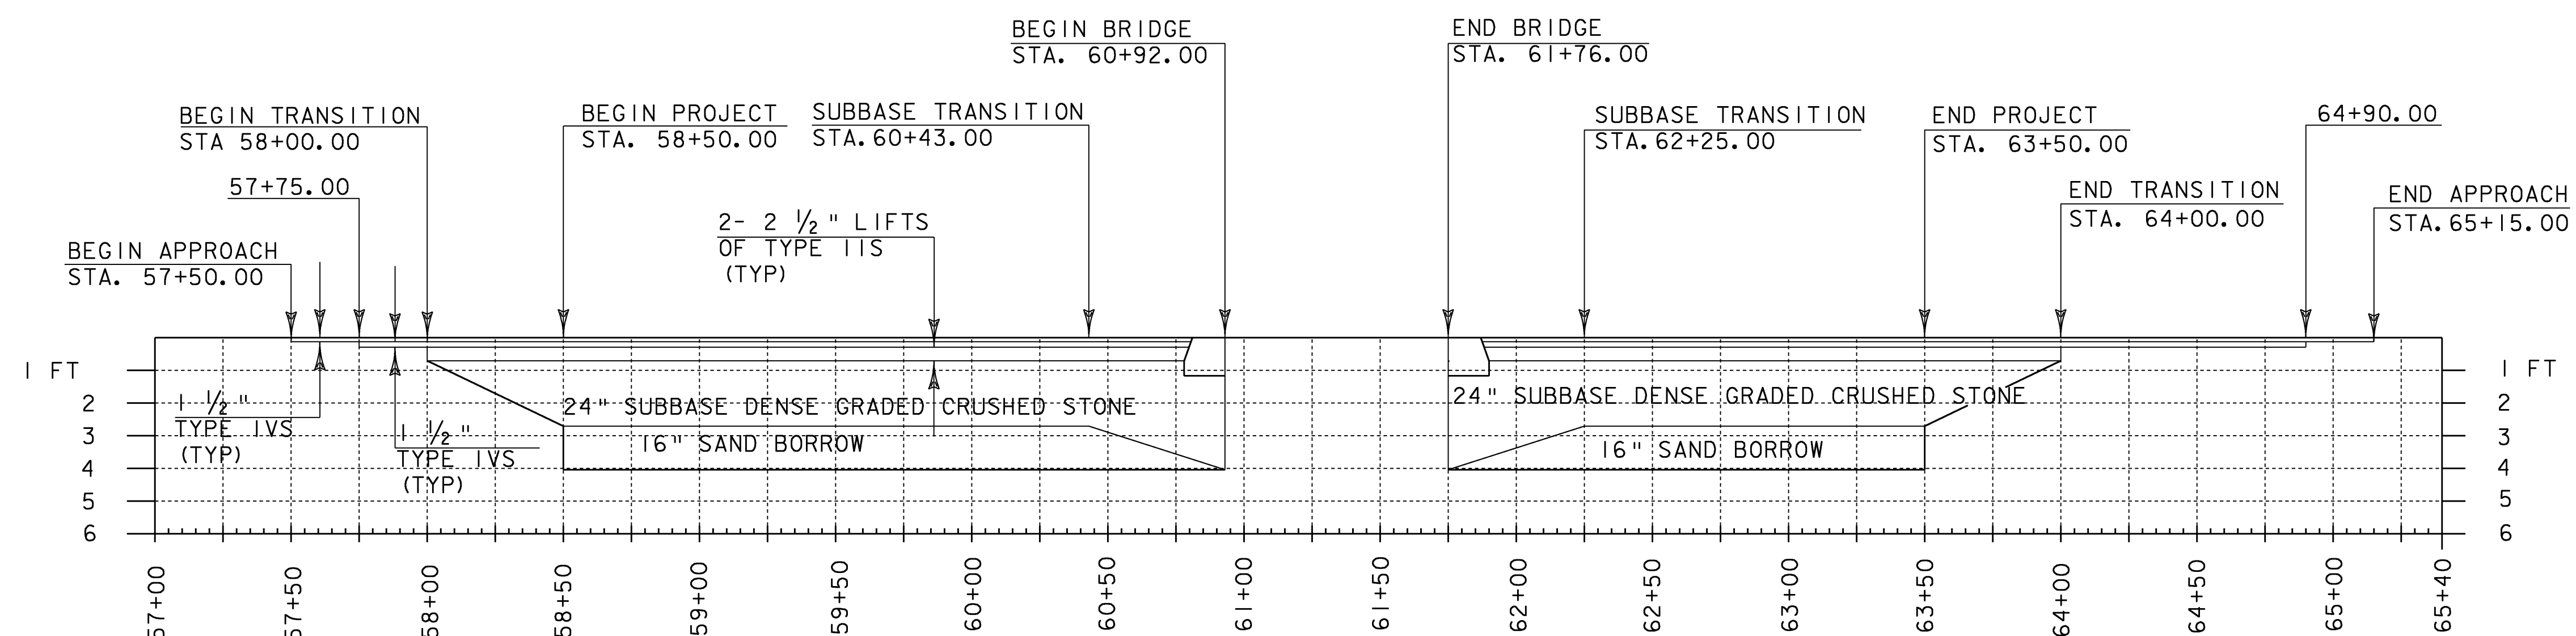

40 SCALE

BANKING DIAGRAM & MATERIAL TRANSITION

PROJECT NAME:	CANAAN
PROJECT NUMBER:	ER ST 0271 (16)
FILE NAME:	/str2/04c098/x04c098xs.dgn
PROJECT LEADER:	EVANS-MONGEON
DESIGNED BY:	SCRIBNER
PLOT DATE:	02-SEP-2008
DRAWN BY:	HUSK
CHECKED BY:	SCRIBNER
SHEET	62 OF 66