


SEE INDEX OF SHEETS & LIST OF STANDARDS ON SHEET 2

STATE OF VERMONT AGENCY OF TRANSPORTATION



PROPOSED IMPROVEMENT BRIDGE PROJECT TOWN OF CANAAN COUNTY OF ESSEX VT.102 (MAJOR COLLECTOR) BRIDGE #16

CANAAN ER ST 0271 (16)
VT 102: BR 16

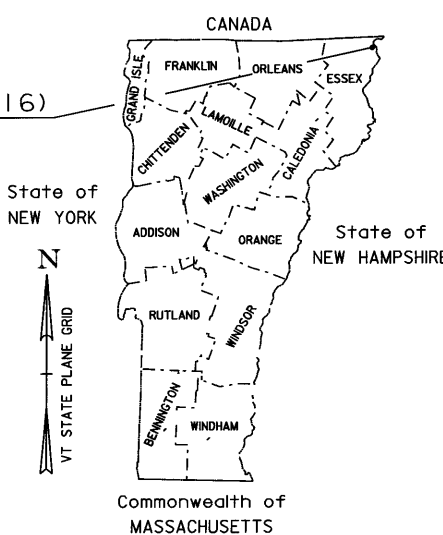


CANAAN ER ST 0271 (16)
VT 102: BR 16

PROJECT LOCATION : BEGINNING AT A POINT ON VT 102, APPROXIMATELY 2.0 MILES NORTH OF ITS JUNCTION WITH VT 26 AND PROCEEDING NORTHERLY APPROXIMATELY 0.1 MILES ALONG VT 102.

PROJECT DESCRIPTION : CONSTRUCT A NEW BRIDGE ON THE EXISTING ALIGNMENT, INCLUDING RELATED CHANNEL AND ROADWAY APPROACH WORK.

LENGTH OF STRUCTURE : 84 FEET.
LENGTH OF ROADWAY : 416 FEET.
LENGTH OF PROJECT : 500 FEET.

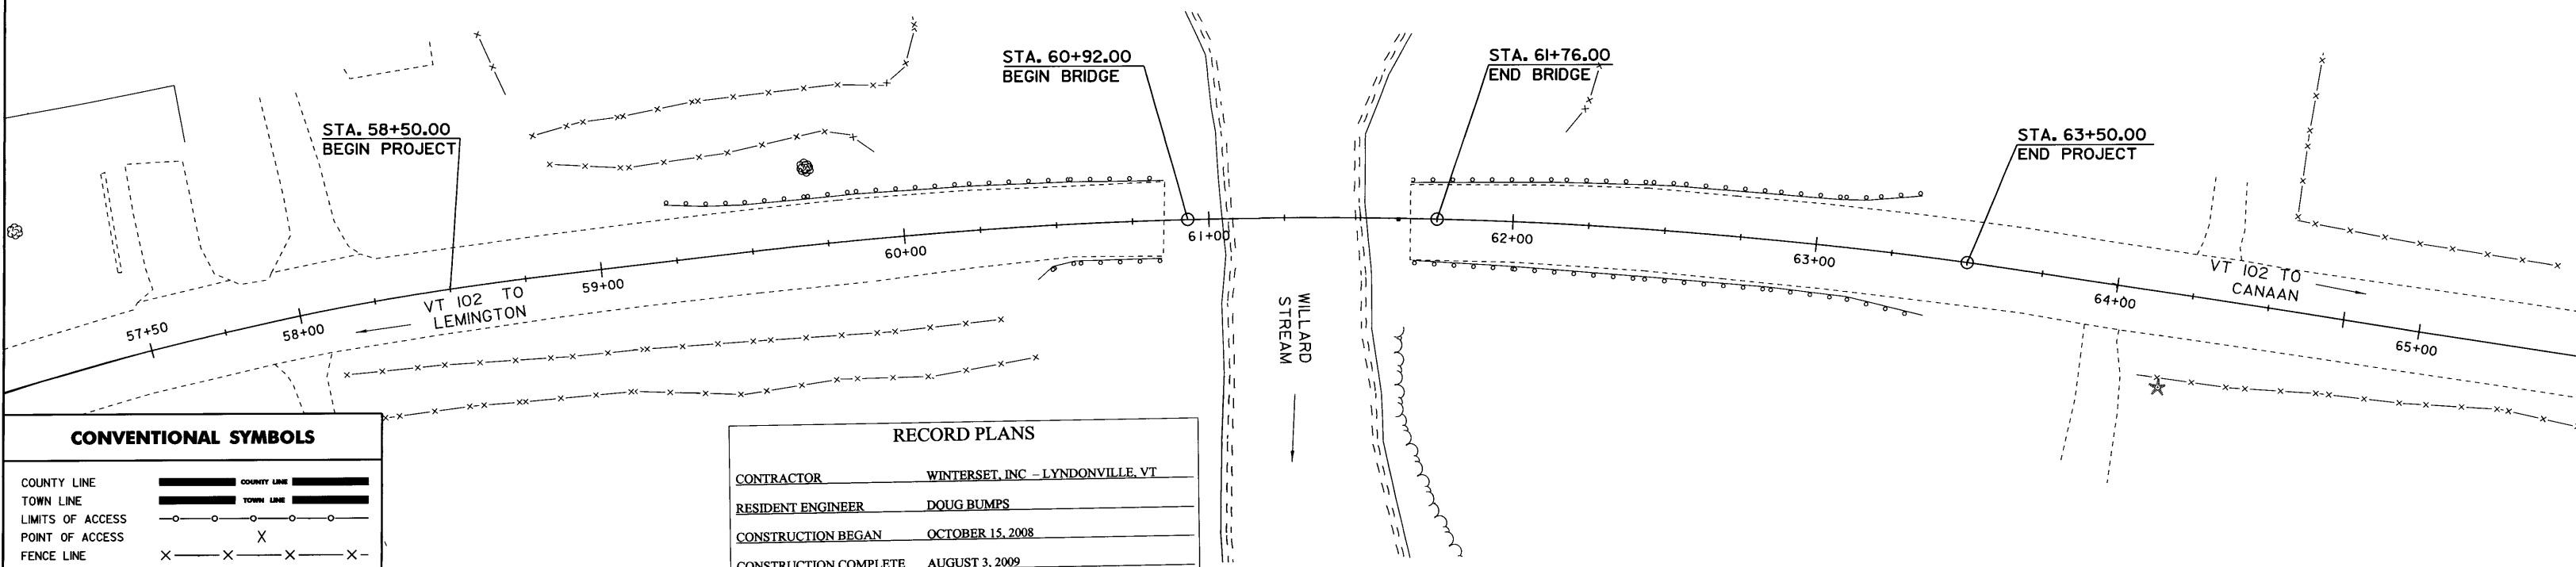

CONVENTIONAL SYMBOLS	
COUNTY LINE	— — — — —
TOWN LINE	— — — — —
LIMITS OF ACCESS	— — — — —
POINT OF ACCESS	○ — — — — ○
FENCE LINE	X — — — — X
STONE WALL	— — — — —
TRAVELED WAY	— — — — —
RAILROAD	— — — — —
SURVEY LINE	— — — — —
CULVERT	— — — — —
POWER POLE	⊙
TELEPHONE POLE	⊙
TREES	⊙
CONTRIBUTOR OF ACCESS	— — — — —
PROPERTY LINE	— — — — —
ROAD TAKING LINE	— — — — —
SLOPE RIGHTS	— — — — —
TOP OF CUT	— — — — —
TOE OF SLOPE	— — — — —

RECORD PLANS	
CONTRACTOR	WINTERSSET, INC - LYNDONVILLE, VT
RESIDENT ENGINEER	DOUG BURNS
CONSTRUCTION BEGAN	OCTOBER 15, 2008
CONSTRUCTION COMPLETE	AUGUST 3, 2009
RECORD PLANS BY	DOUG BURNS & C. PIERCE
I HEREBY CERTIFY THAT ALL THE CONSTRUCTION REQUIRED BY THIS SET OF DRAWINGS HAS BEEN ACCOMPLISHED AS INDICATED HEREIN	
BY	<i>[Signature]</i> RESIDENT ENGINEER
DATE	6/15/10
NOTE: Any further information concerning final quantities, amounts or other details relative to this project may be found at Central Files in the electronic archives	

SCALE 1" = 25'-0"

THESE PLANS ARE SUBJECT TO SUCH ENGINEERING CHANGES AS MAY BE REQUIRED BY THE FEDERAL HIGHWAY ADMINISTRATION OR THE DIRECTOR OF PROGRAM DEVELOPMENT.
CONSTRUCTION IS TO BE CARRIED ON IN ACCORDANCE WITH THESE PLANS AND THE STANDARD SPECIFICATIONS FOR CONSTRUCTION DATED 2006, AS APPROVED BY THE FEDERAL HIGHWAY ADMINISTRATION ON LINE 96-2006. FOR USE ON THIS PROJECT, INCLUDING ALL SUBSEQUENT REVISIONS AND SUCH REVISED SPECIFICATIONS AND SPECIAL PROVISIONS AS ARE INCORPORATED IN THESE PLANS.

DIRECTOR OF PROGRAM DEVELOPMENT	DATE 2/22/09
APPROVED <i>[Signature]</i>	
PROJECT MANAGER : M. EVANS-MONGEON	
PROJECT NAME : CANAAN	
PROJECT NUMBER : ER ST 0271 (16)	
SHEET 1 OF 66 SHEETS	

SURVEYED BY : R. GILMAN
SURVEYED DATE : OCT. 19, 2004
DATUM
VERTICAL : NAVD 88
HORIZONTAL : NAD 83 (96)