

RIGHT - OF - WAY DETAIL SHEET


TABLE OF PROPERTY ACQUISITION

PARCEL NO.	PROPERTY OWNER	SHEET NO.	BEGINNING STATION	ENDING STATION	TAKE	REMAINDER	RIGHT			RECORDING DATA					REMARKS
					AREA±	AREA±	TYPE	(T)(P)	AREA ±	TITLE	DATE	TOWN / CITY	BOOK	PAGE	
1A	RICHARDS, DENNIS B. & LISA G.	14,15	58+50.00 LT.	62+14.82 LT.	4,113 S.F.					WD	05/21/08	CANAAN	55	623	
1B		14,15	60+74.00 RT.	61+99.99 RT.	3493 S.F.										
1C		14,15	56+21.00 RT.	64+55.24 LT.	.95A			ALL R.T. & I.							VT. RTE. 102 HWY. EASEMENT 9932 S.F.±
			56+21 RT.	64+52 RT.				UE	(P)	23 A					
			56+21 RT.	64+50 RT.				UE	(T)						
			56+21 RT.	57+44 RT.				REMOVE	(T)						FENCE
			57+97 RT.					DRIVE	(T)						12' DRIVE GRAVEL MM 0109
			58+47 RT.	61+03 RT.				CONST.	(T)	2,294 S.F.					INCLUDES EROSION CONTROL & PDF
			58+11 RT.	60+98 RT.				REMOVE	(T)						FENCE
			58+61 RT.	60+98 RT.				REMOVE	(T)						FENCE
			58+87 RT.	63+89 RT.				DETOUR	(T)	46 A					19,837 S.F.±
			59+17 RT.	60+07 RT.				SLOPE	(T)	776 S.F.					
			61+58 RT.	64+20 RT.				CONST.	(T)	2,404 S.F.					INCLUDES EROSION CONTROL & PDF
			62+75 RT.	62+99 RT.				SLOPE	(P)	19 S.F.					
			62+99 RT.	63+72 RT.				SLOPE	(T)	1136 S.F.					
			64+10 RT.	64+50 RT.				REMOVE	(T)						FENCE
			57+58 LT.					DRIVE	(T)						19' DRIVE GRAVEL MM 0109
			58+11 LT.					DRIVE	(T)						12' DRIVE GRAVEL MM 0110
			58+17 LT.	61+07 LT.				CONST.	(T)	2,335 S.F.					INCLUDES EROSION CONTROL & PDF
			58+82 LT.	59+92 LT.				REMOVE	(T)						FENCE
			58+87 LT.	60+04 LT.				REMOVE	(T)						FENCE
			58+90 LT.	60+49 LT.				SLOPE	(P)	2,686 S.F.					
			61+56 LT.	64+38 LT.				CONST.	(T)	2,556 S.F.					INCLUDES EROSION CONTROL & PDF
			62+00 LT.	63+69 LT.				SLOPE	(P)	1,233 S.F.					
			62+03 LT.	62+23 LT.				REMOVE	(T)						FENCE
			63+04 LT.	63+30 LT.				REMOVE	(T)						FENCE
			63+98 RT.					DRIVE	(T)						14' DRIVE FIELD MM 0120
			64+33 LT.					DRIVE	(T)						12' DRIVE FIELD MM 0120
2	SARACO, MICHAEL D. III MAGUIRE, KEVIN C.	15	64+50 RT.	64+89 RT.				INSTALL	(T)	106 S.F.		CANAAN			PDF
			64+50 RT.	65+12 RT.				UE	(T)						
			64+51 RT.	65+30.83 RT.				UE	(P)	918 S.F.					
			64+50.61 RT.	65+30.83 RT.	3857 S.F.			ALL R.T. & I.							VT. RTE. 102 HWY EASEMENT
3	WHITE MOUNTAIN CABLEVISION														UTILITY
4	VERMONT ELECTRIC COOPERATIVE INC.														UTILITY
5	VERIZON NEW ENGLAND INC.														UTILITY

TABLE OF REVISIONS

REVISION NO.	SHEET NO.	DESCRIPTION	DATE
1	13,14 15	PARCEL NO. 1 RICHARDS. CHANGE THE EIGHT RIGHTS FROM REMOVE & RESET FENCE TO REMOVE FENCE. CHANGE BEGINNING STATION OF DRIVE (T) FROM 63+98 LT. TO STA. 63+98 RT. PER C.O. 9502 MADE BY: MR APPROVED BY: HP	11/30/07
2	13	PARCEL NO. 1 RICHARDS. CHANGE THE ENDING STATION FOR REMOVE (T) FENCE FROM 57+24 TO 57+44. PER C.O. 9508 MADE BY: JAB APPROVED BY: HP	01/10/08
3	13	PARCEL NO. 1C RICHARDS. CHANGE THE AREA FOR THE SLOPE (P) AT STA. 62+00 LT. ~ 63+69 LT. FROM 581 SF± TO 1,233 S.F.± PER C.O. 9509 MADE BY: MR APPROVED BY: HP	01/14/08
		PRE-FINAL PLANS NUMBERED FOR LEAD DIVISION	05/07/08

PLAN LEGEND

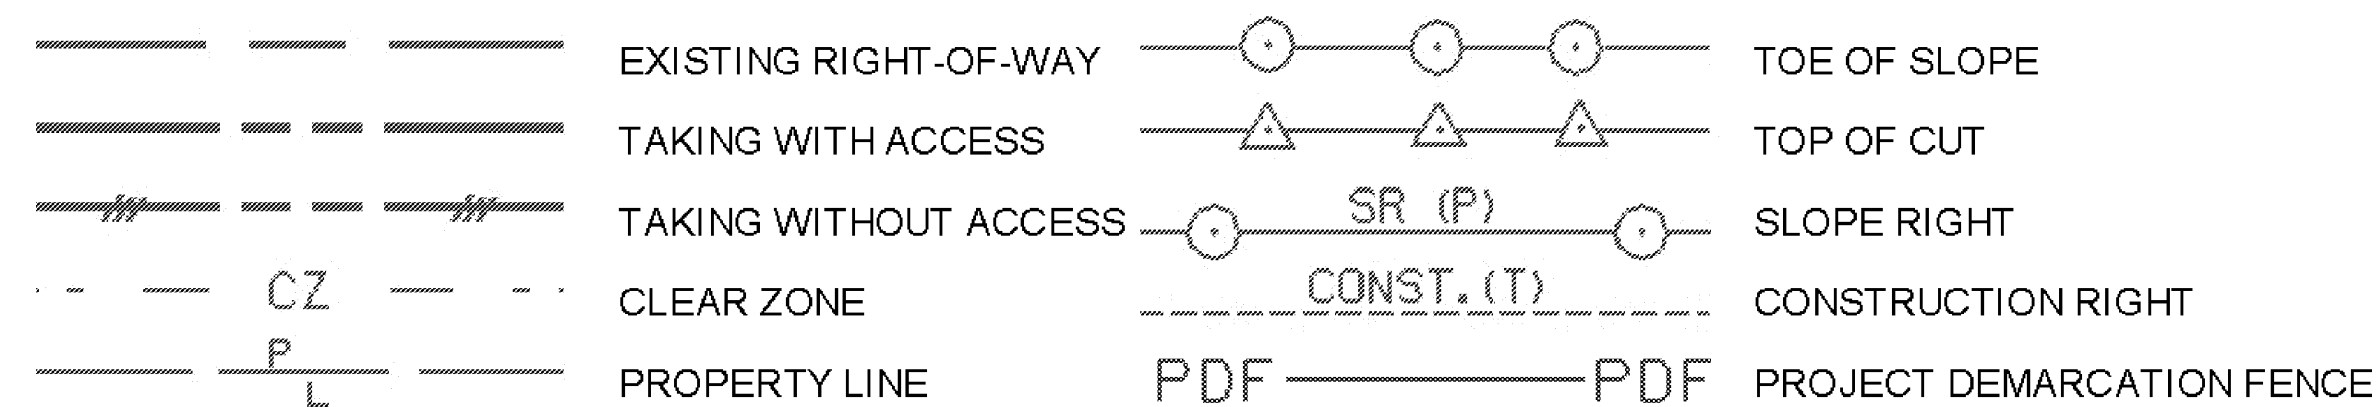

- EC - EROSION CONTROL
- (P) - PERMANENT
- (T) - TEMPORARY
- DR. - DRAINAGE RIGHT
- DIT. - DITCHING RIGHT
- CH. - CHANNEL RIGHT
- DRIVE - DRIVE RIGHT
- CUL. - CULVERT RIGHT
- C&T - CLEARING & TRIMMING RIGHT
- SR - SLOPE RIGHT
- UE - UTILITY EASEMENT

APPROVED: HARRY PETROVS DATE: 10-25-07
CHIEF, PLANS & TITLES

PLOT DATE 07/22/08

PROJECT NAME: **CANAAN**
 PROJECT NUMBER: **ER ST 0271(16)**
 FILE NAME: **RC098DET.XLS** PLOT DATE:
 PROJECT LEADER: **EVANS-MONGEON** DRAWN BY: **MR**
 DESIGNED BY: **BF** CHECKED BY: **BF**
R.O.W. DETAIL SHEET #1 SHEET **8** OF **66**