
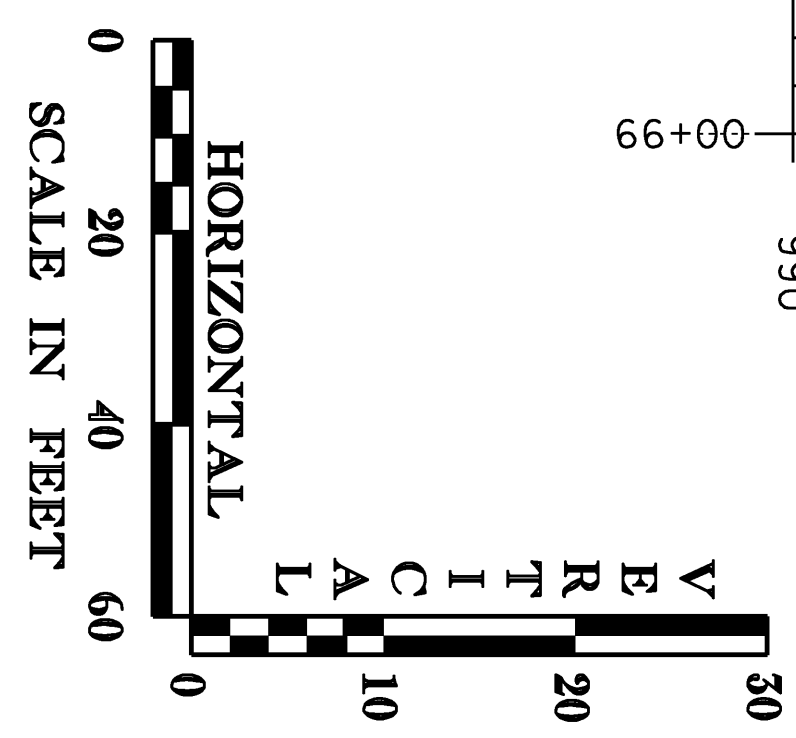


PROFILE ALONG CENTERLINE VT 102

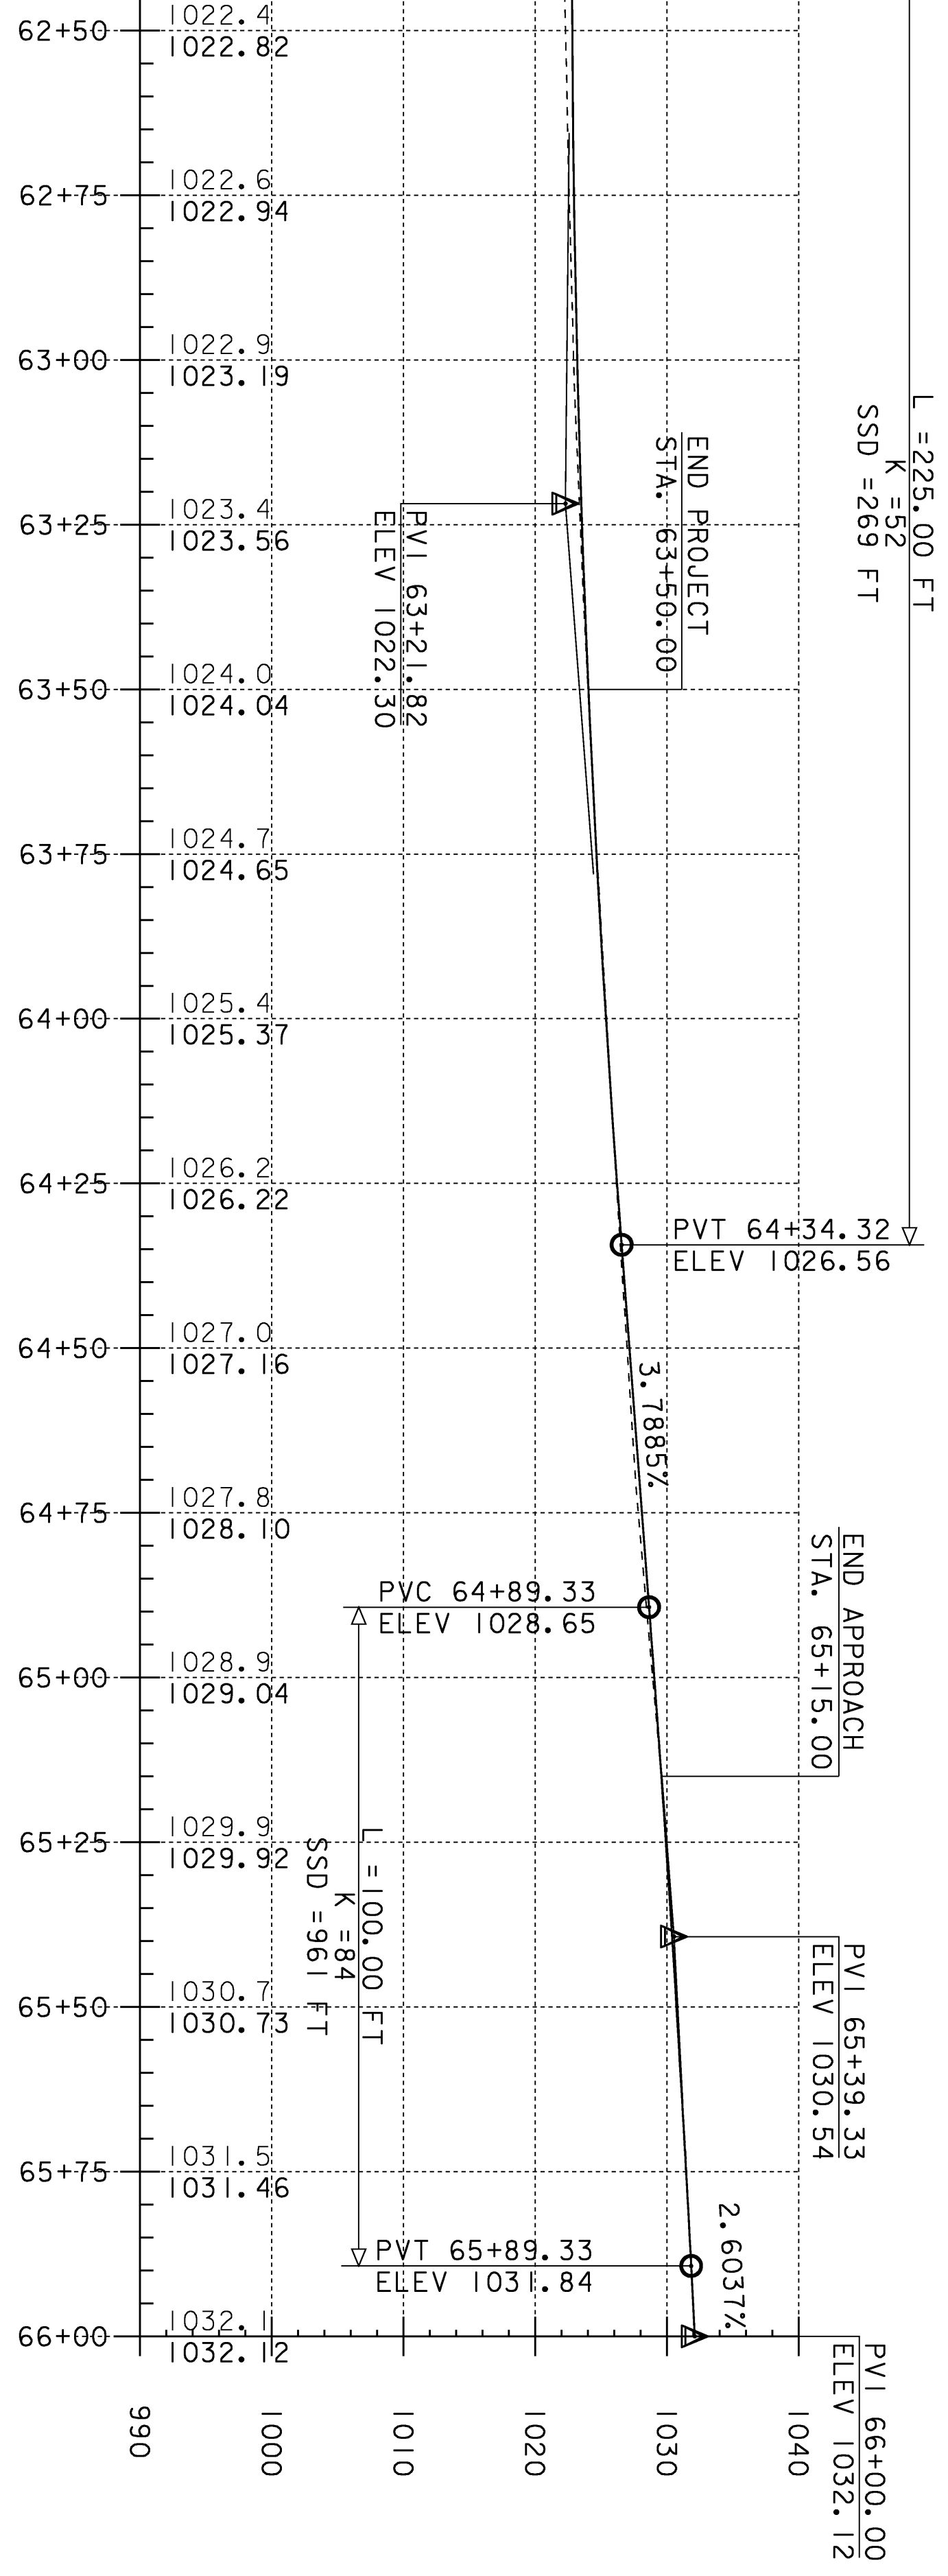

PROFILE SHEET #2

PROJECT NAME: CANNON	PROJECT NUMBER: ER ST 0271(6)	FILE NAME: Structure\X04c098p21.dgn	PROJECT LEADER: M. Evans-Monaghan	DESIGNED BY: S. Scribner	PL01 DATE: 18-AUG-2008	DRAWN BY: T. Husk	CHECKED BY: S. SCRIBNER.	SHEET IS OF 66
----------------------	-------------------------------	-------------------------------------	-----------------------------------	--------------------------	------------------------	-------------------	--------------------------	----------------

NOTE: ELEVATIONS SHOWN TO THE TENTH ARE EXISTING GROUND
ELEVATIONS SHOWN TO THE HUNDRETH ARE FINISH GRADE