

BEGIN APPROACH
STA 57+50.00
DETOUR STATION
7+00

BEGIN PROJECT
STA 58+50.00
30' R
(TYP)

STA. 60+65.00 MAINLINE
STA. 16+77.00 CHANNEL LINE
 $\Delta = 90^\circ$ TO TANGENT

BEGIN BRIDGE
STA 60+92.00


SPECIAL PROVISION
(DRY HYDRANT)

END BRIDGE
STA 61+76.00

STONE FILL
TYPE III

LEGEND

CLASS II WETLAND	
EXISTING CONTOURS	
SOIL BOUNDARY	
WETLAND BUFFER ZONE	
AGRICULTURAL	

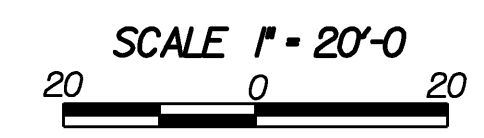

CONTOURS SHOWN ARE EXISTING CONTOURS,
SEE CROSS SECTIONS FOR PROPOSED CONTOURS.

FINAL CONDITIONS SITE PLAN (1)

PROJECT NAME:	Canaan	PLOT DATE:	18-AUG-2008
PROJECT NUMBER:	ER ST 0271(16)	DRAWN BY:	T. Husk
FILE NAME:	Structures\04c098erobdr.d	CHECKED BY:	S. Scribner
DESIGNED BY:	S. Scribner	SHEET	21 OF 66