

MATCHLINE STA 62+25

END PROJECT
STA 63+50.00

20' R
(TYP)

END APPROACH
STA 65+15.00


20' R
(TYP)

VT 102
TO CANAAN

FIELD DRIVE

LEGEND

CLASS II WETLAND	
EXISTING COUNTOURS	
SOIL BOUNDARY	
WETLAND BUFFER ZONE	
AGRICULTURAL	

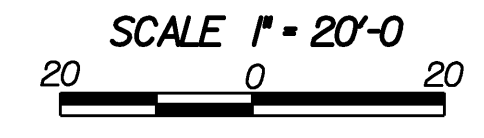

CONTOURS SHOWN ARE EXISTING CONTOURS,
SEE CROSS SECTIONS FOR PROPOSED CONTOURS.

FINAL CONDITIONS SITE PLAN (2)

PROJECT NAME: Canaan	PLOT DATE: 18-AUG-2008
PROJECT NUMBER: ER ST 0271(16)	DRAWN BY: T. Husk
FILE NAME: Structures\X04c098erobdr.d	CHECKED BY: S. SCRIBNER
PROJECT LEADER: M. Evans-Mongeon	SHEET 22 OF 66
DESIGNED BY: S. Scribner	