


**PLAN**

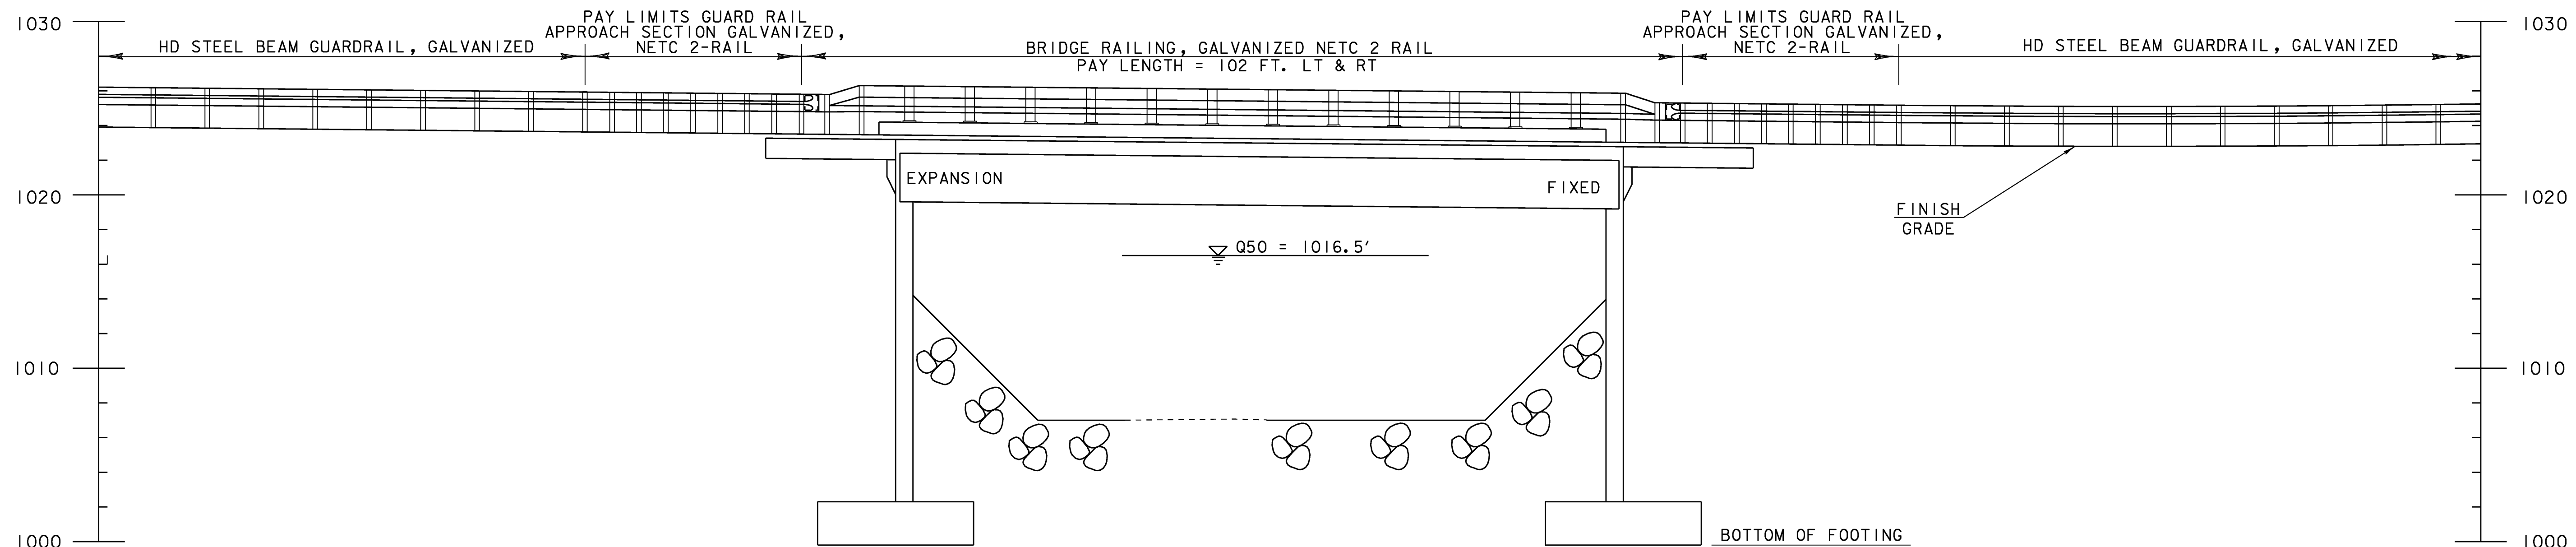

**ELEVATION**

SCALE 1" = 10'-0"

**PLAN AND ELEVATION**

PROJECT NAME: Canaan	PLOT DATE: 18-AUG-2008
PROJECT NUMBER: ER ST 0271(16)	DRAWN BY: L. DUQUETTE
FILE NAME: Structures/04c098pe.dgn	CHECKED BY: S. SCRIBNER
PROJECT LEADER: M. Evans-Mongeon	SHEET 31 OF 66
DESIGNED BY: S. Scribner	