



ABUTMENT NO. 1 PLAN

SCALE 3/16" = 1'-0"
1 0 2 4 6 8

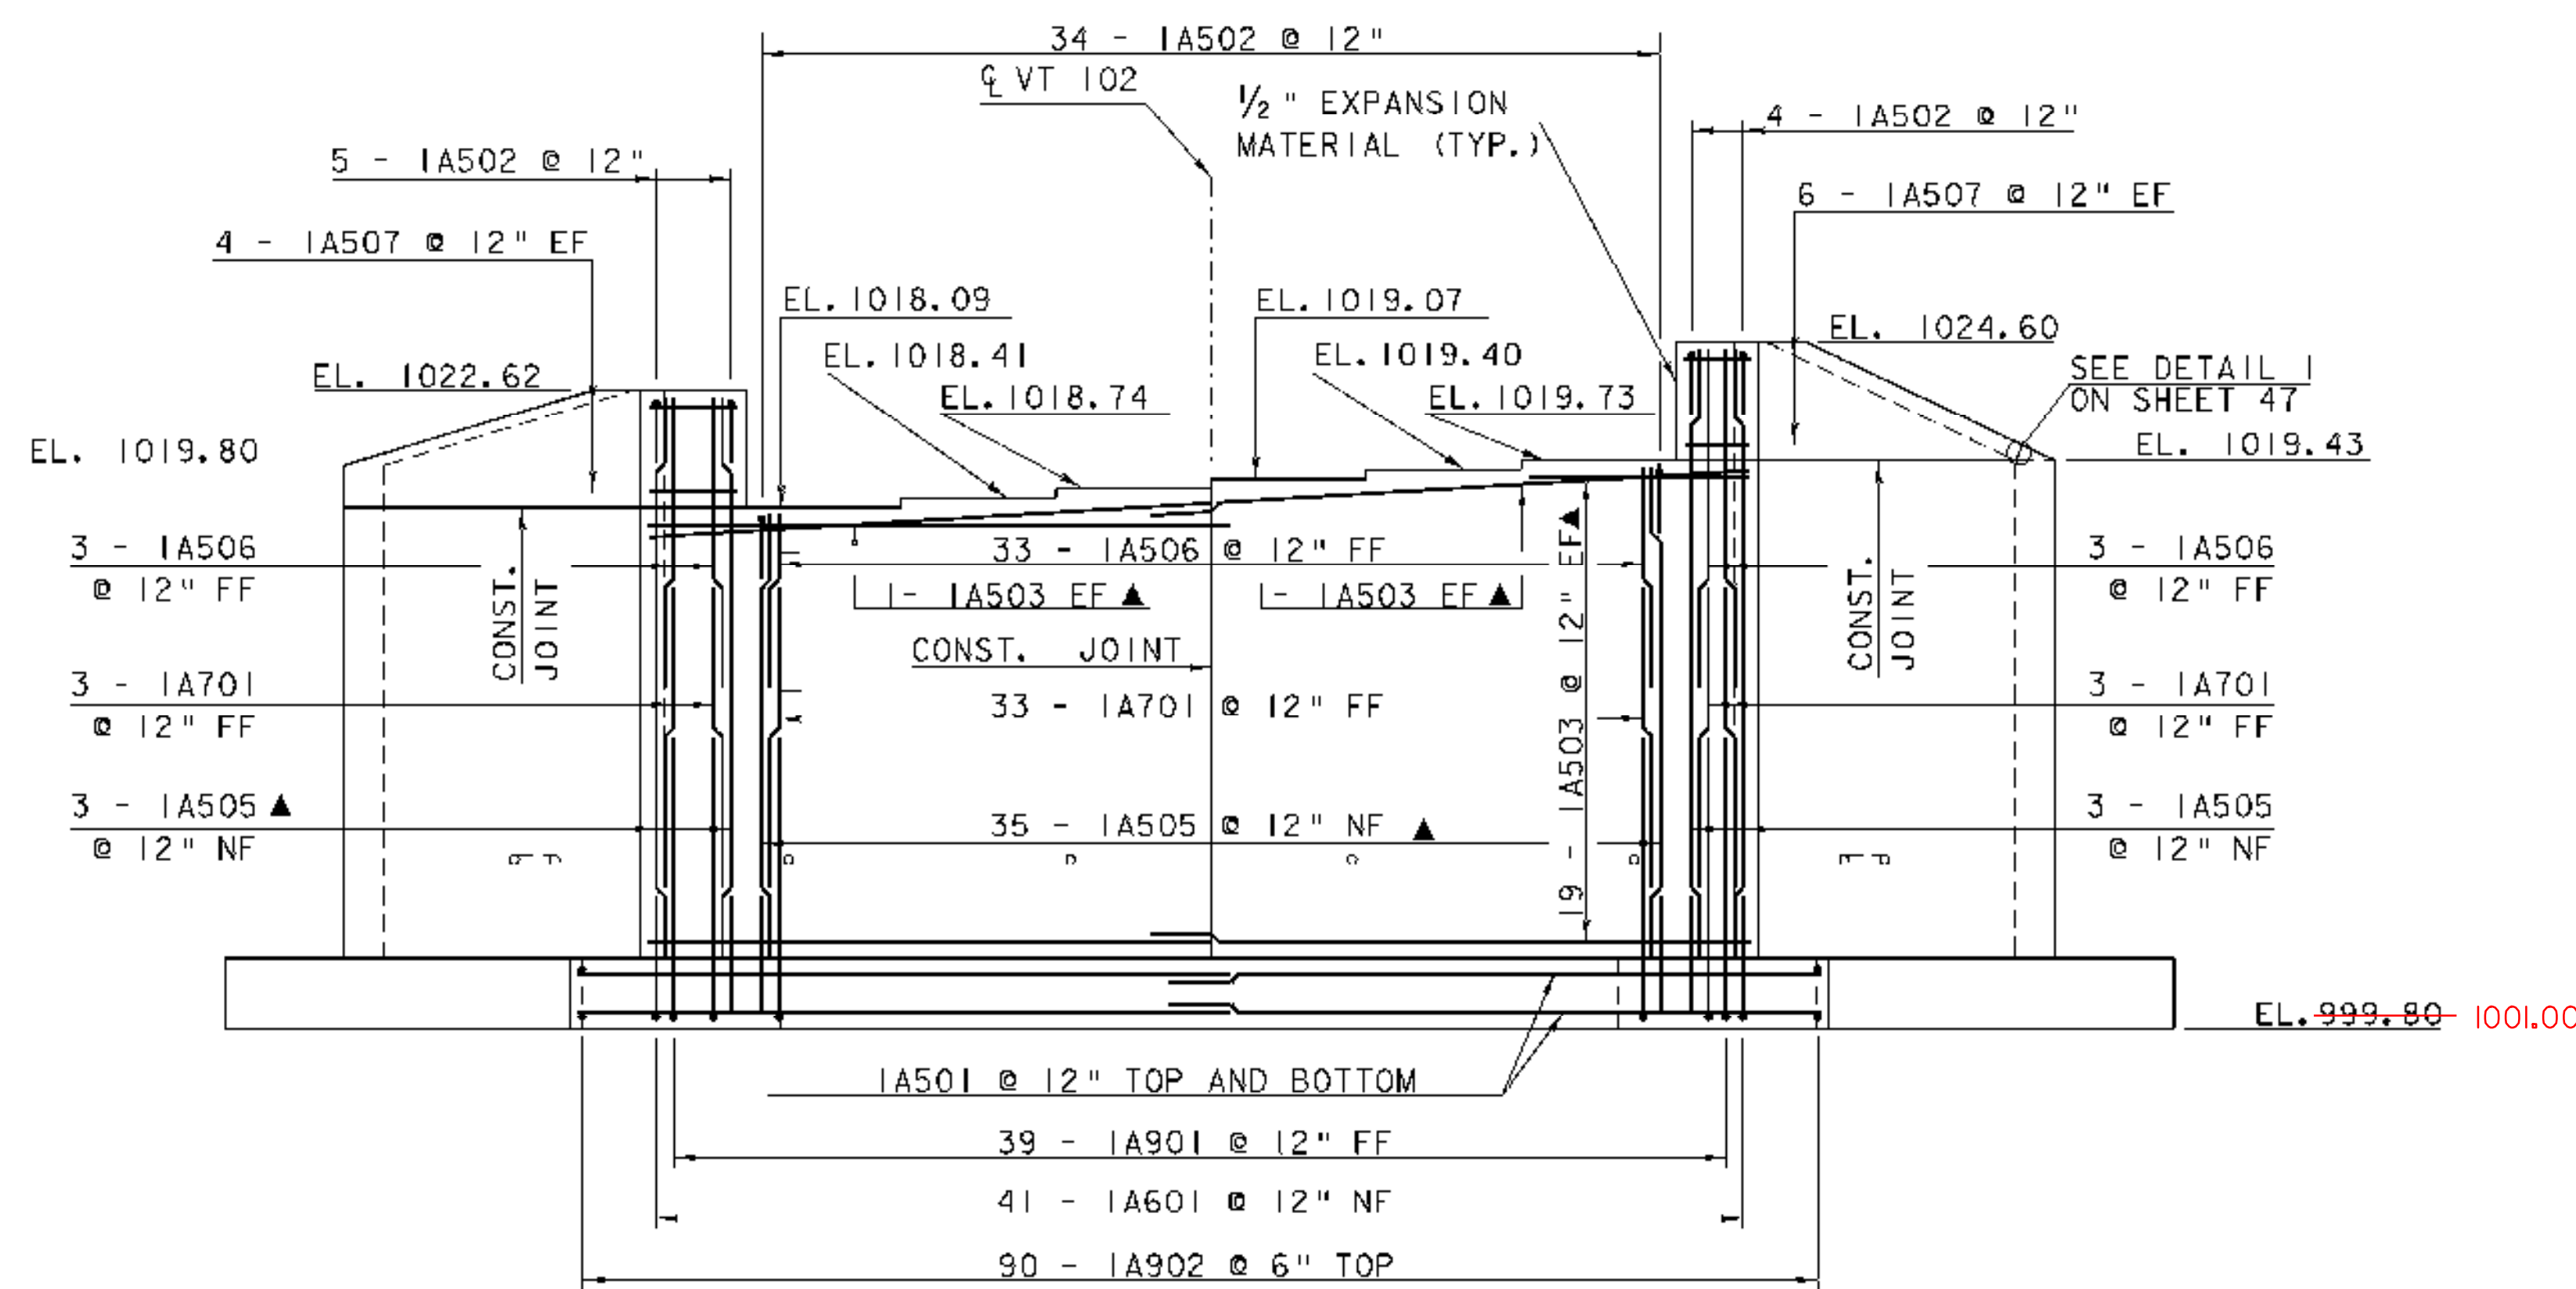

ABUTMENT NO. 1 ELEVATION

SCALE 3/16" = 1'-0"
1 0 2 4 6 8

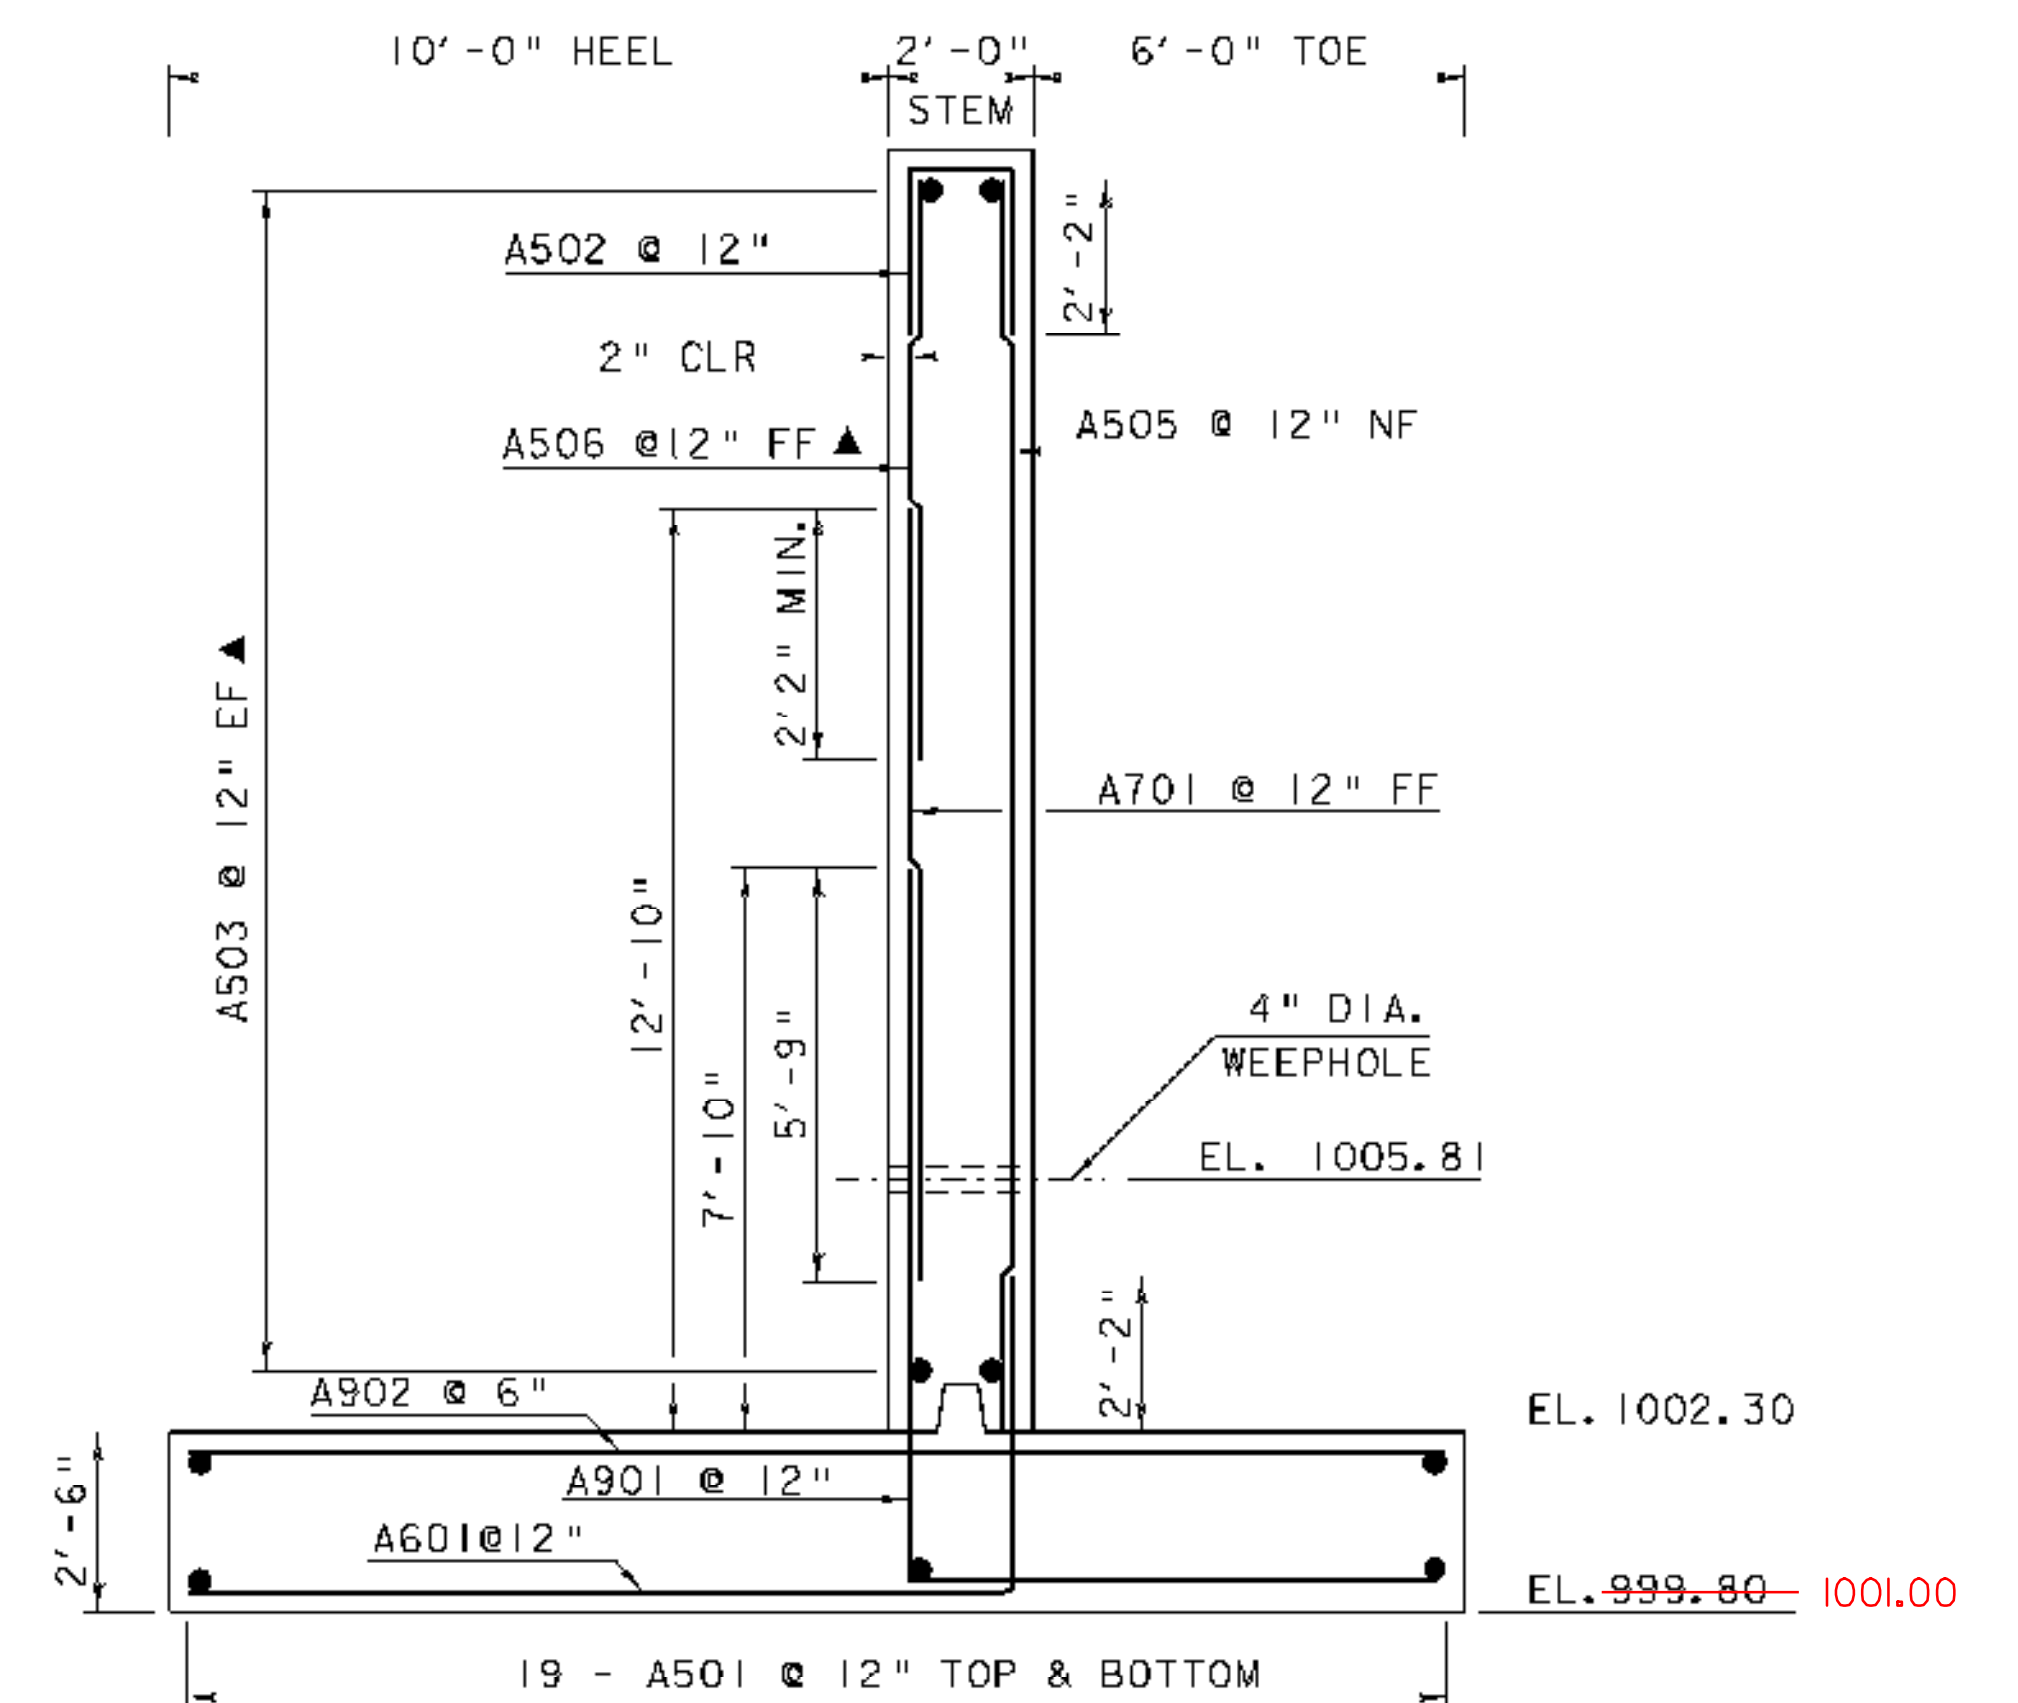

ABUTMENT TYPICAL

SCALE 3/16" = 1'-0"
1 0 1 2 3 4

NOTE:

- NI = NEAR FACE
- FF = FAR FACE
- FF = FACH FACF
- ▲ - CUT TO FIT IN FIELD
- 3" CI FAR, UNIFSS OTHERWISE SPECIFIED ON THE PLANS.
- 2'-2" BAR LAP UNLESS OTHERWISE SPECIFIED ON THE PLANS.

ALL DIMENSIONS ARE TAKEN FROM THE MAJOR CHORD NOT FROM THE C OF VT 102

ABUTMENT #1 DETAILS

PROJECT NAME:	CANAAN	PLOT DATE:	18-AUG-2008
PROJECT NUMBER:	ER ST 0271(16)	DRAWN BY:	C. JOLLY
FILE NAME:	04c098/struc./s04c098sup	CHECKED BY:	S. SCRIBNER
PROJECT LEADER:	M. EVANS-MONGEON	SHEET	44 OF 66
DESIGNED BY:	S. SCRIBNER		