


SCALE 1" = 10'-0"
 10 0 10

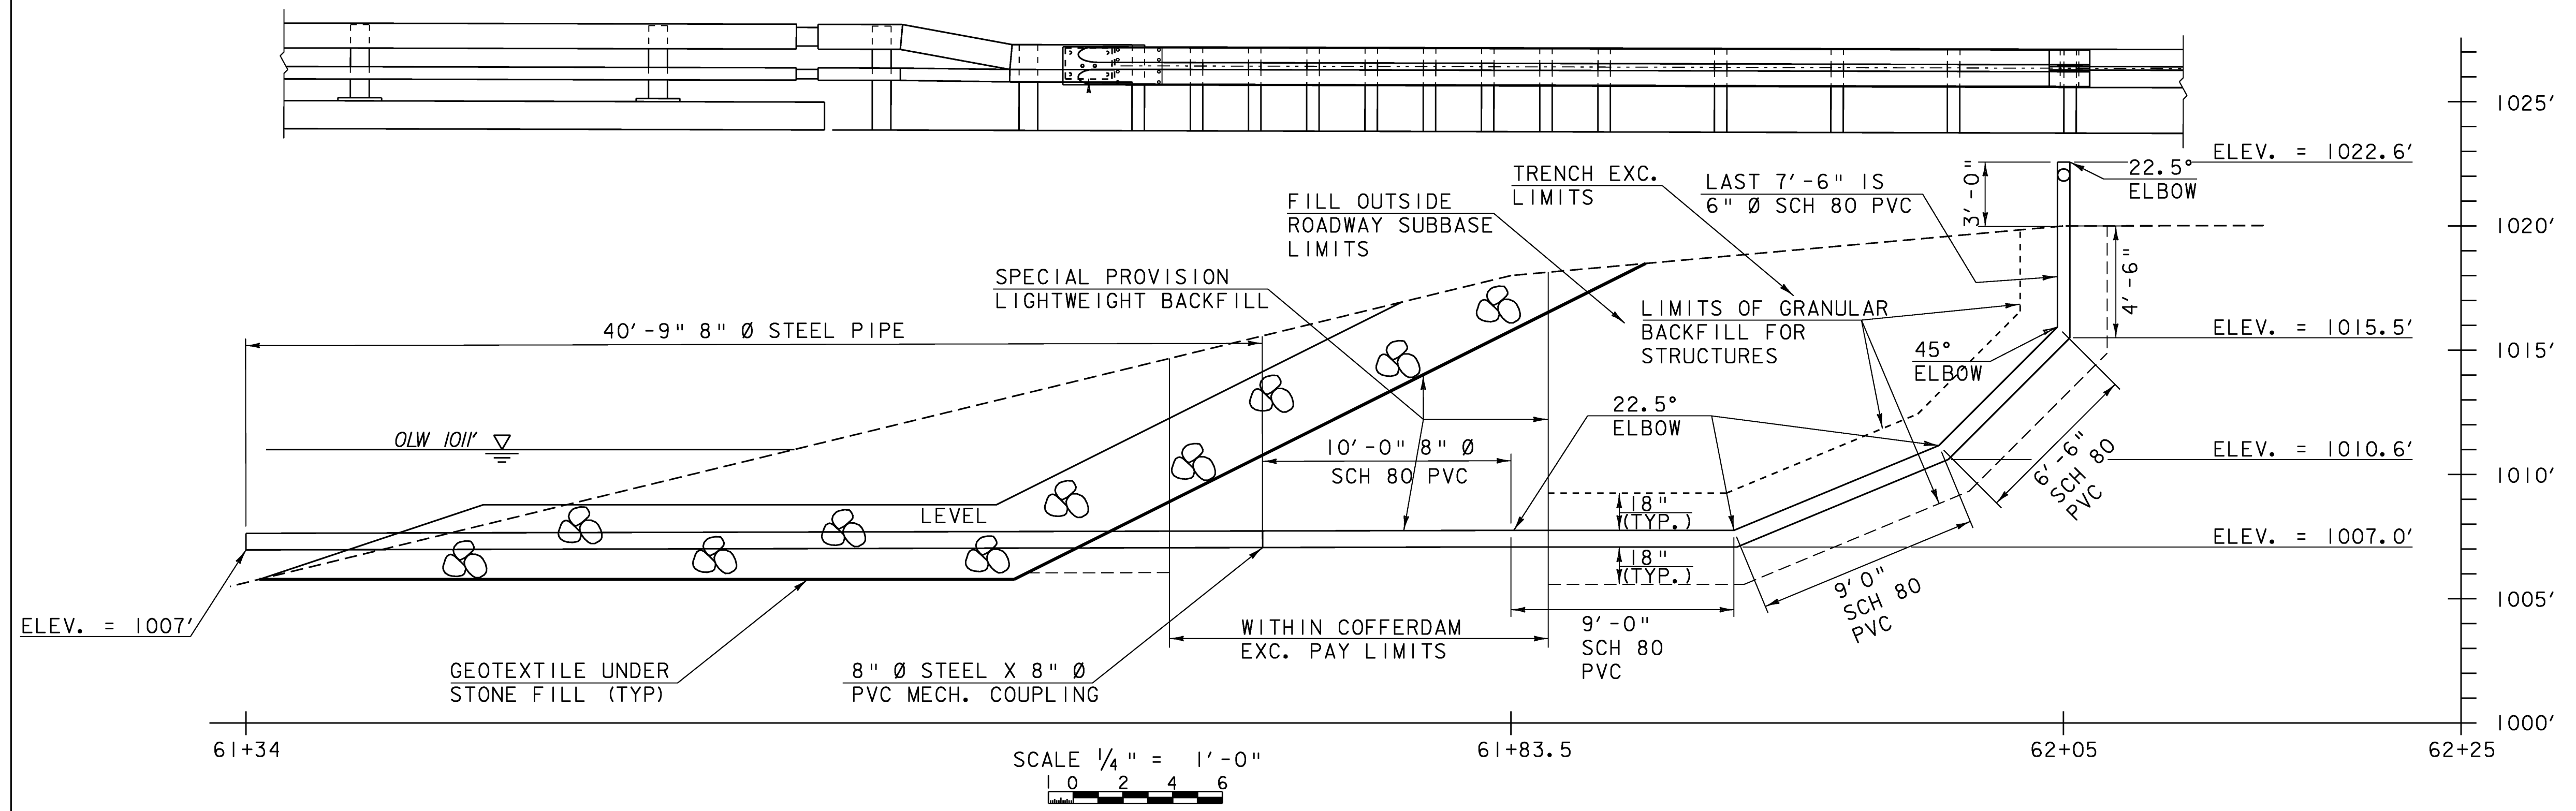

SCALE 1/4" = 1'-0"
 1 0 2 4 6

*CARE SHALL BE GIVEN THAT ANY EXCAVATION OUTSIDE THE COFFERDAM EXCAVATION LIMITS AND CHANNEL EXCAVATION LIMITS FOR THE PURPOSE OF PLACING THE DRY HYDRANT WILL BE PAID UNDER TRENCH EXCAVATION LIMITS

- NOTE:
1. VERIFY LENGTH TO DEEPEST CHANNEL POINT IN FIELD PRIOR TO INSTALLATION
 2. SEE CHANNEL CROSS SECTION 17+00

DRY HYDRANT DETAIL

PROJECT NAME: Canaan	PLOT DATE: 19-AUG-2008
PROJECT NUMBER: ER ST 0271(16)	DRAWN BY: L.DUQUETTE
FILE NAME: Structures\x04c098xs.dgn	CHECKED BY: S. SCRIBNER.
PROJECT LEADER: M. Evans-Mongeon	SHEET 50 OF 66
DESIGNED BY: S. Scribner	