


57+75

58+00

VT 102 CROSS SECTIONS (1)

PROJECT NAME:	CANAAN	PLOT DATE:	18-AUG-2008
PROJECT NUMBER:	ER ST 0271(16)	DRAWN BY:	HUSK
FILE NAME:	/sfr2/04c098/x04c098xs.dgn	CHECKED BY:	SCRIBNER
PROJECT LEADER:	EVANS-MONGEON	SHEET	52
DESIGNED BY:	SCRIBNER	OF	66
X04G098-X.s11			

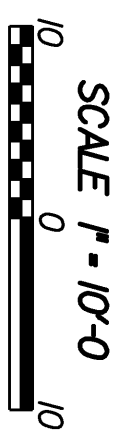

SCALE 1"=10'-0"