




58+25

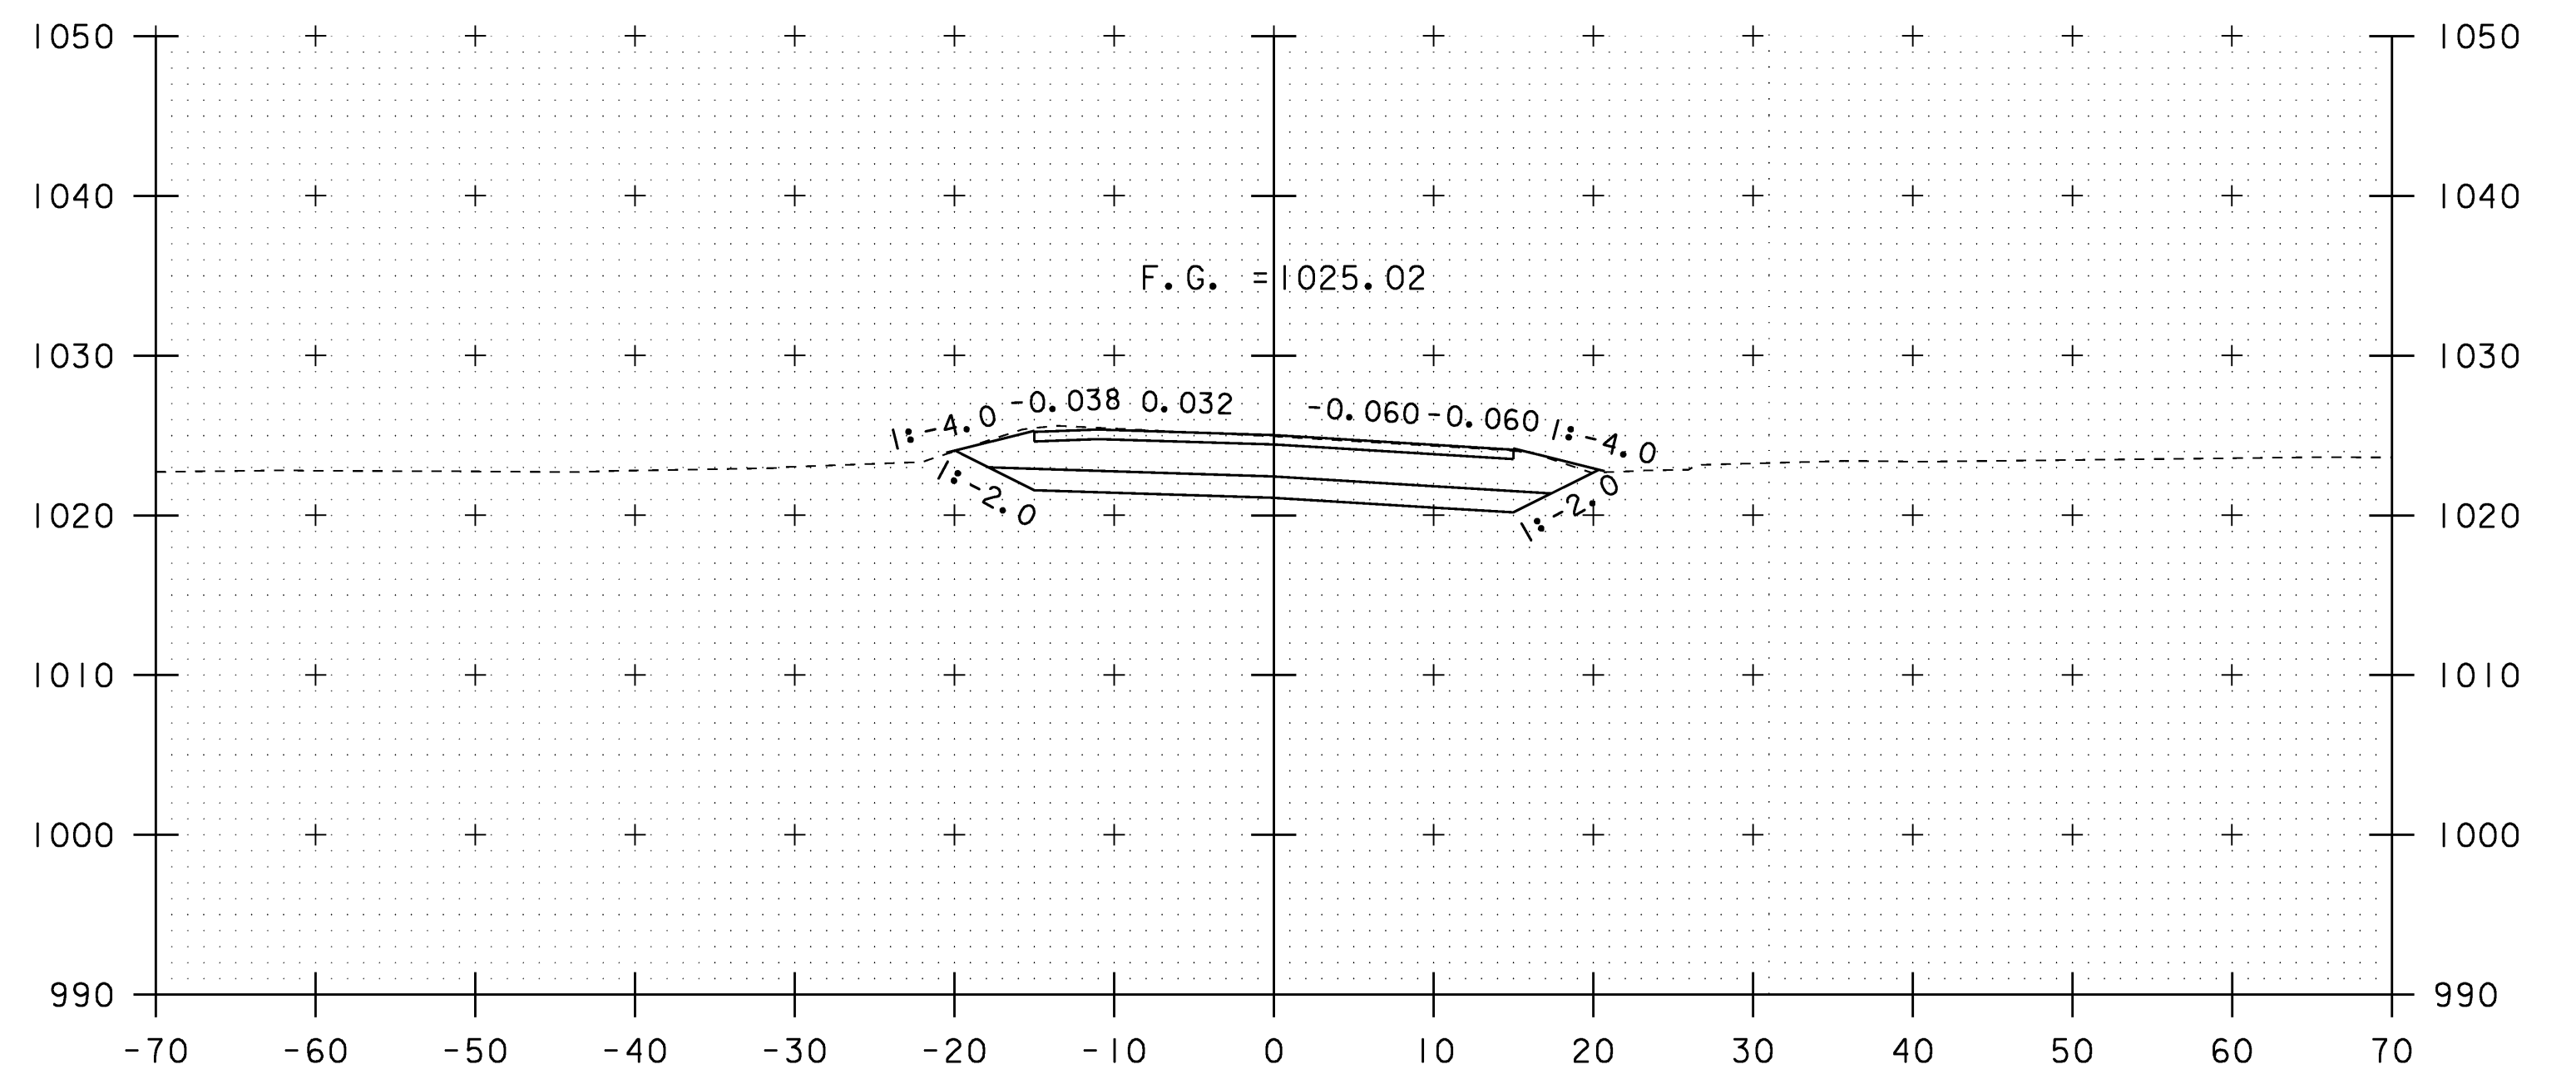

58+75

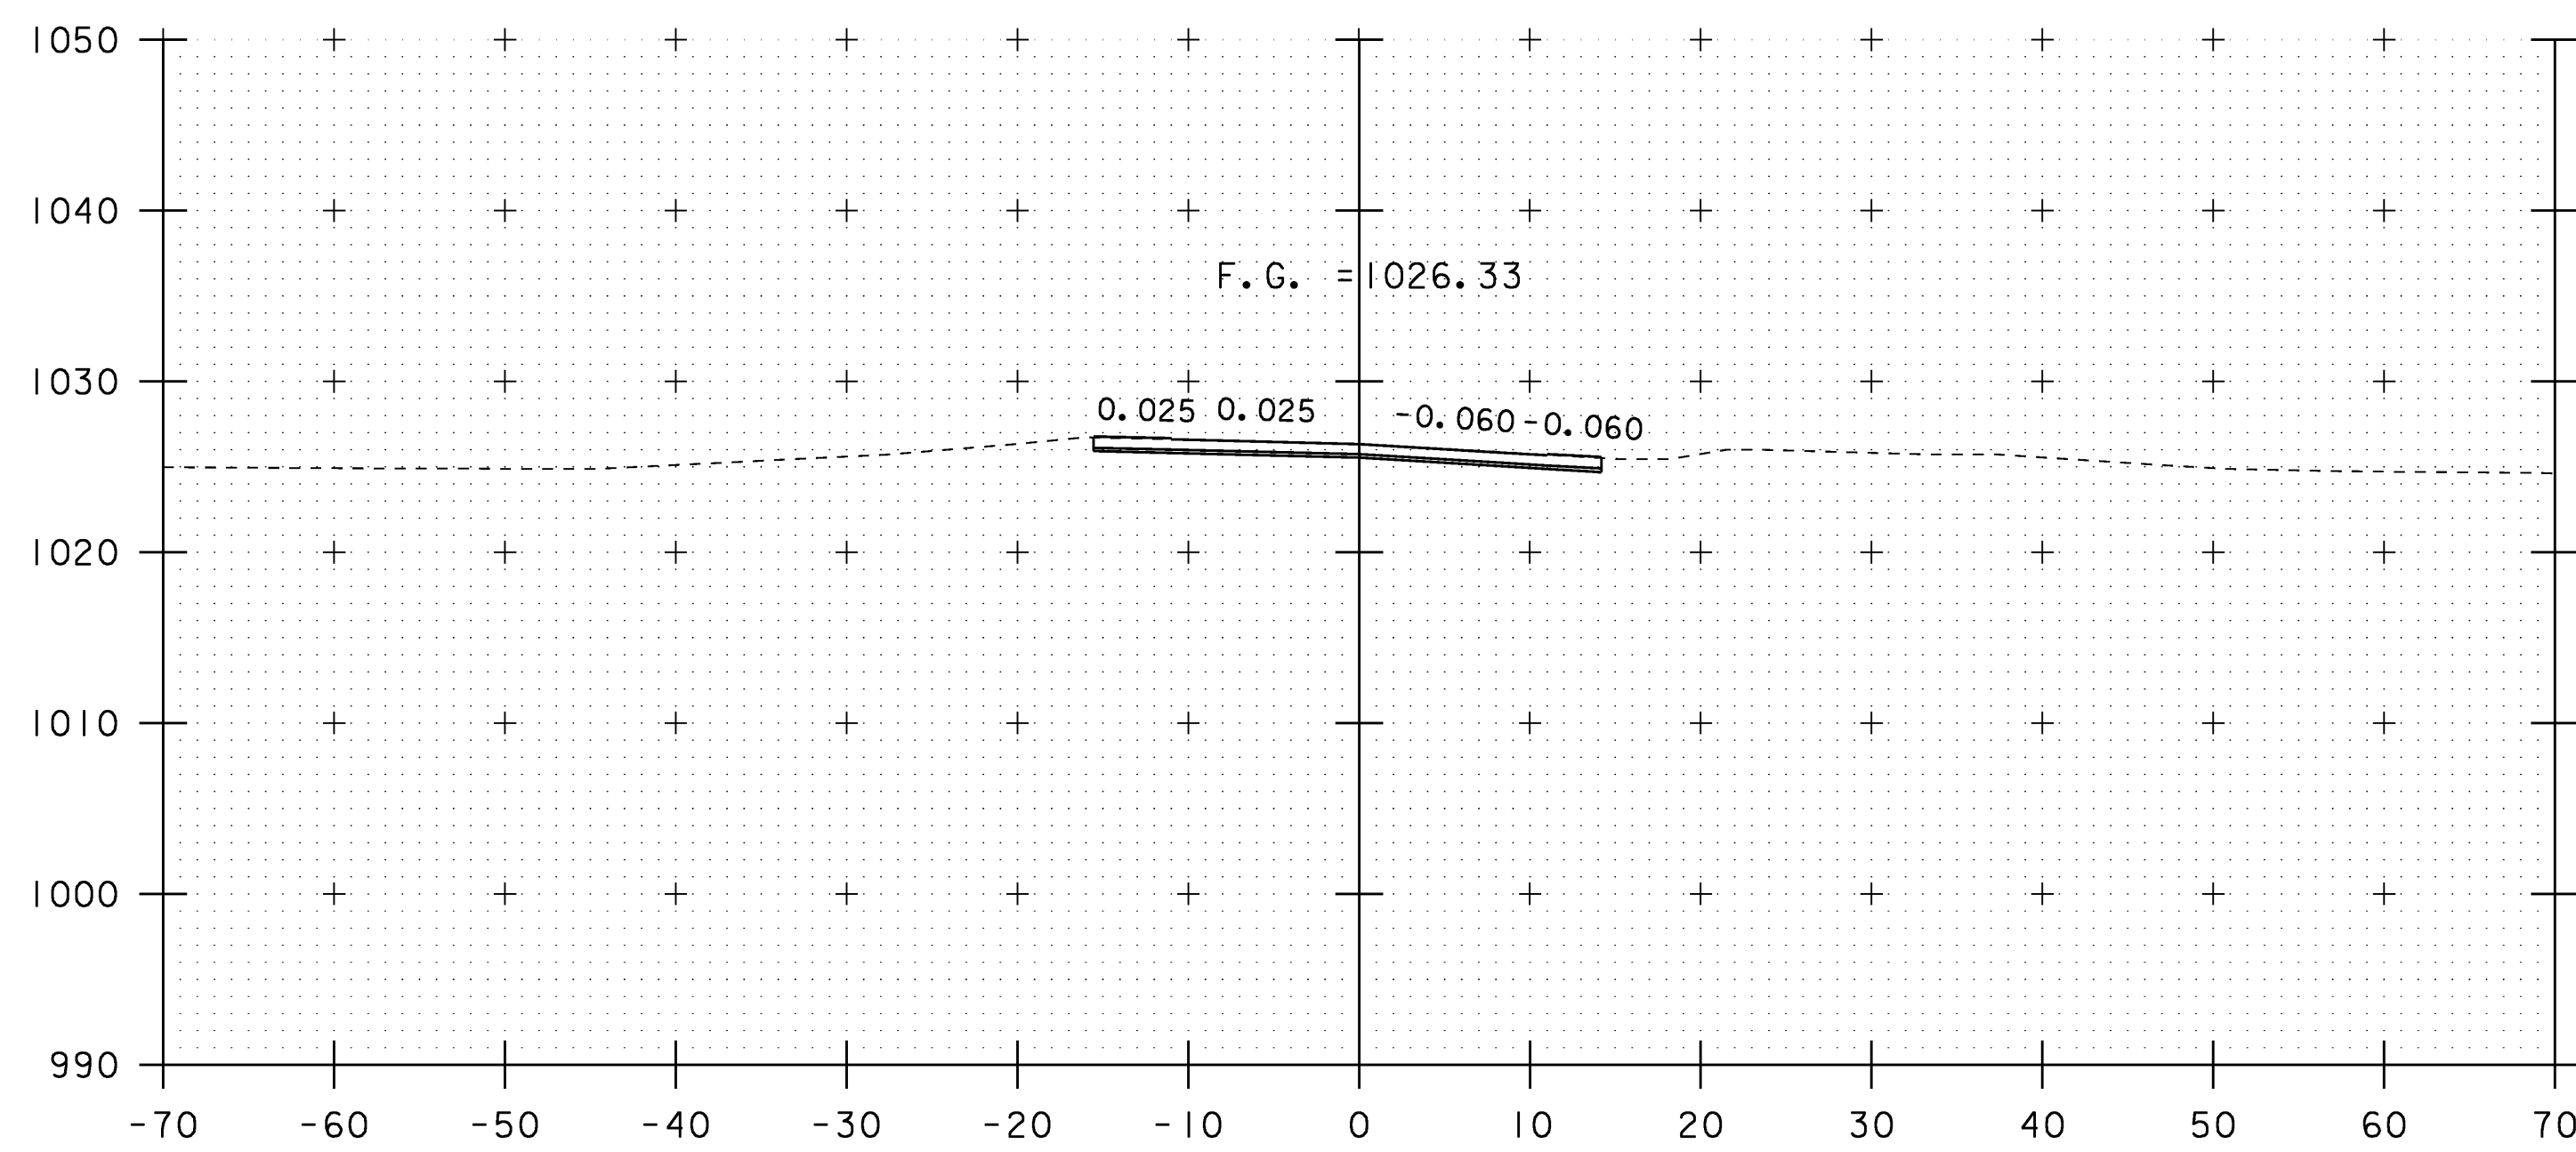


58+09

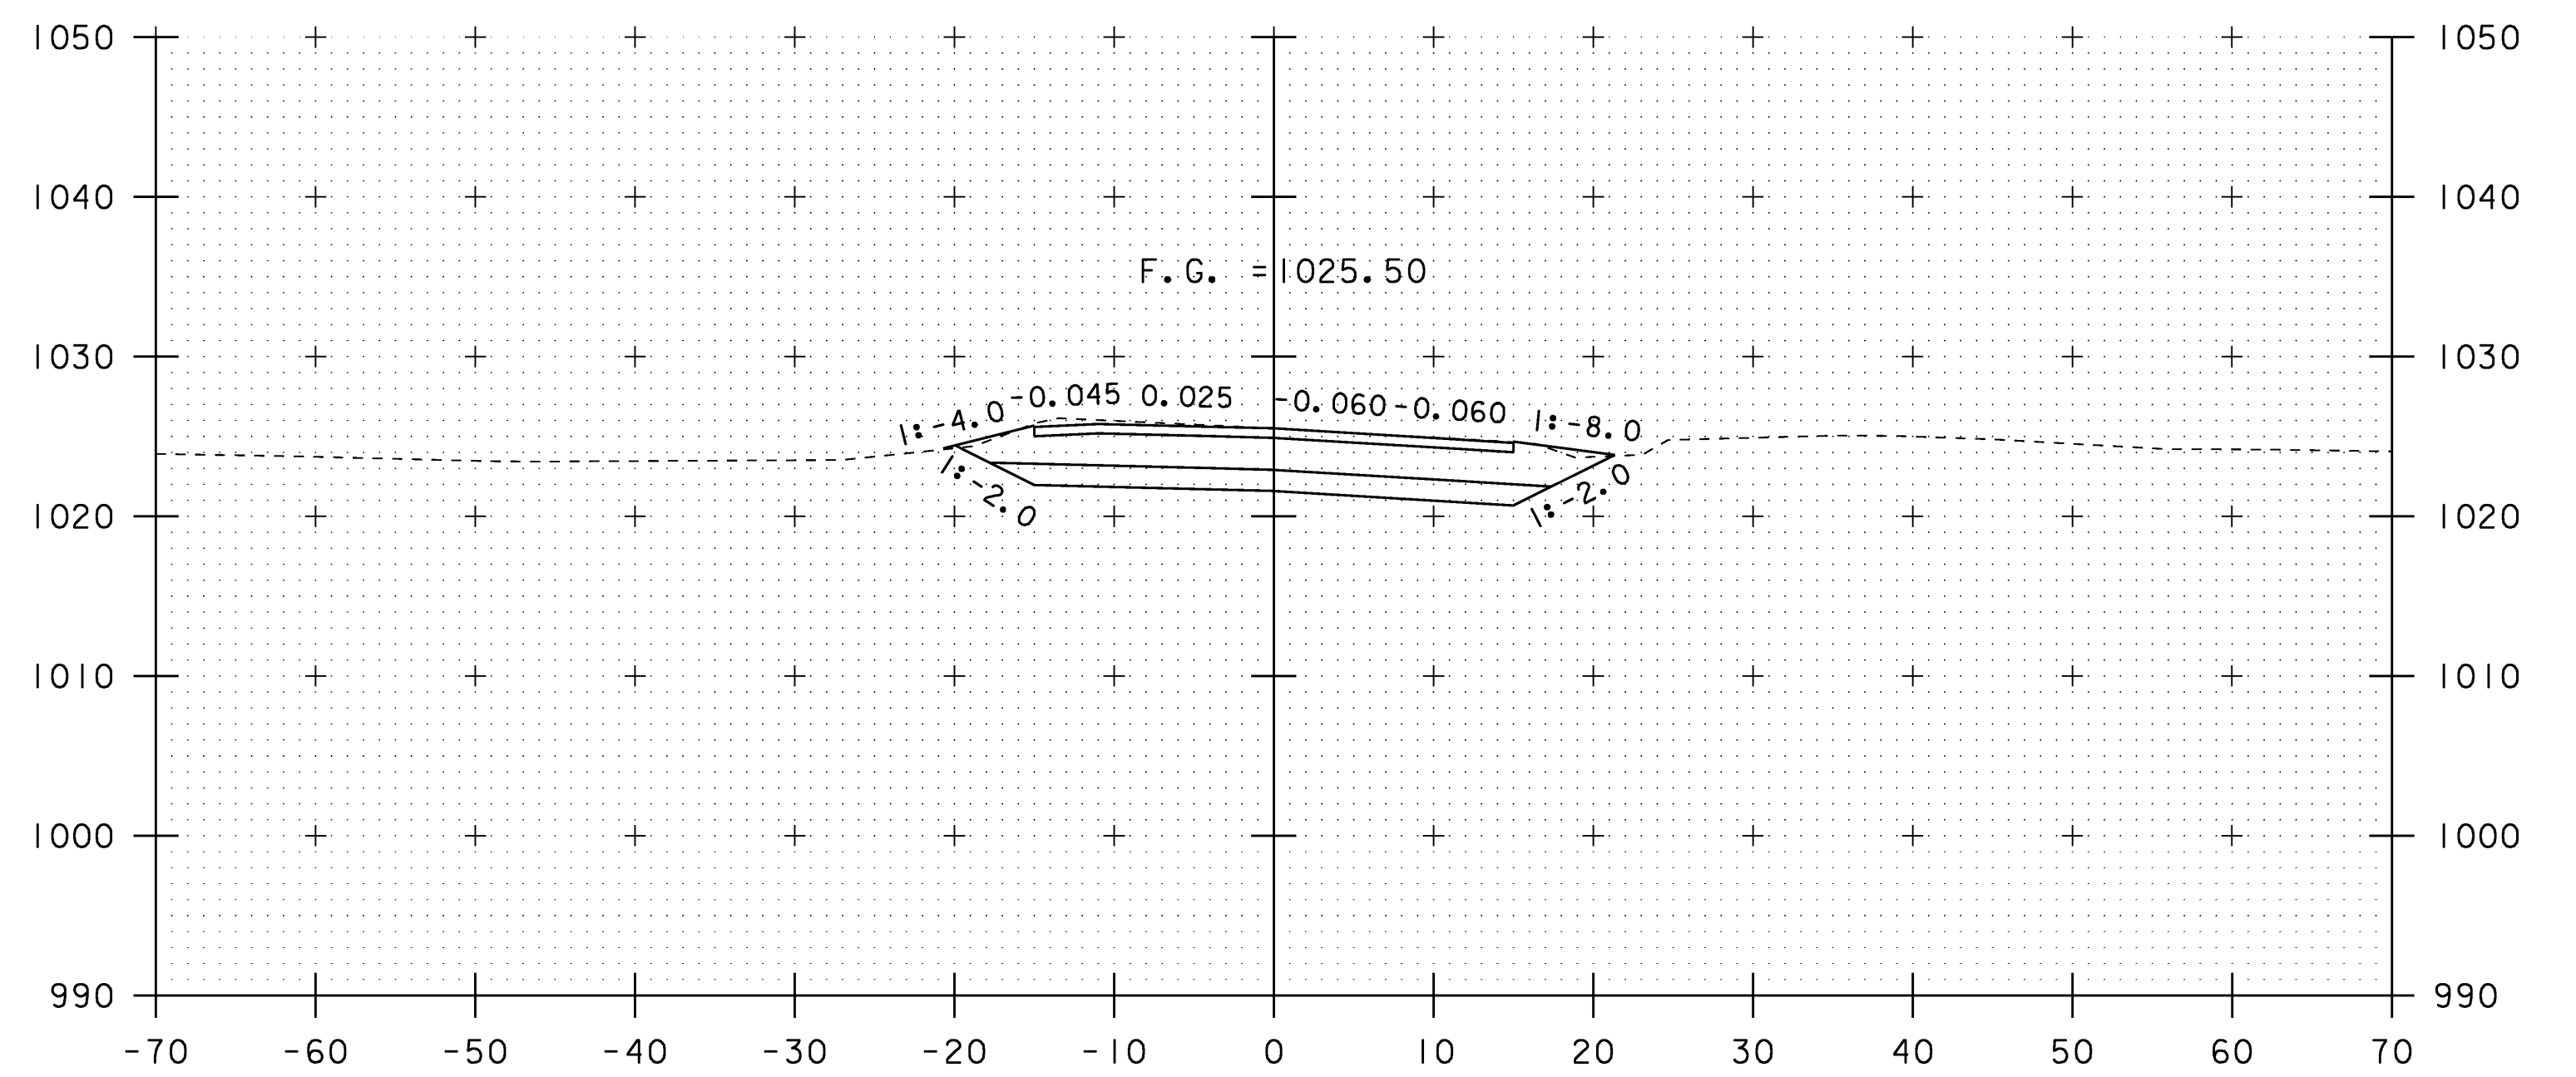

STA. 58+50
END APPROACH
BEGIN PROJECT

58+50

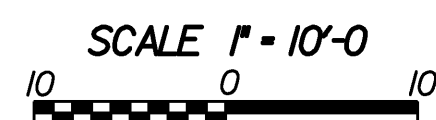

VT 102 CROSS SECTIONS (2)

PROJECT NAME:	CANAAN		
PROJECT NUMBER:	ER ST 0271(16)		
FILE NAME:	/str2/04c098/x04c098bdr.dgn	PLOT DATE:	18-AUG-2008
PROJECT LEADER:	EVANS-MONGEON	DRAWN BY:	HUSK
DESIGNED BY:	SCRIBNER	CHECKED BY:	SCRIBNER
x04c098rxs2.1		SHEET 53	OF 66