


59+75



59+50

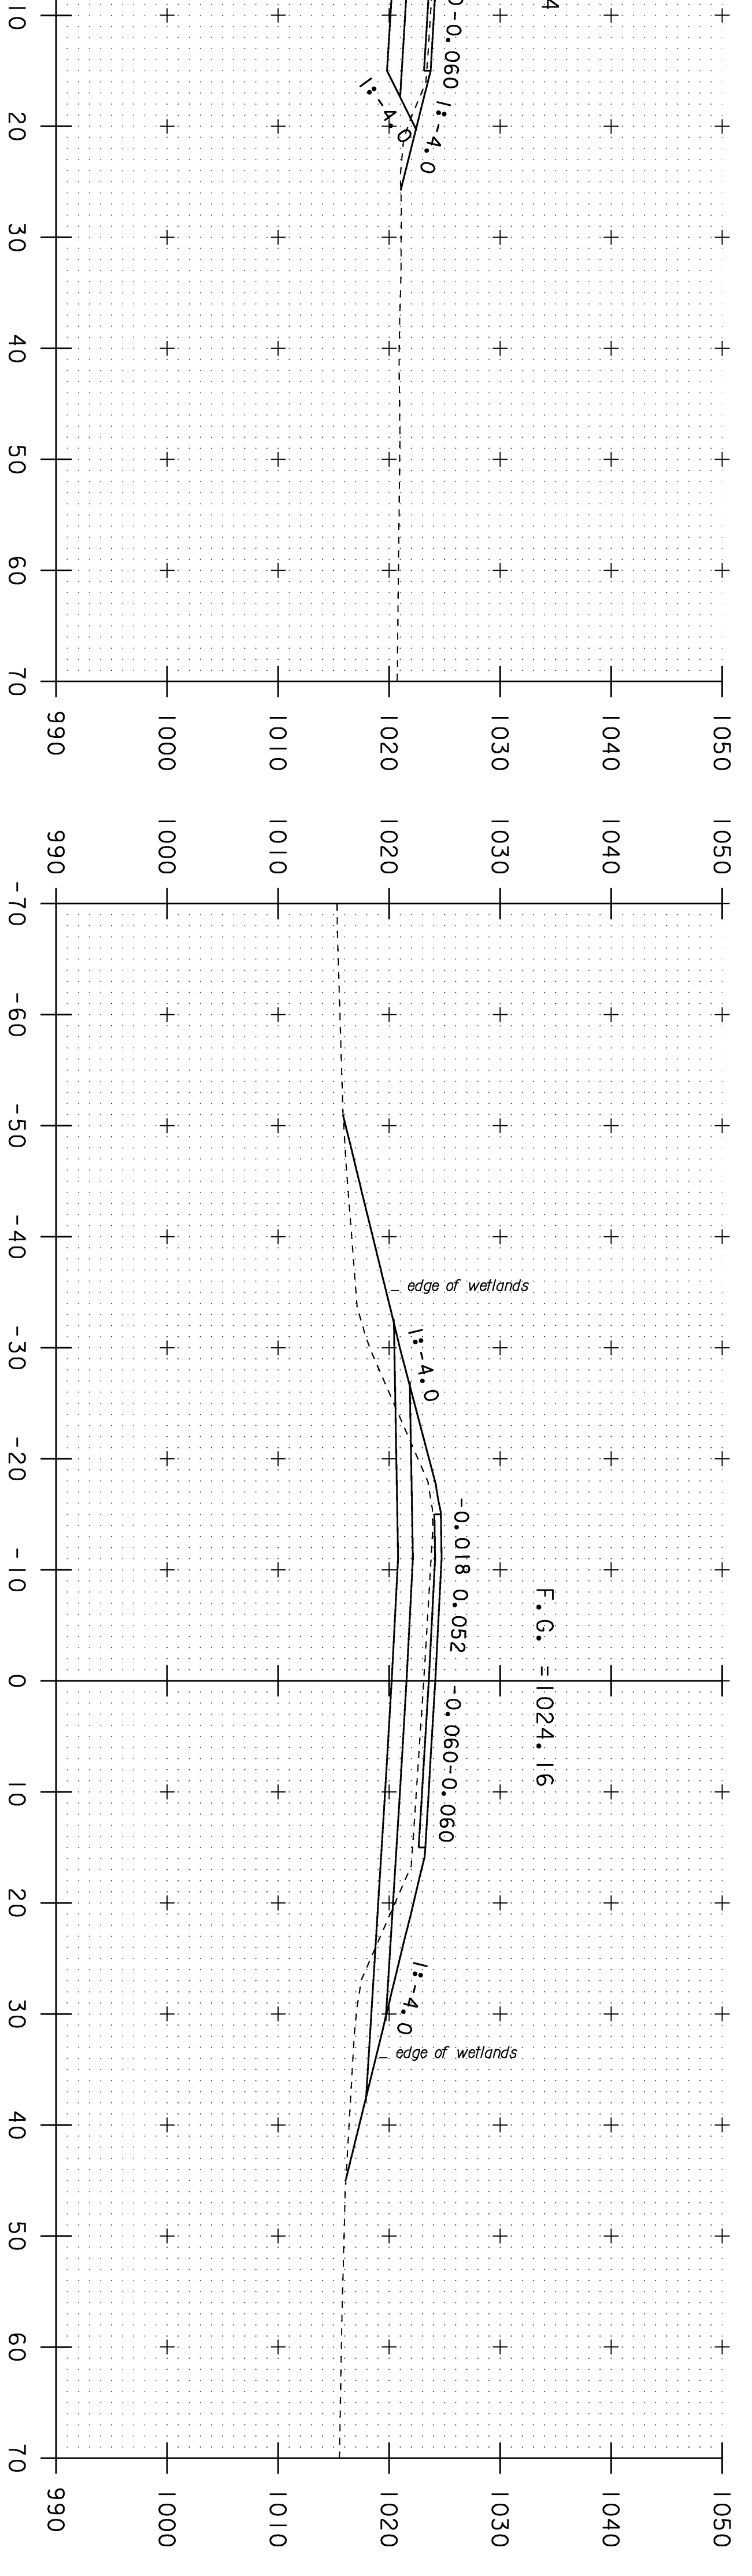

**VT 102 CROSS SECTIONS (3)**

PROJECT NAME:	CANAAN	PROJECT NUMBER:	ER ST 0271(16)
FILE NAME:	/sfr2/040098/x040098bdr.dgn	PLOT DATE:	18-AUG-2008
PROJECT LEADER:	EVANS-MONGEON	DRAWN BY:	HUSK
DESIGNED BY:	SCRIBNER	CHECKED BY:	SCRIBNER
X040098-XS31		SHEET 54	OF 66