




60+25

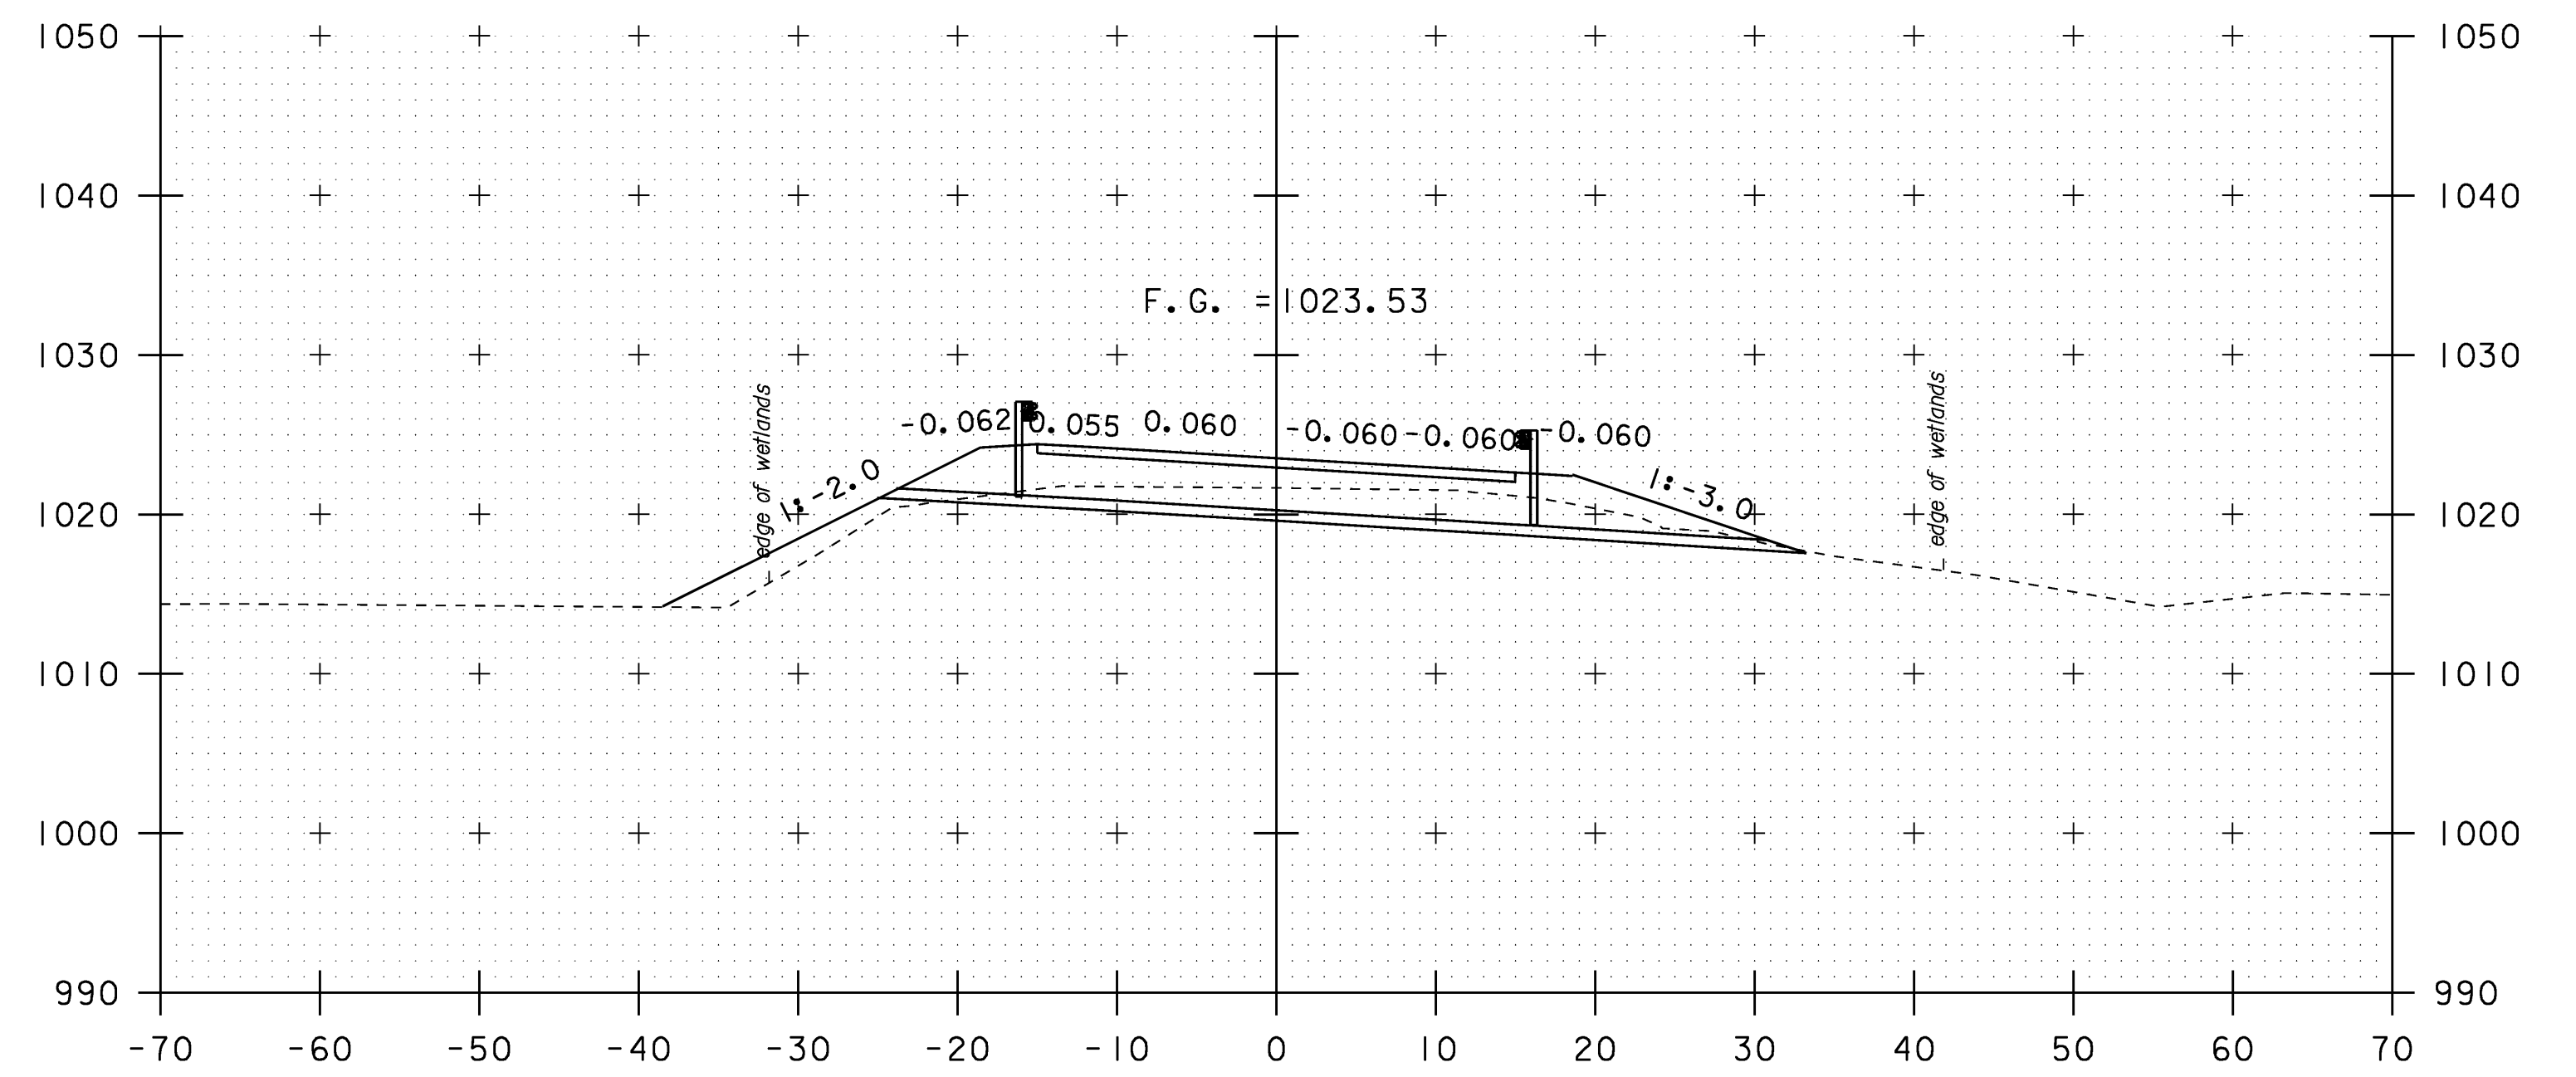


60+75

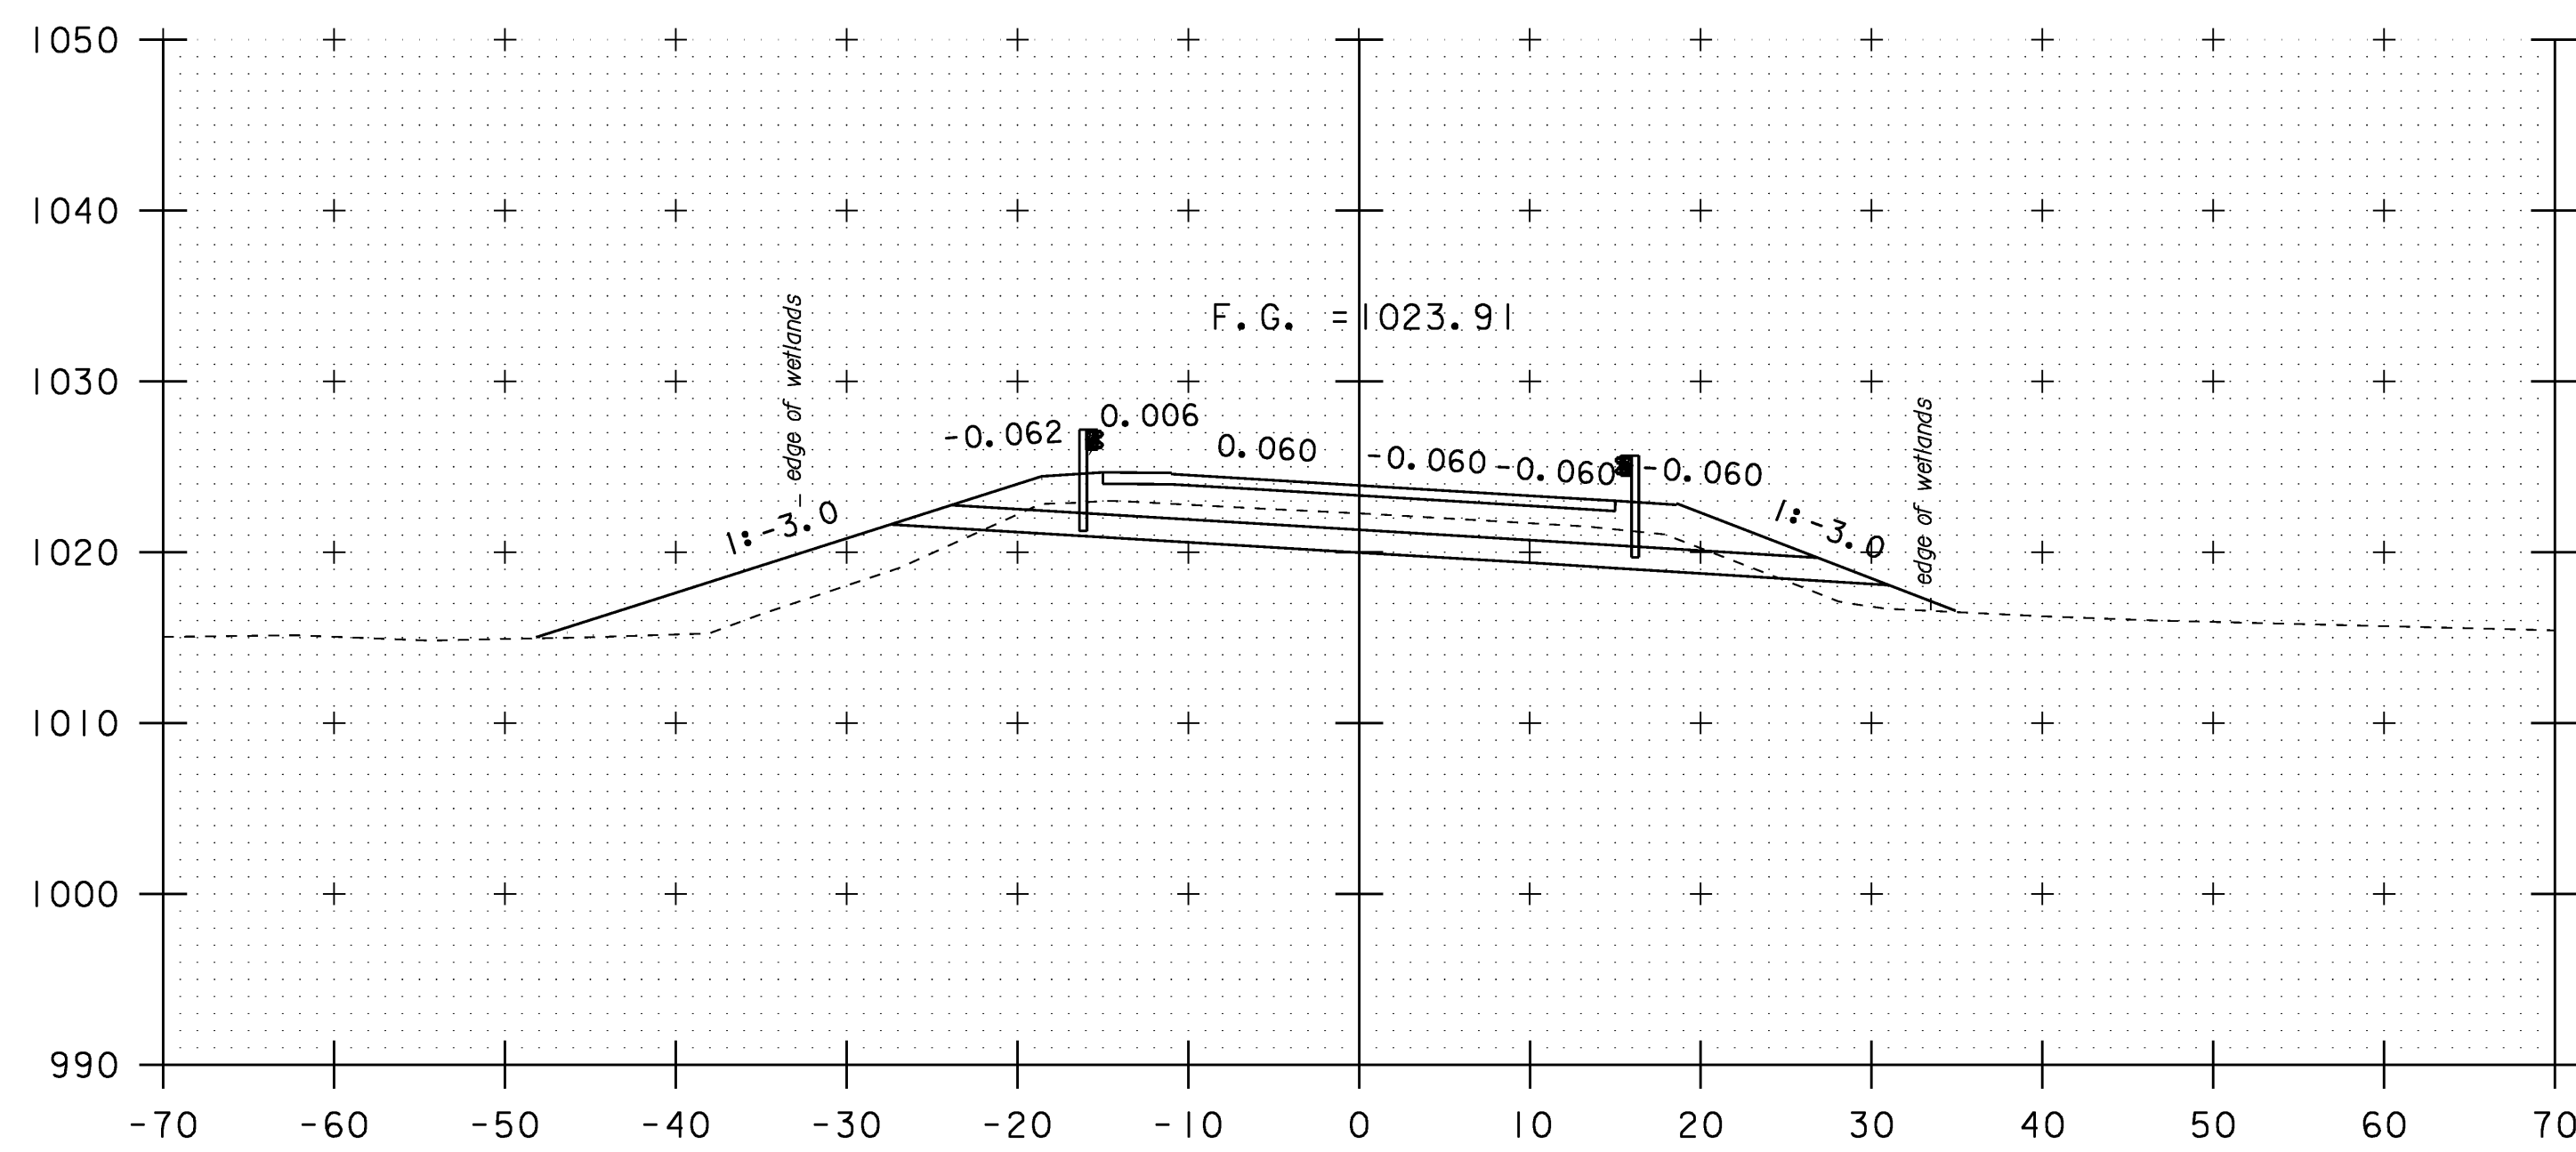

60+00

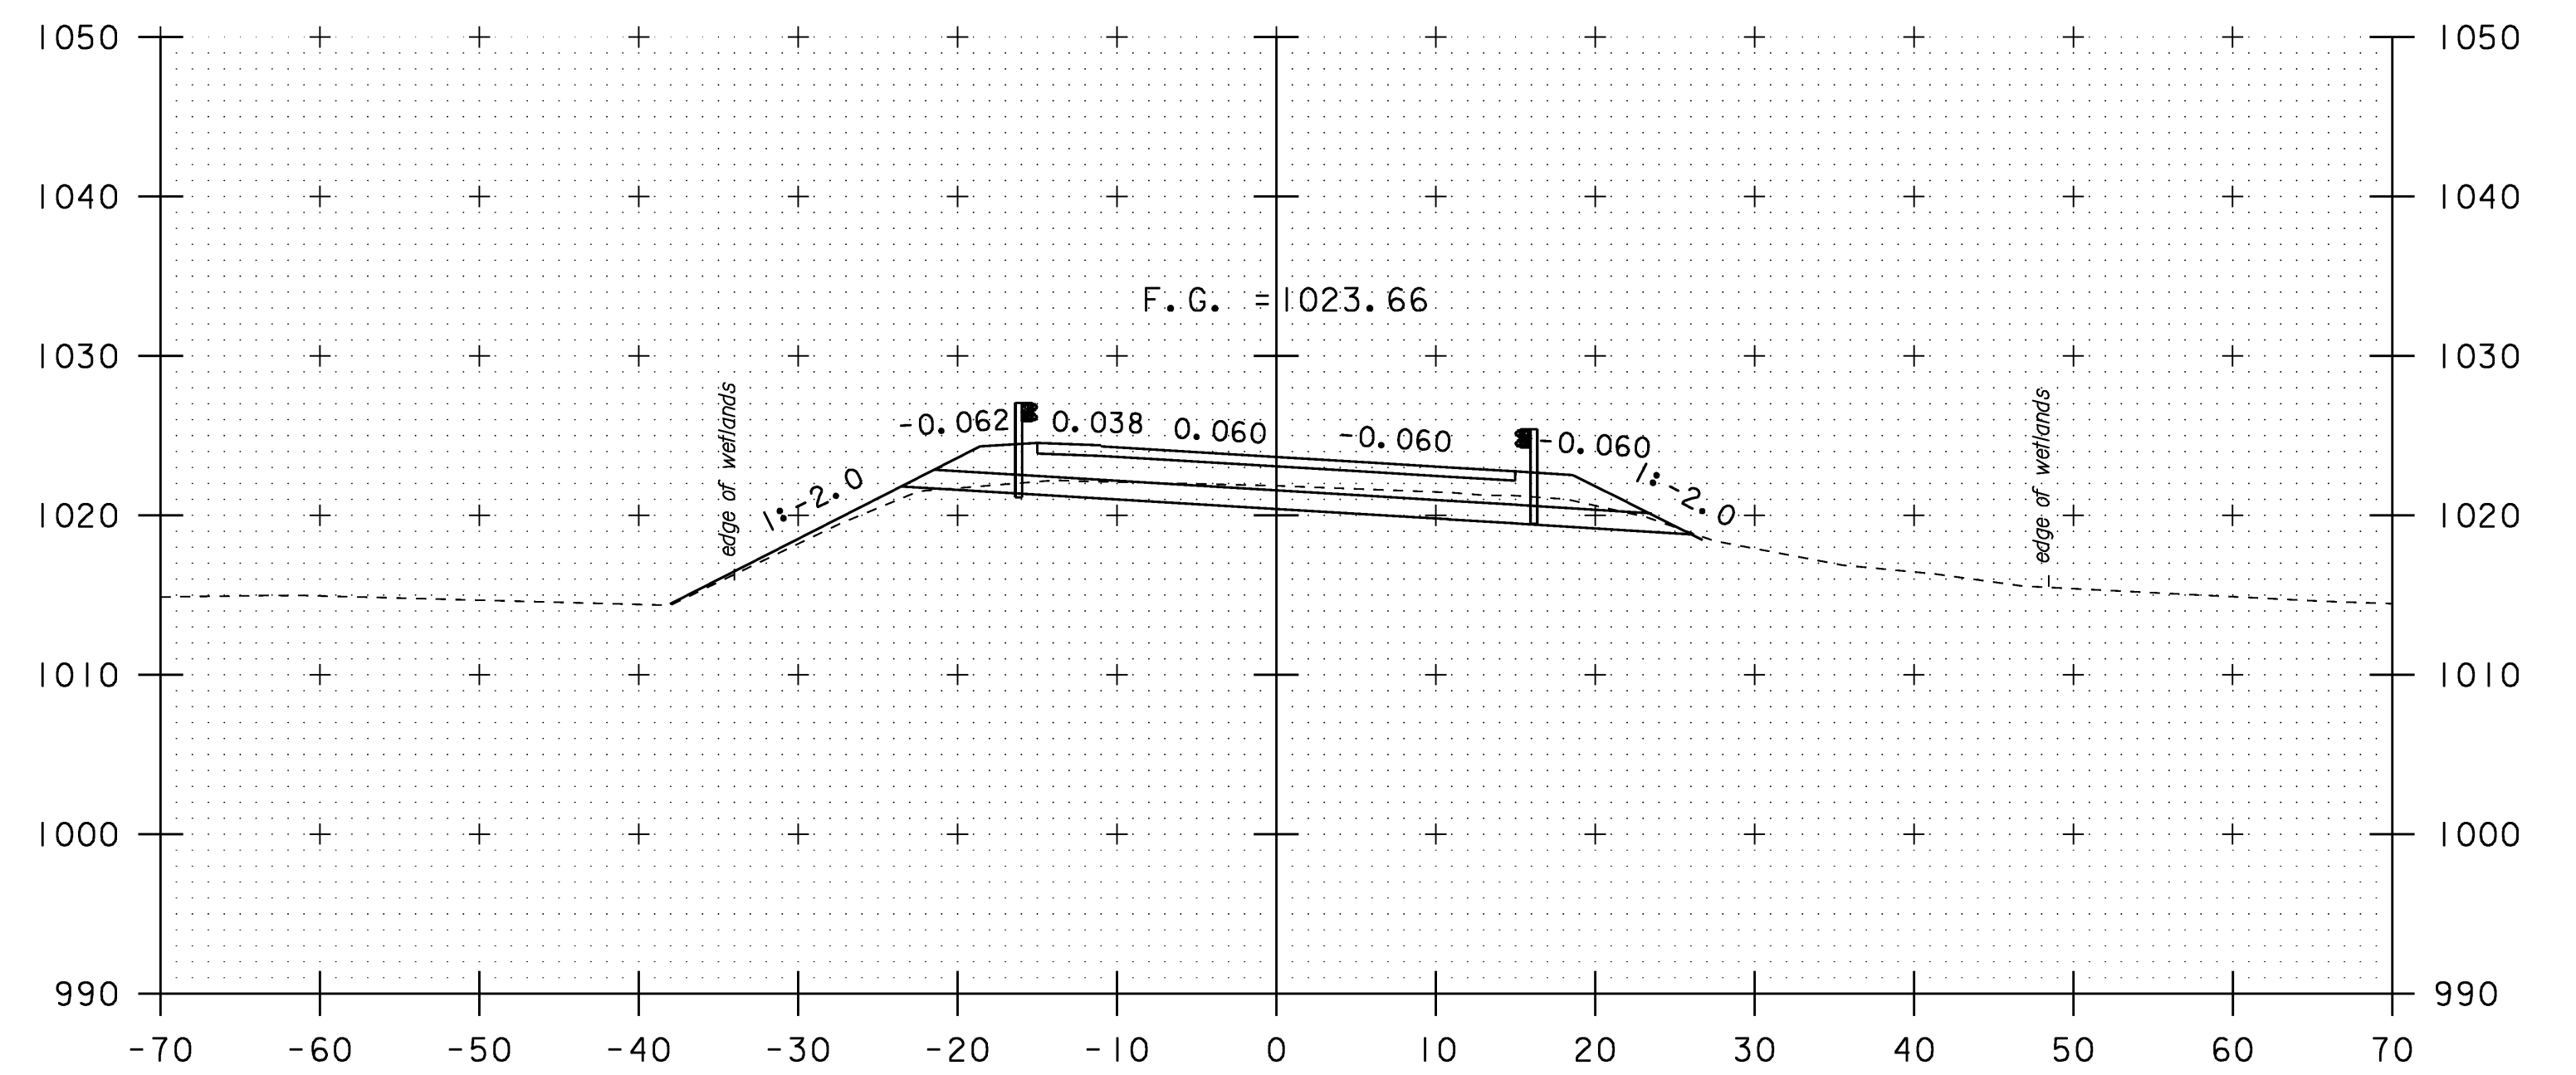

60+50

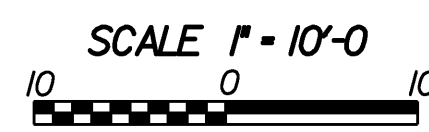

**VT 102 CROSS SECTIONS (4)**

PROJECT NAME:	CANAAN		
PROJECT NUMBER:	ER ST 0271(16)		
FILE NAME:	/str2/04c098/x04c098bdr.dgn	PLOT DATE:	18-AUG-2008
PROJECT LEADER:	EVANS-MONGEON	DRAWN BY:	HUSK
DESIGNED BY:	SCRIBNER	CHECKED BY:	SCRIBNER
x04c098rxs4.1		SHEET 55	OF 66