



61+00

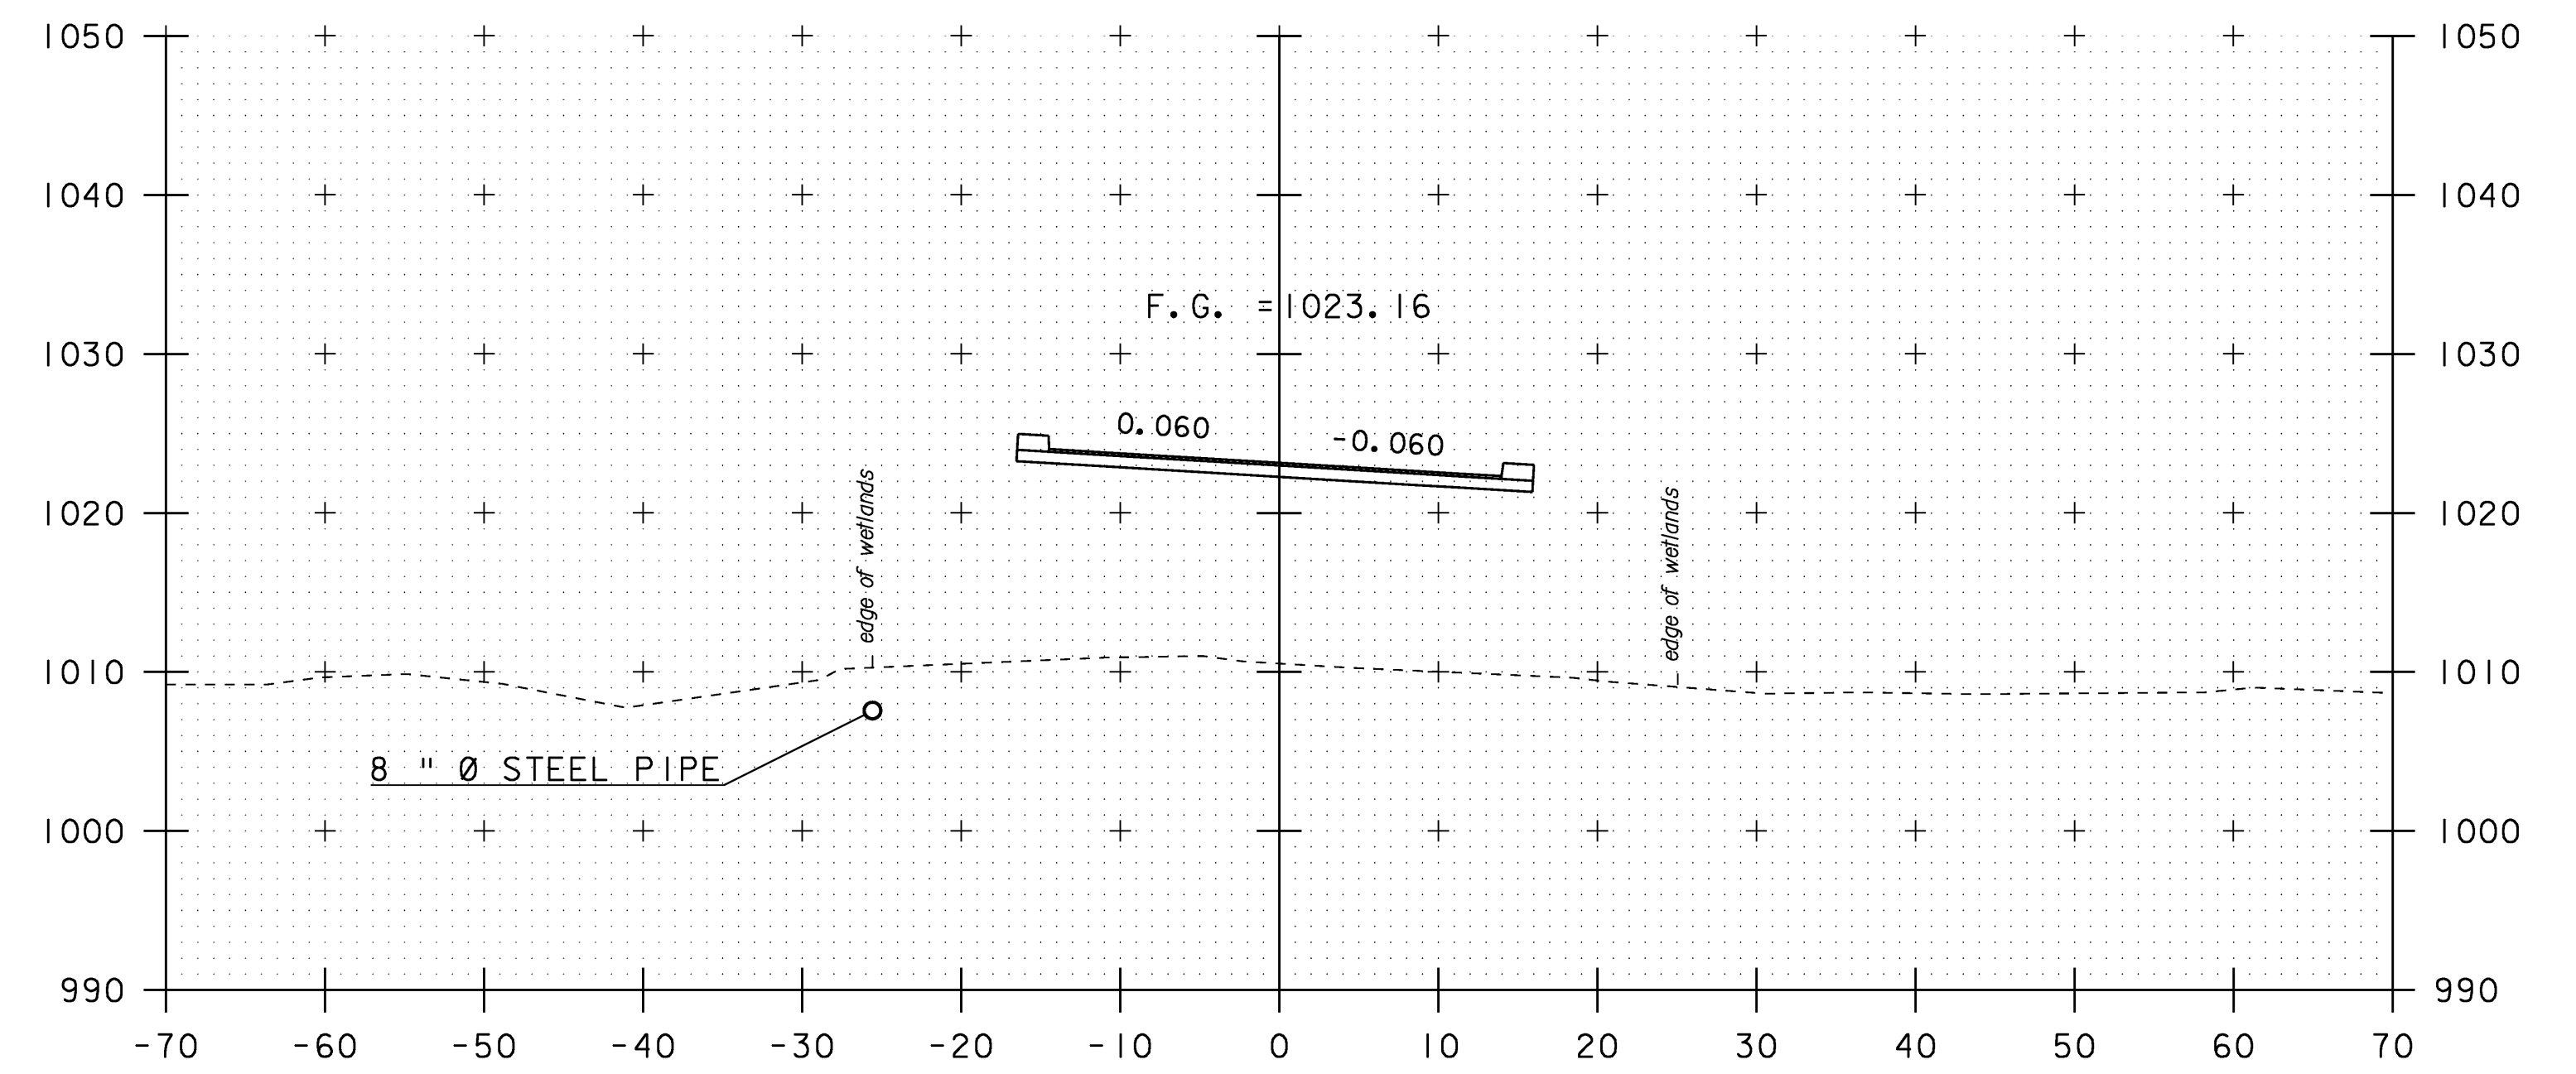


STA. 61+34 LT  
BEGIN DRY HYDRANT

61+50

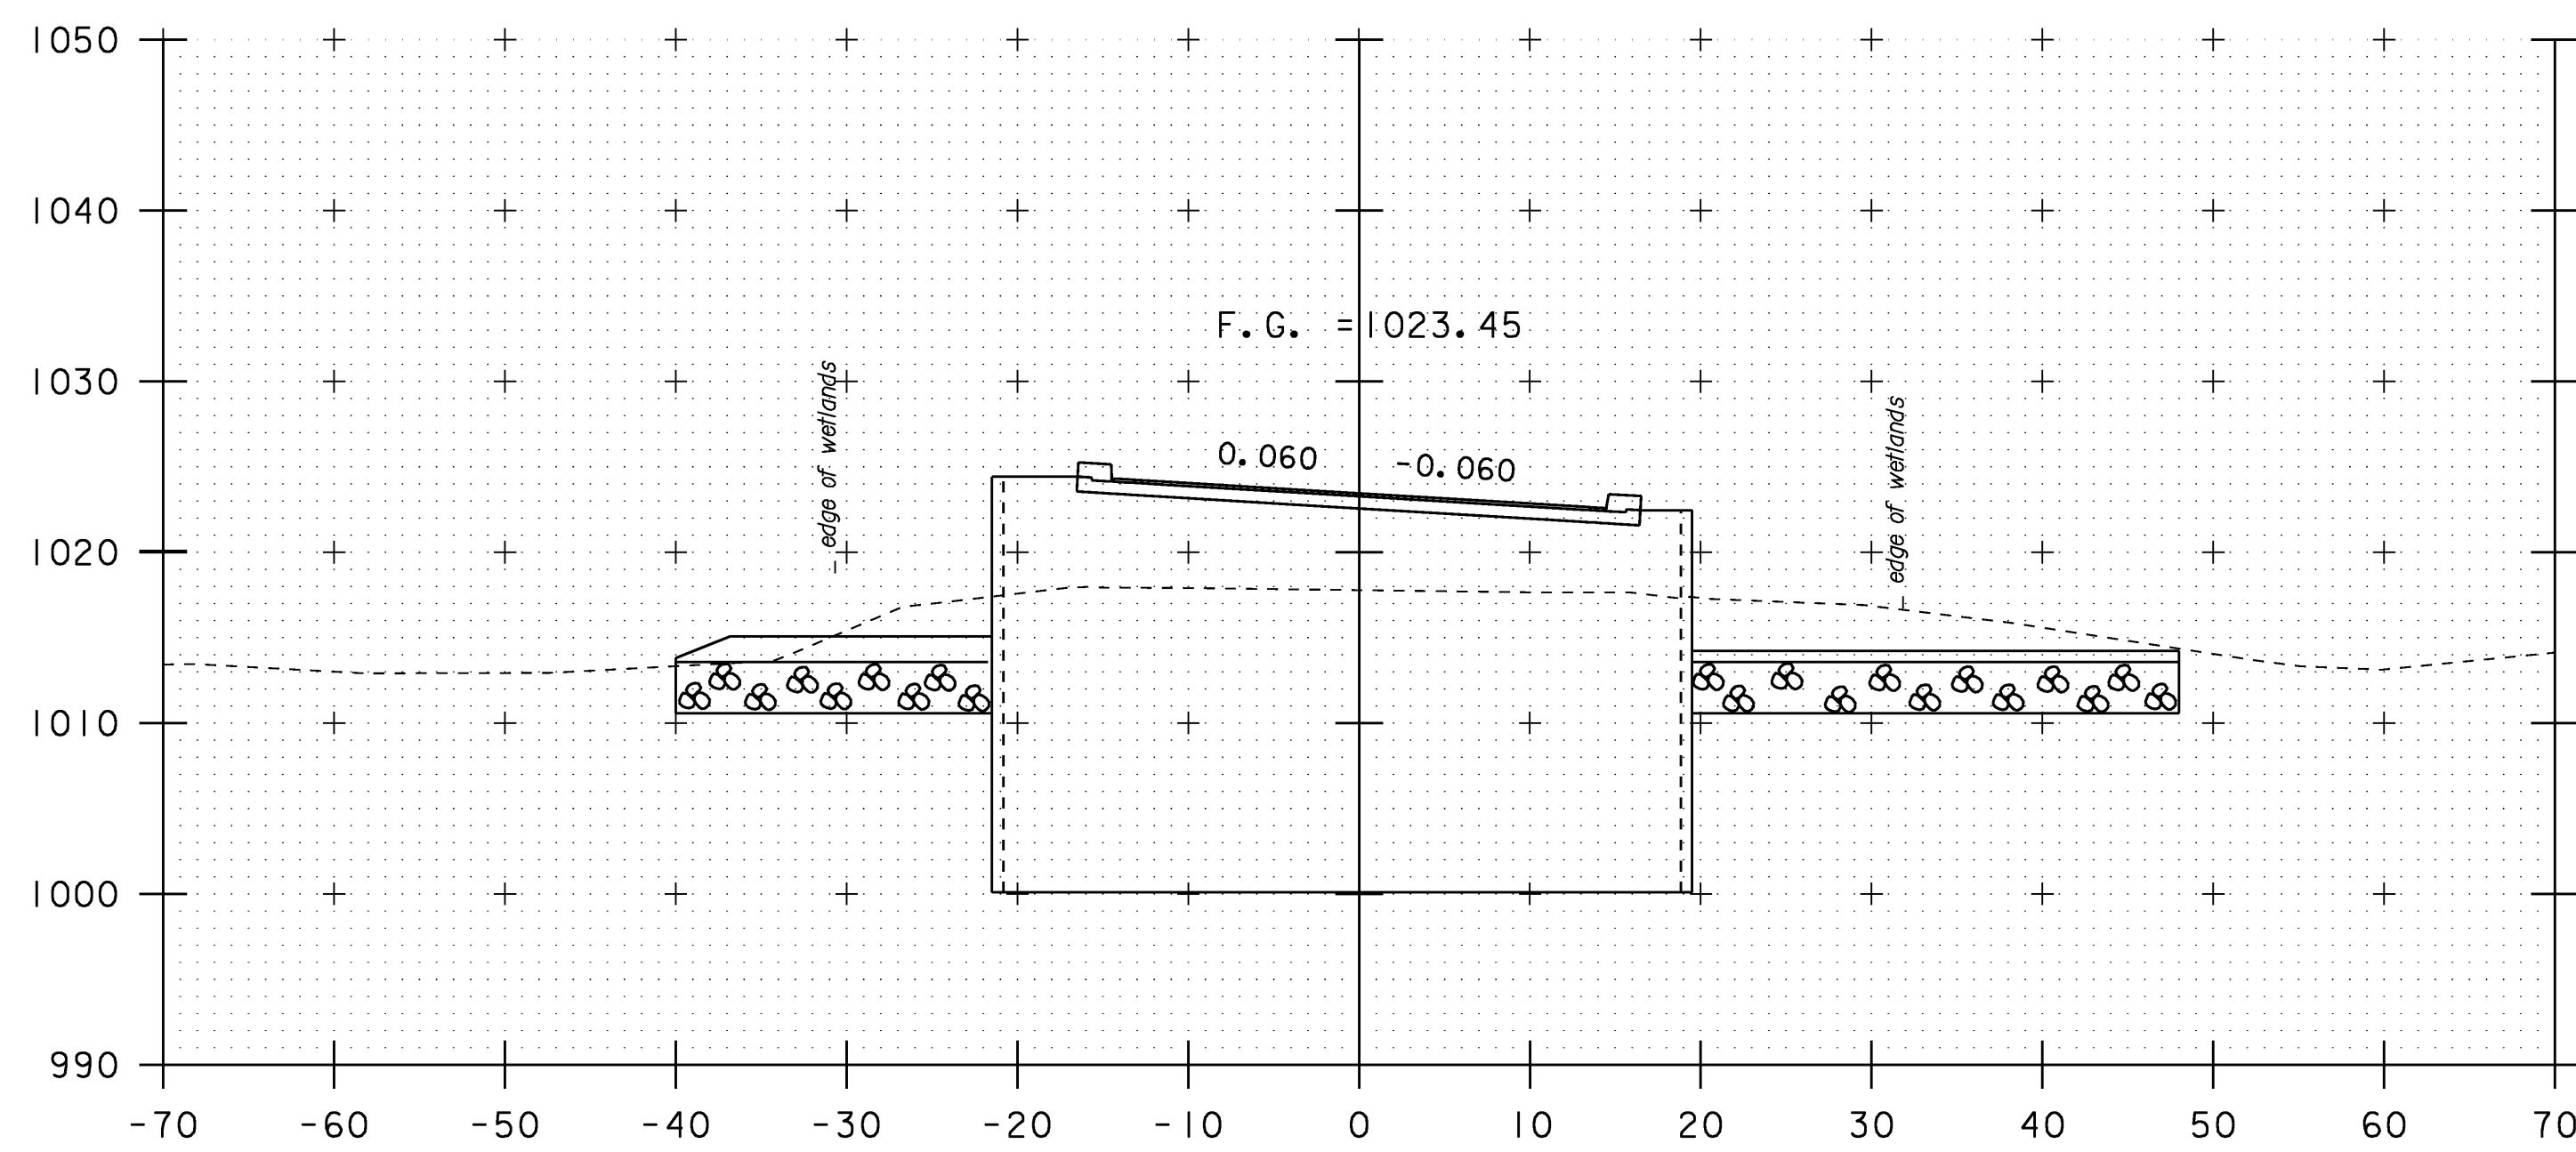


STA. 60+92  
BEGIN BRIDGE

60+93

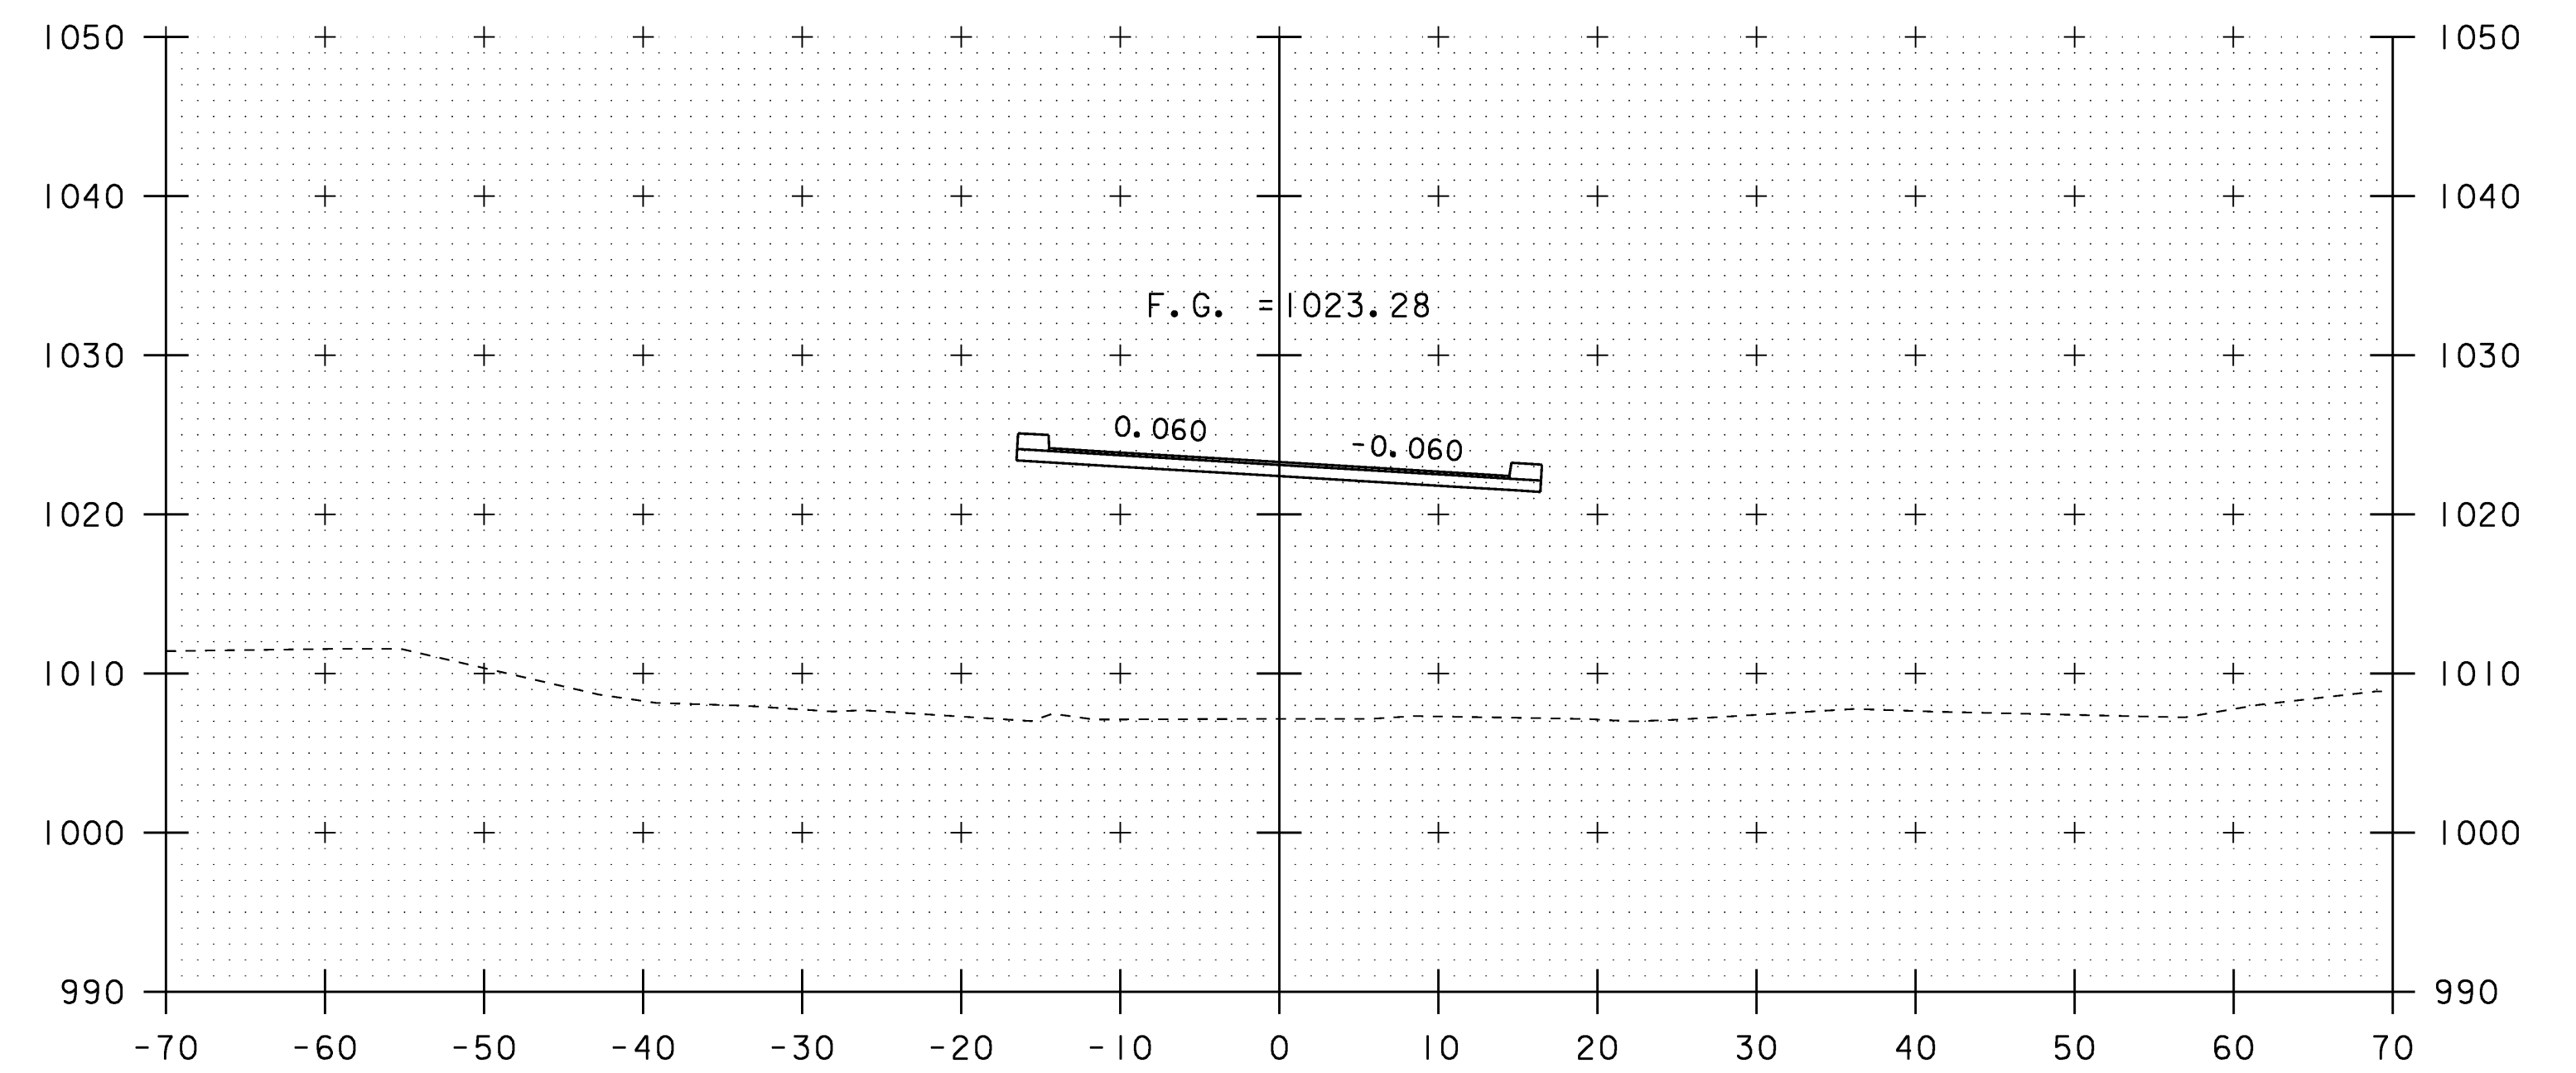

61+25

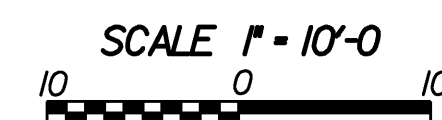

**VT 102 CROSS SECTIONS (5)**

PROJECT NAME:	CANAAN		
PROJECT NUMBER:	ER ST 0271(16)		
FILE NAME:	/str2/04c098/x04c098bdr.dgn	PLOT DATE:	18-AUG-2008
PROJECT LEADER:	EVANS-MONGEON	DRAWN BY:	HUSK
DESIGNED BY:	SCRIBNER	CHECKED BY:	SCRIBNER
x04c098rxs5.1		SHEET 56	OF 66