



63+75

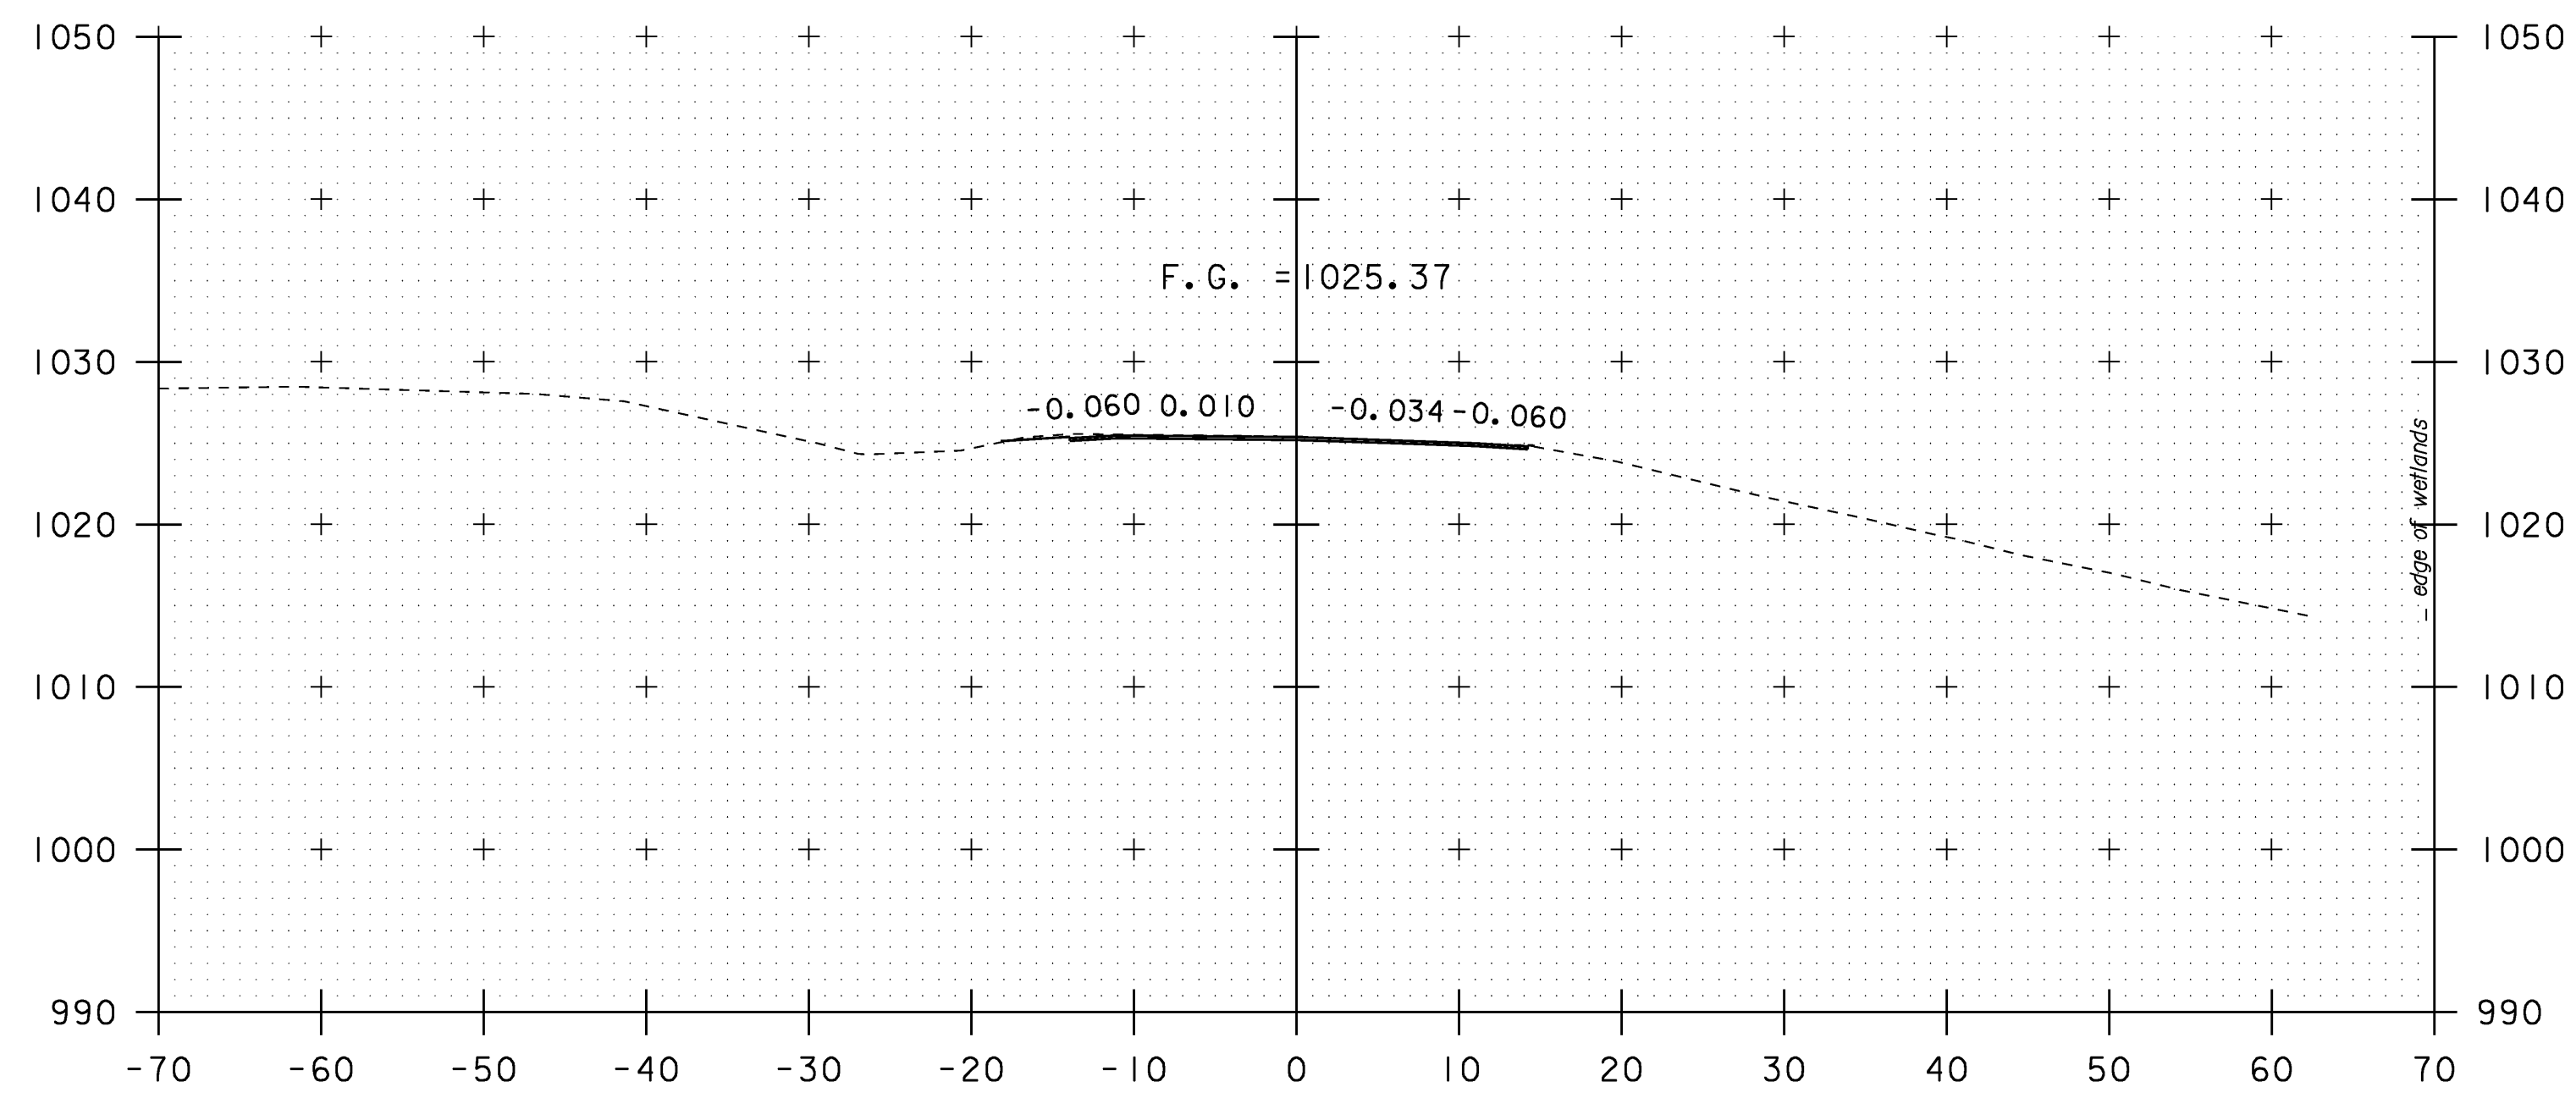


64+00

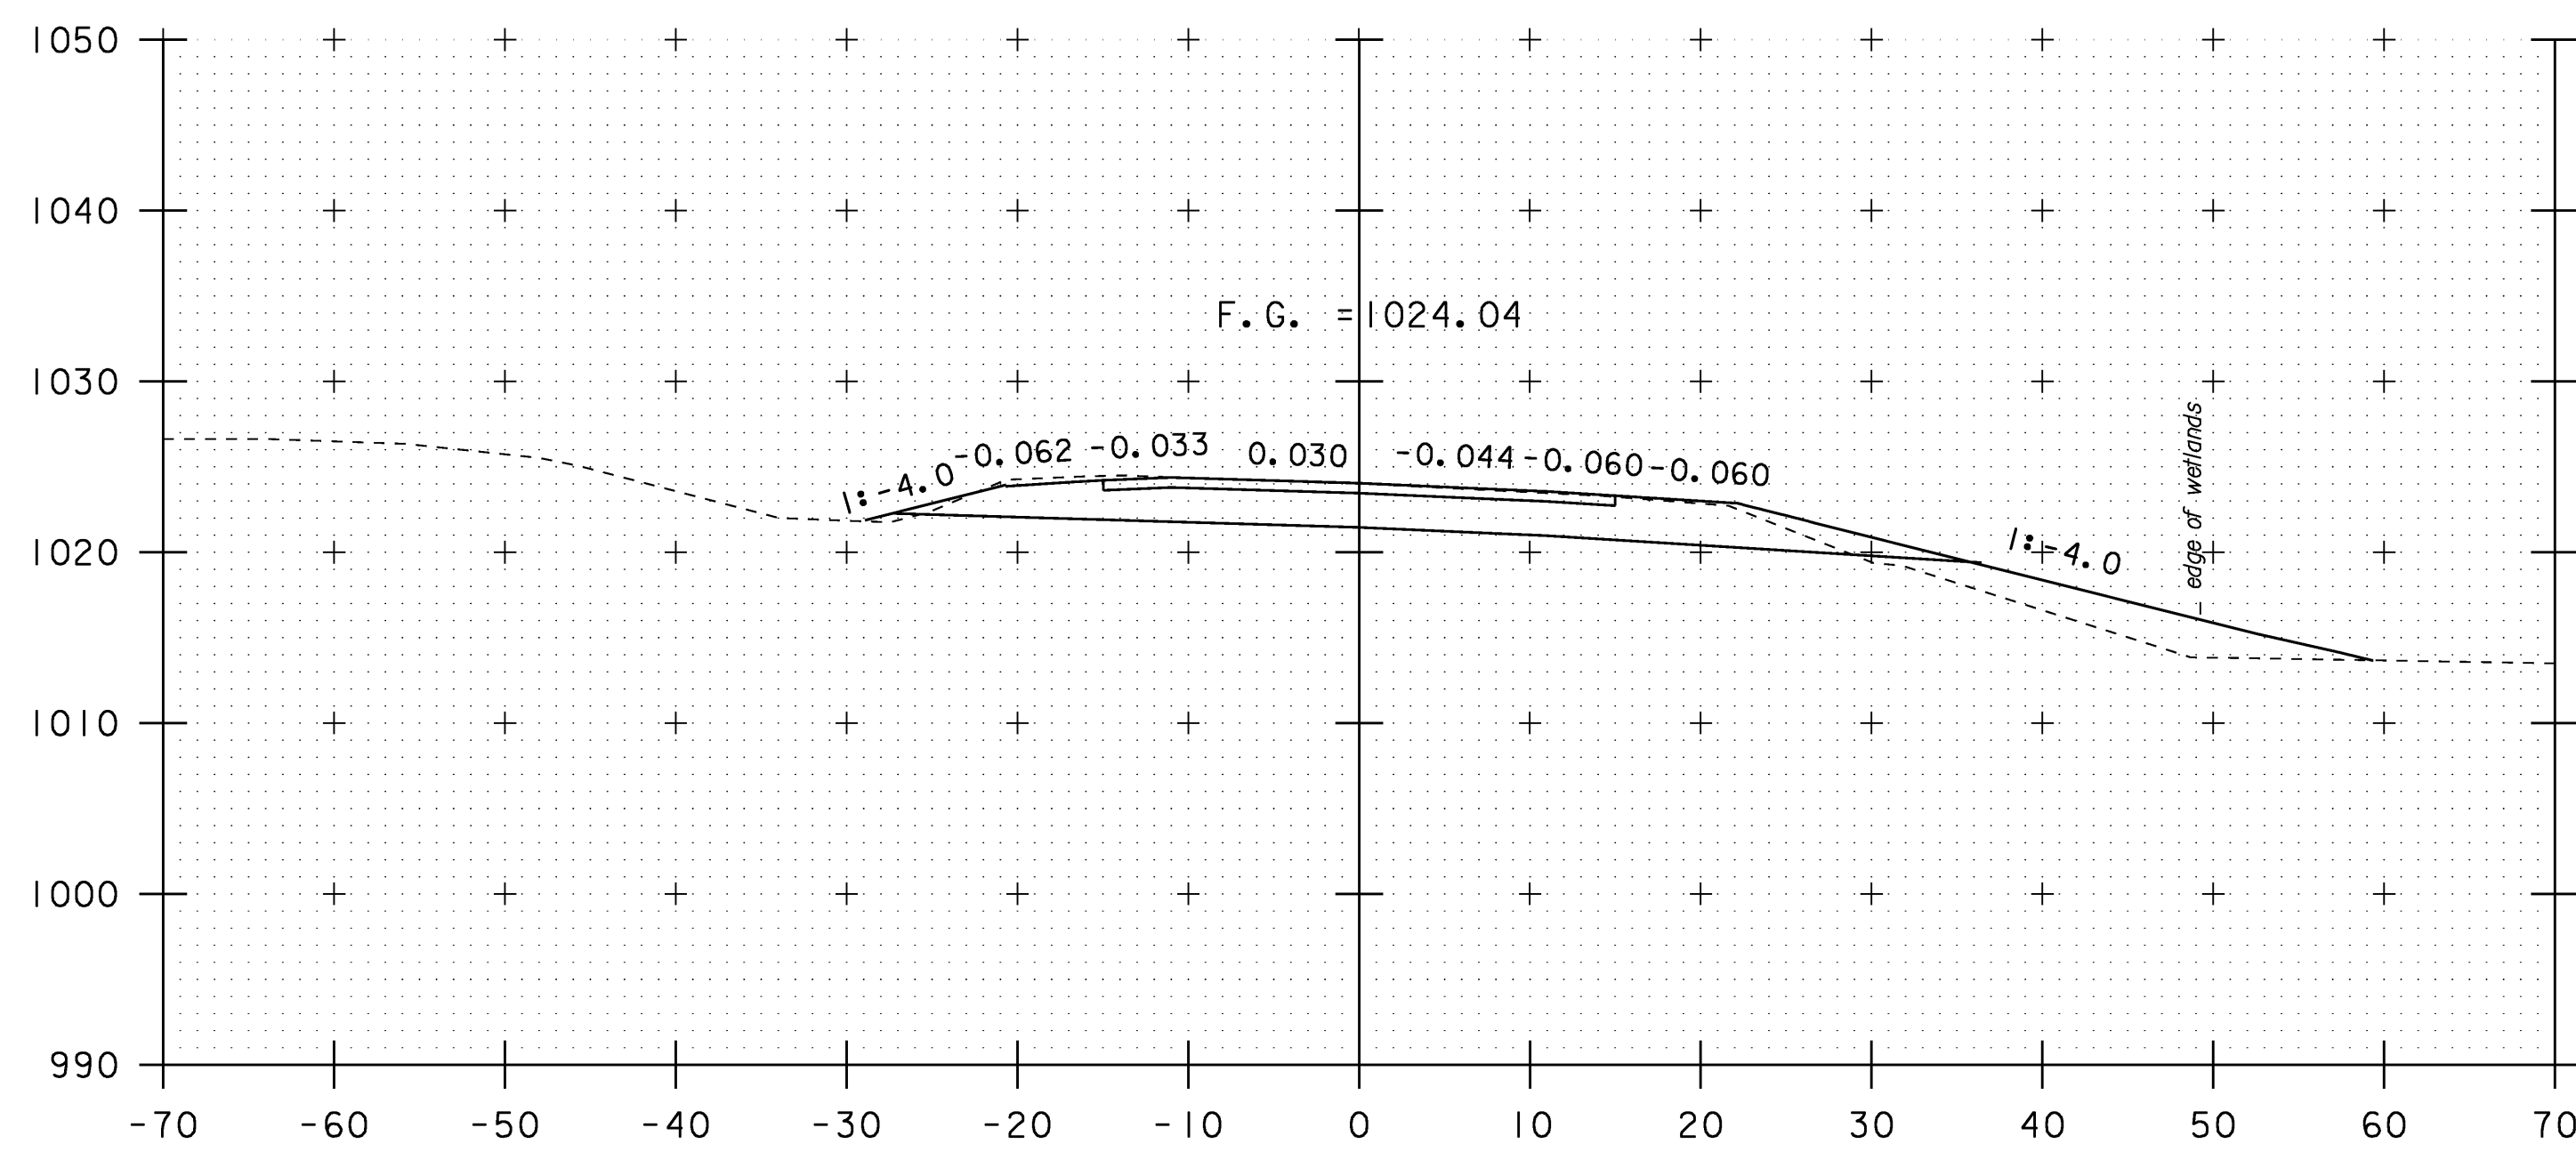


63+50

STA. 63+50
END PROJECT
BEGIN APPROACH

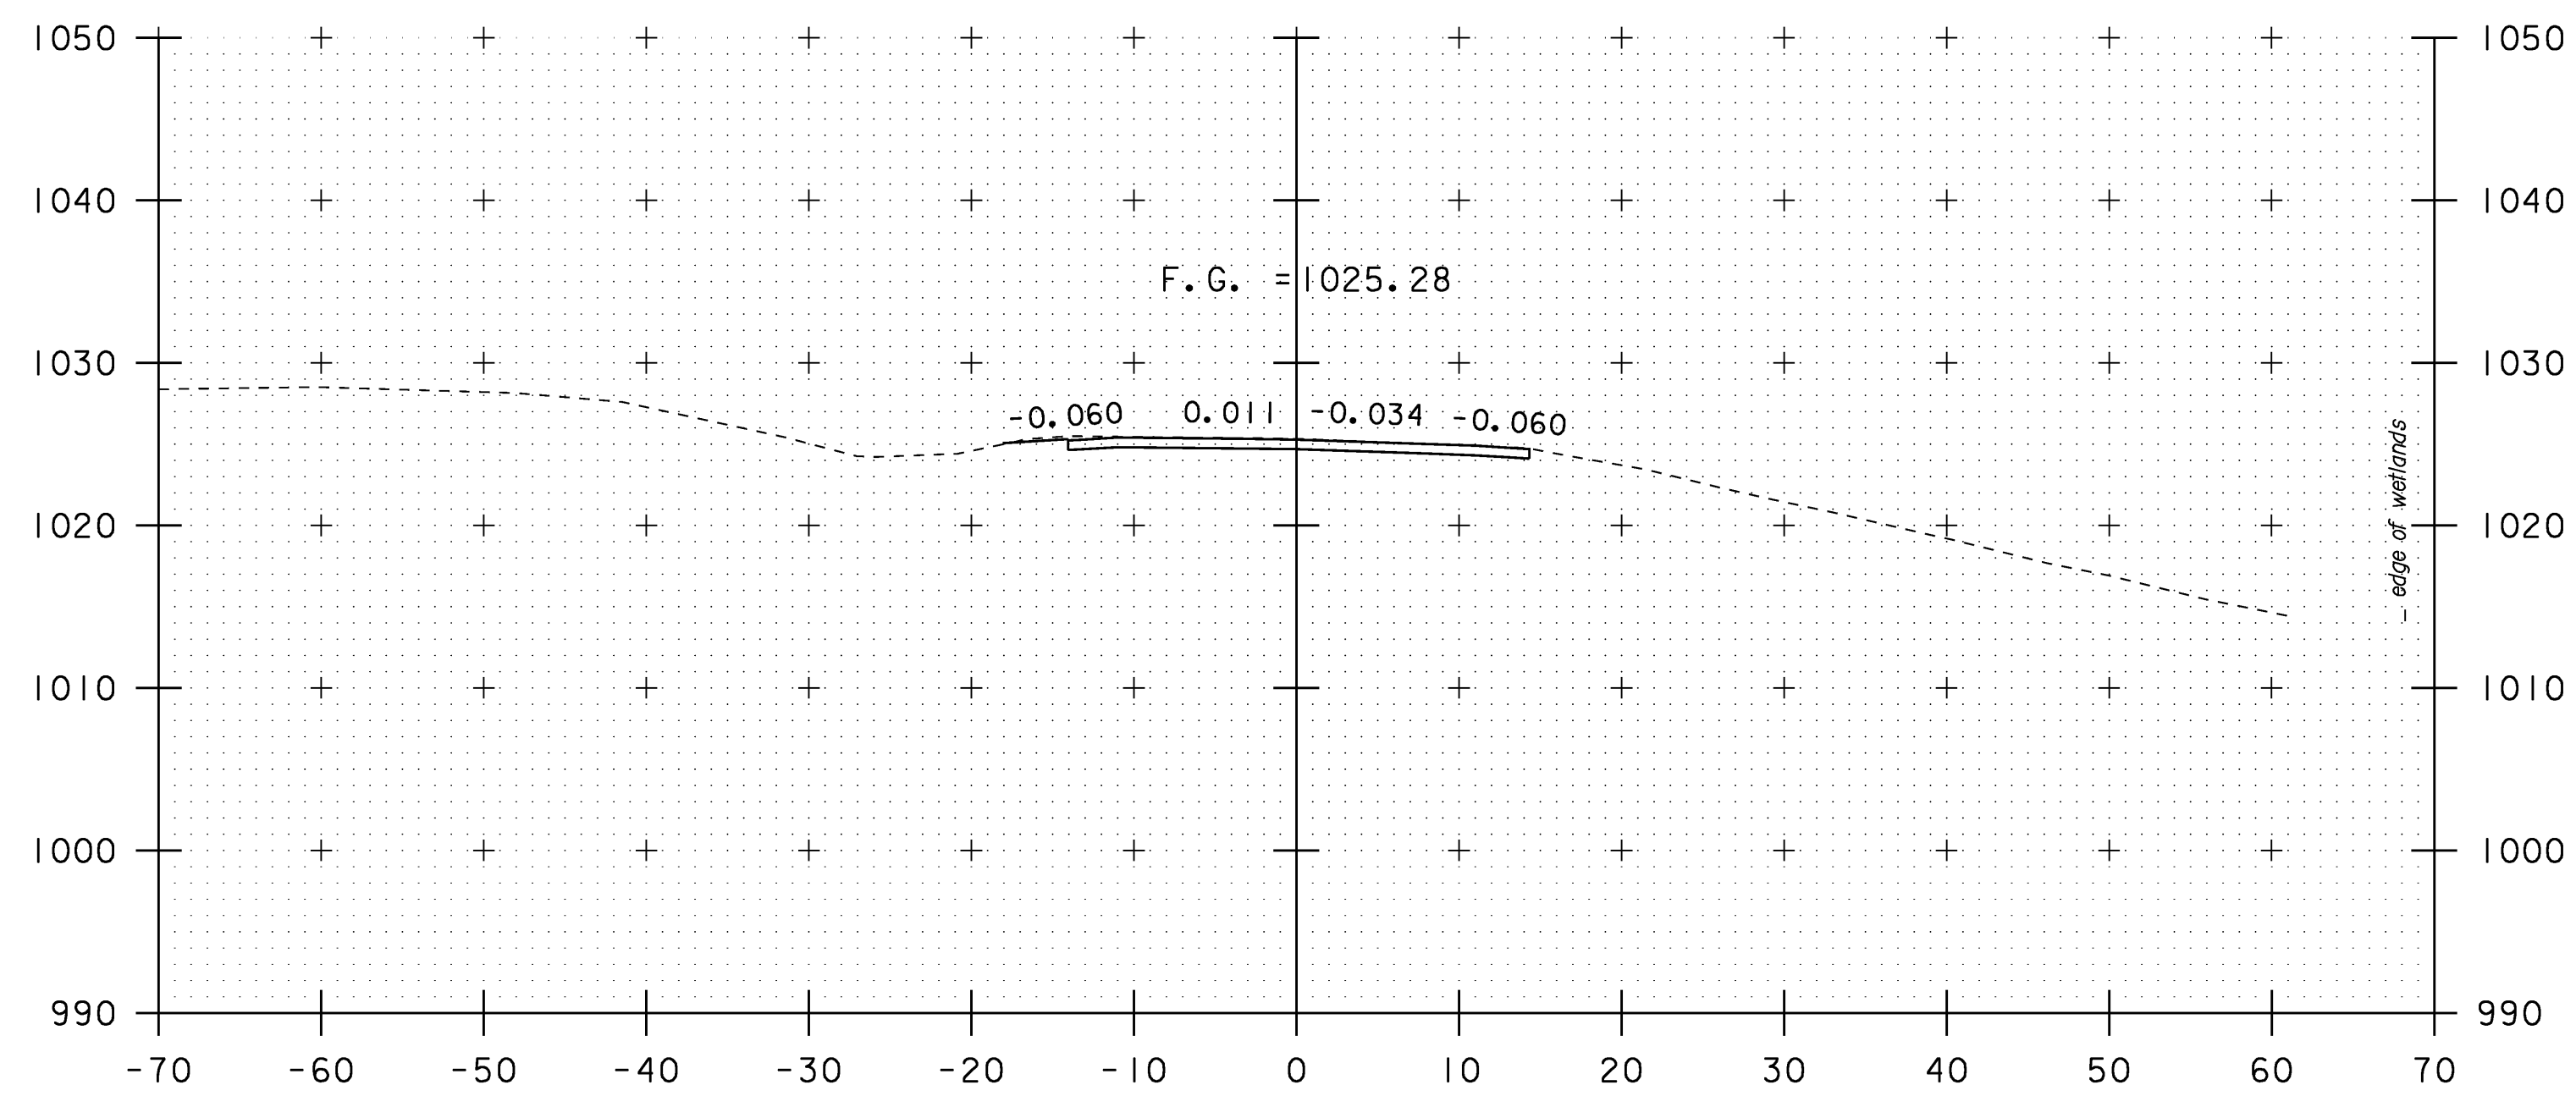

63+97

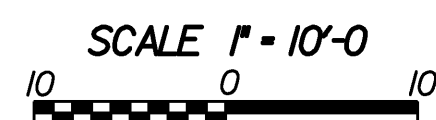

VT 102 CROSS SECTIONS (8)

PROJECT NAME:	CANAAN		
PROJECT NUMBER:	ER ST 0271(16)		
FILE NAME:	/str2/04c098/x04c098bdr.dgn	PLOT DATE:	18-AUG-2008
PROJECT LEADER:	EVANS-MONGEON	DRAWN BY:	HUSK
DESIGNED BY:	SCRIBNER	CHECKED BY:	SCRIBNER
x04c098rxs8.1		SHEET 59	OF 66