



BANKING DIAGRAM

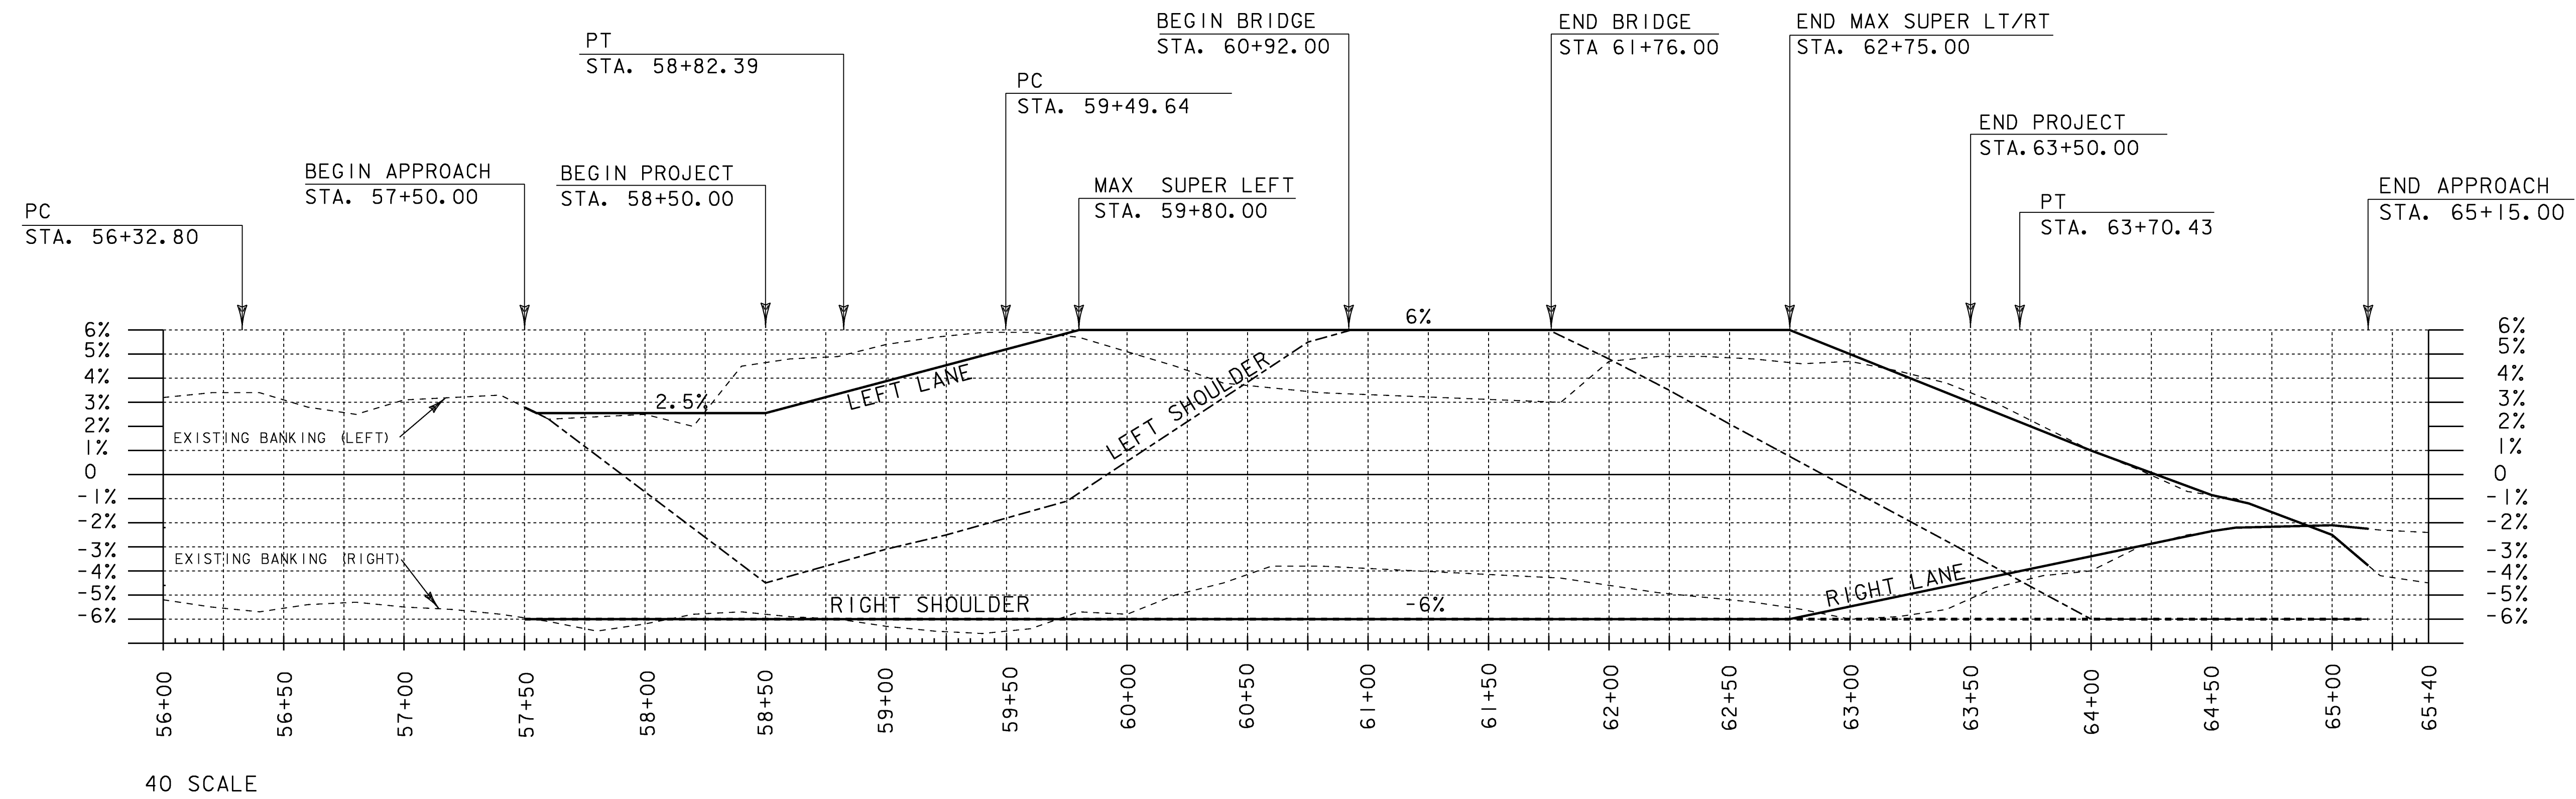

MATERIAL TRANSITIONS

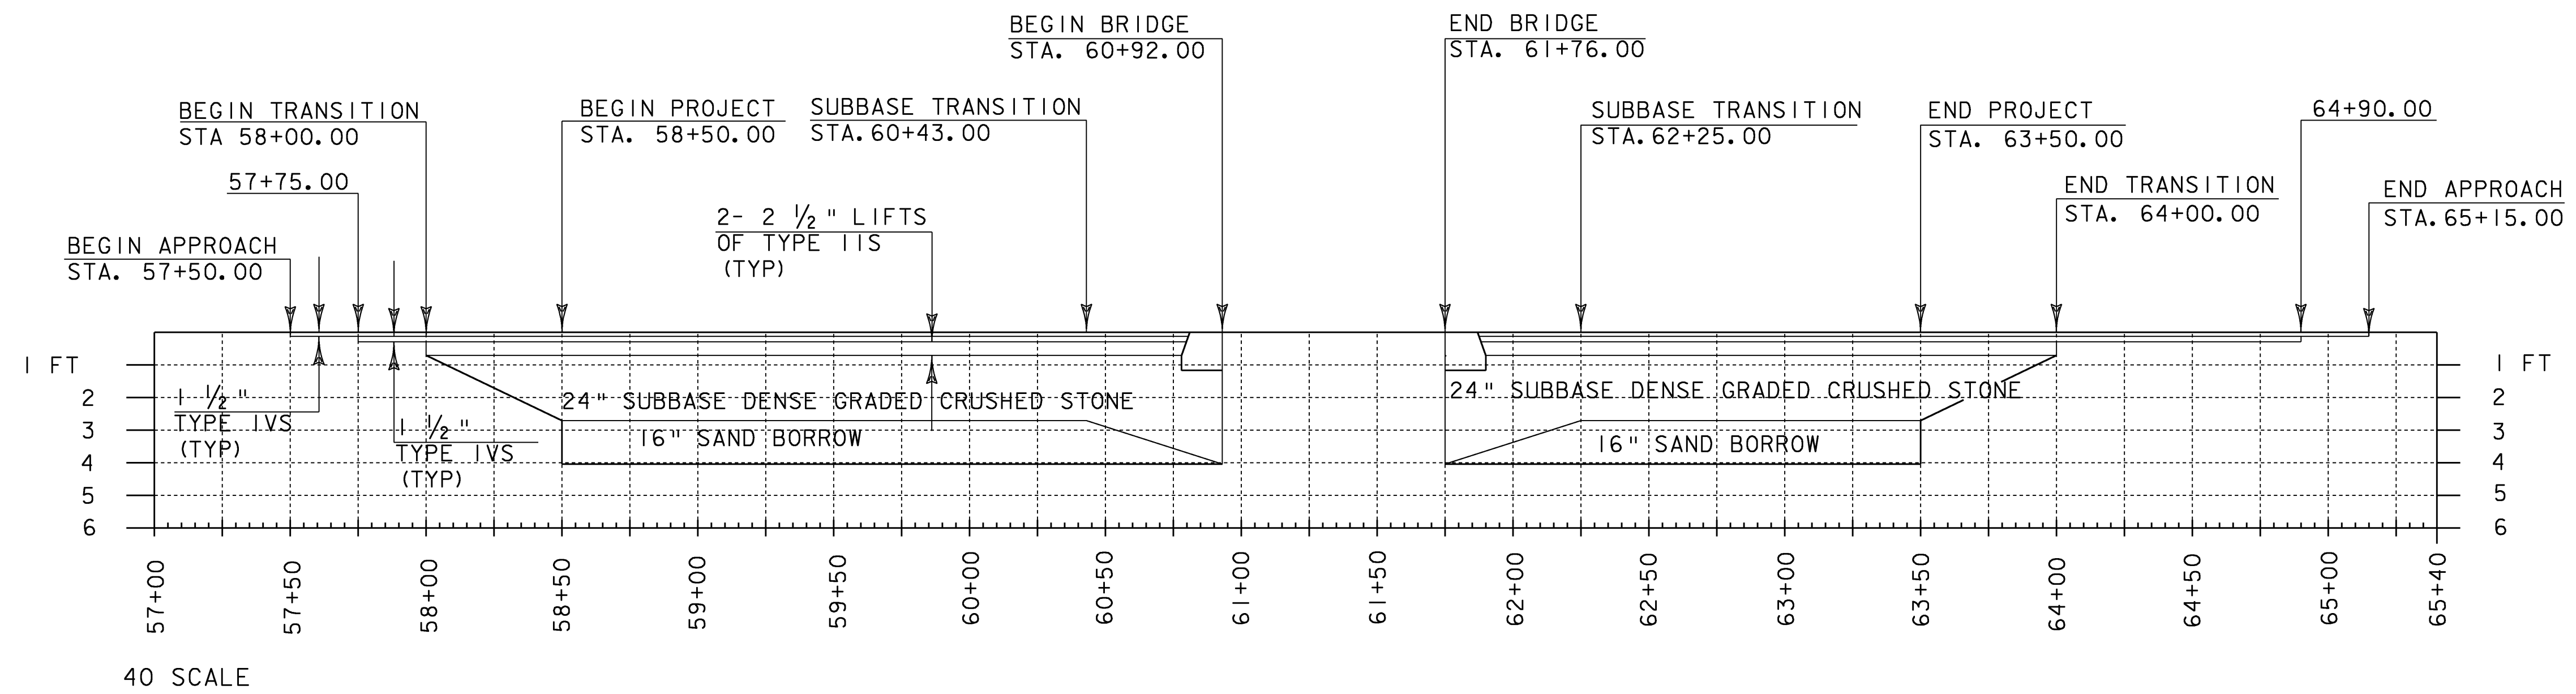

BANKING DIAGRAM & MATERIAL TRANSITION

PROJECT NAME:	CANAAN	FILE NAME:	/str2/04c098/x04c098xs.dgn	PLOT DATE:	02-SEP-2008
PROJECT NUMBER:	ER ST 0271(16)	PROJECT LEADER:	EVANS-MONGEON	DRAWN BY:	HUSK
		DESIGNED BY:	SCRIBNER	CHECKED BY:	SCRIBNER
			x04c098pfl	SHEET	62 OF 66