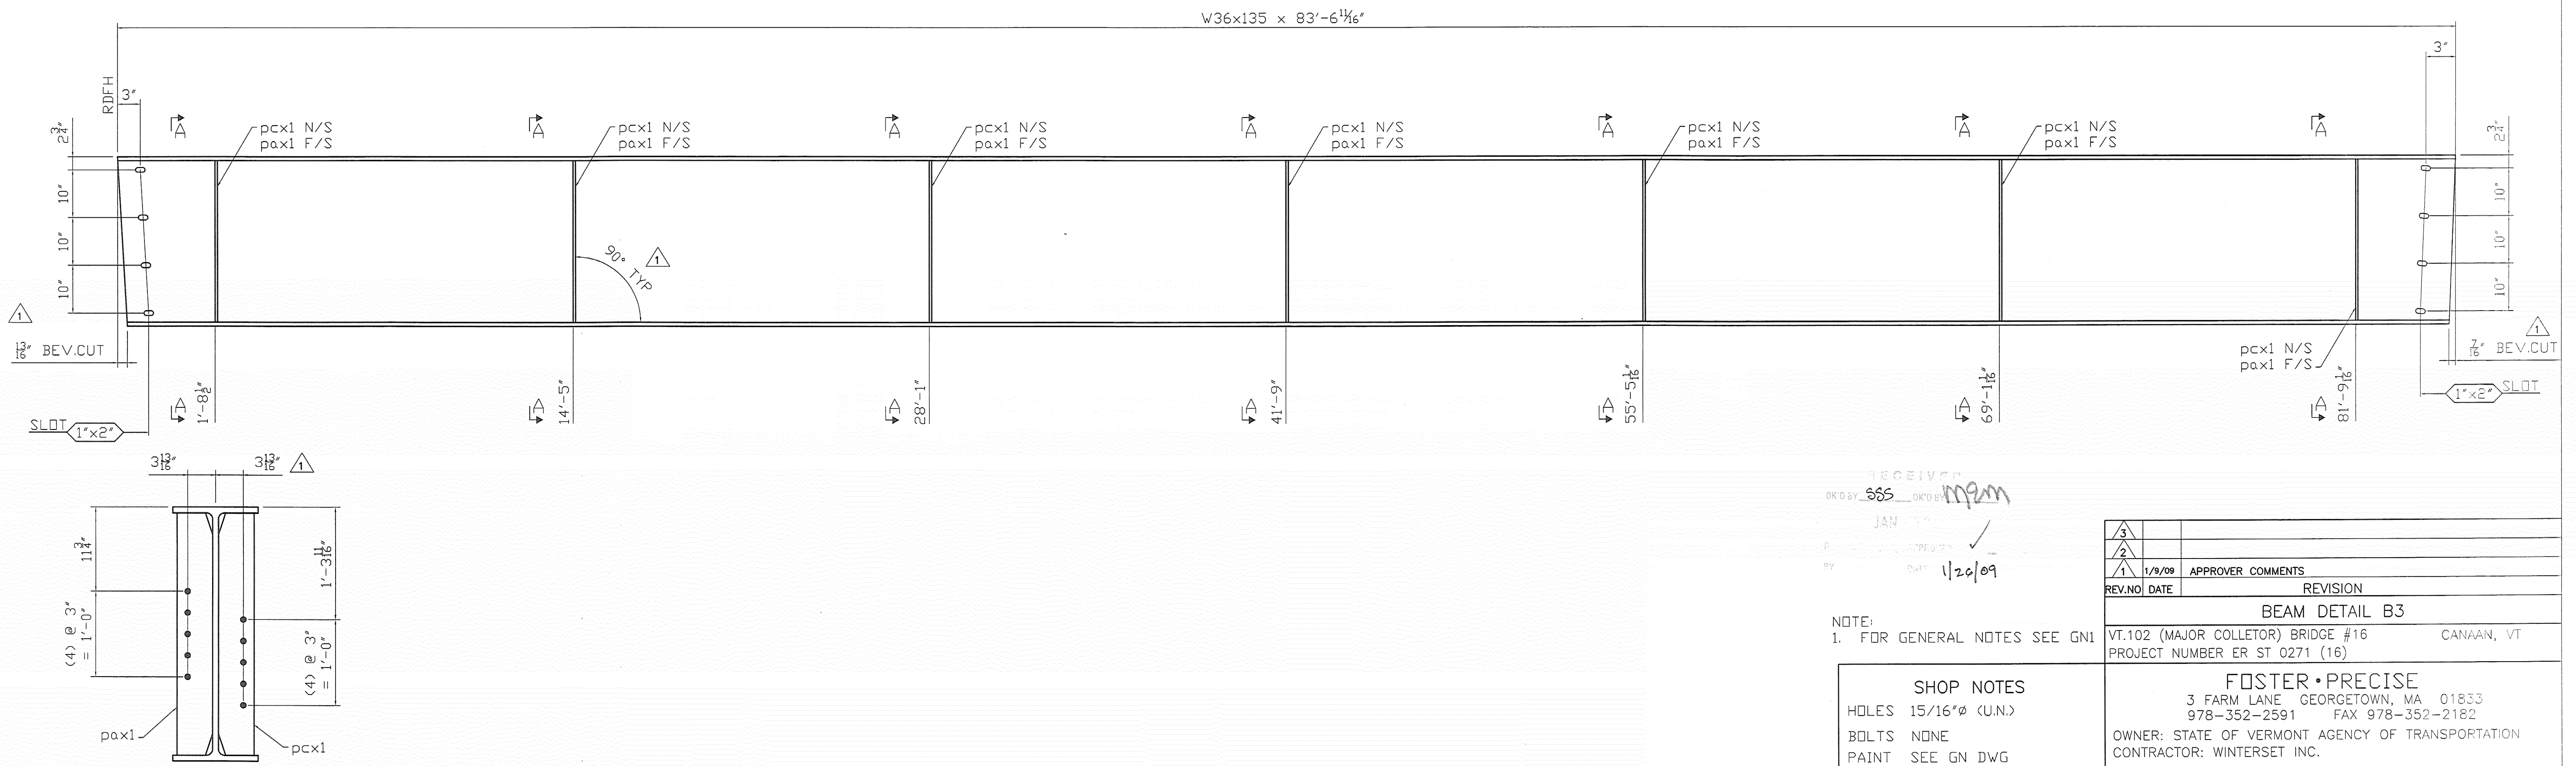
[illegible]

SECTION A-A

RECEIVED
OK'D BY SSS OK'D BY m9m
JAN 19 1964
RECEIVED
BY _____ DATE 1/20/09

NOTE:
1. FOR GENERAL NOTES SEE GN1

SHOP NOTES

HOLES 15/16"Ø (U.N.)

BOLTS NONE

PAINT SEE GN DWG

WELDS TO BE MADE USING E80-NiL ELECTRODES

MATERIAL M270 Gr.50

3					
2					
1	1/9/09	APPROVER	COMMENTS		
REV.NO	DATE	REVISION			
BEAM DETAIL B3					
VT.102 (MAJOR COLLETOER) BRIDGE #16				CANAAN, VT	
PROJECT NUMBER ER ST 0271 (16)					
FOSTER • PRECISE 3 FARM LANE GEORGETOWN, MA 01853 978-352-2591 FAX 978-352-2182 OWNER: STATE OF VERMONT AGENCY OF TRANSPORTATION CONTRACTOR: WINTERSET INC.					
DRAWN BY	CHECKED BY			JOB NO.	SHEET NO.
KC 11/23/08	WL 11/30/08			3476	3