




35 REQ'D ~ GUSSET ~ pax1

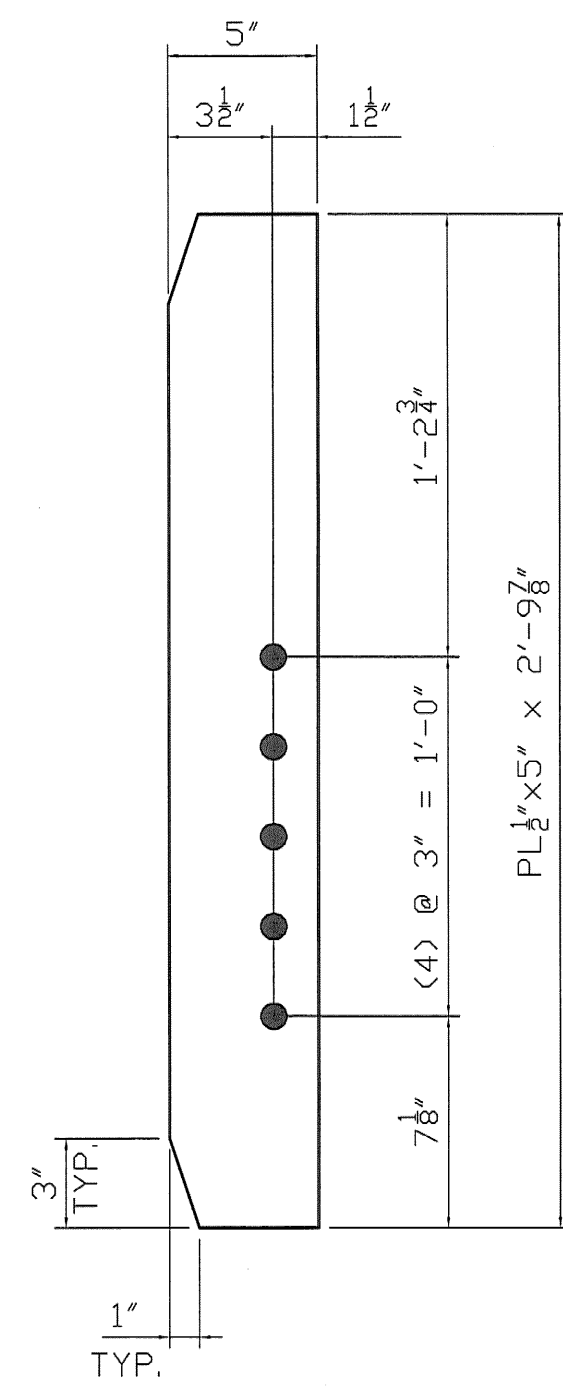


ONE REQ'D ~ GUSSET ~ pbx1

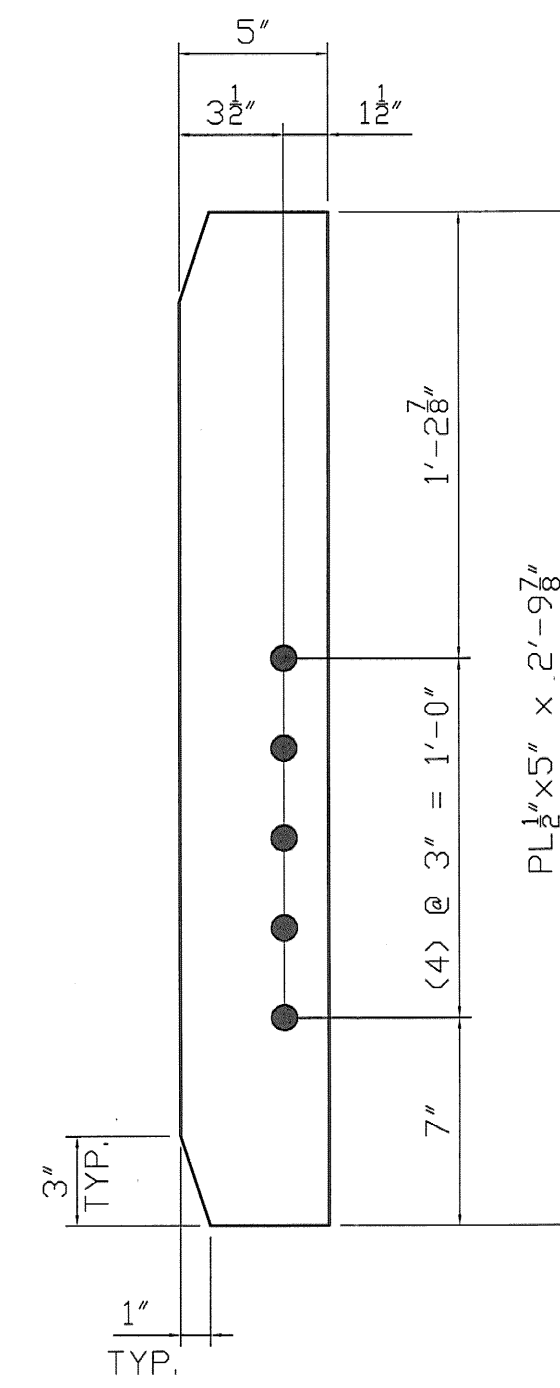


25 REQ'D ~ GUSSET ~ pcx1

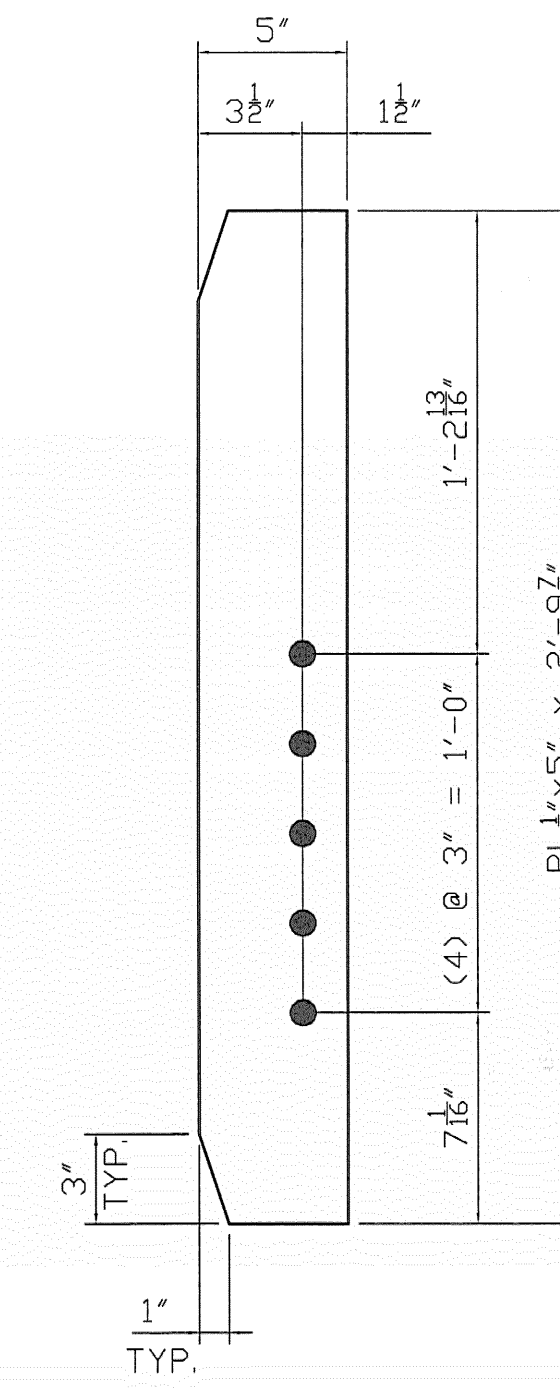


3 REQ'D ~ GUSSET ~ pdx1

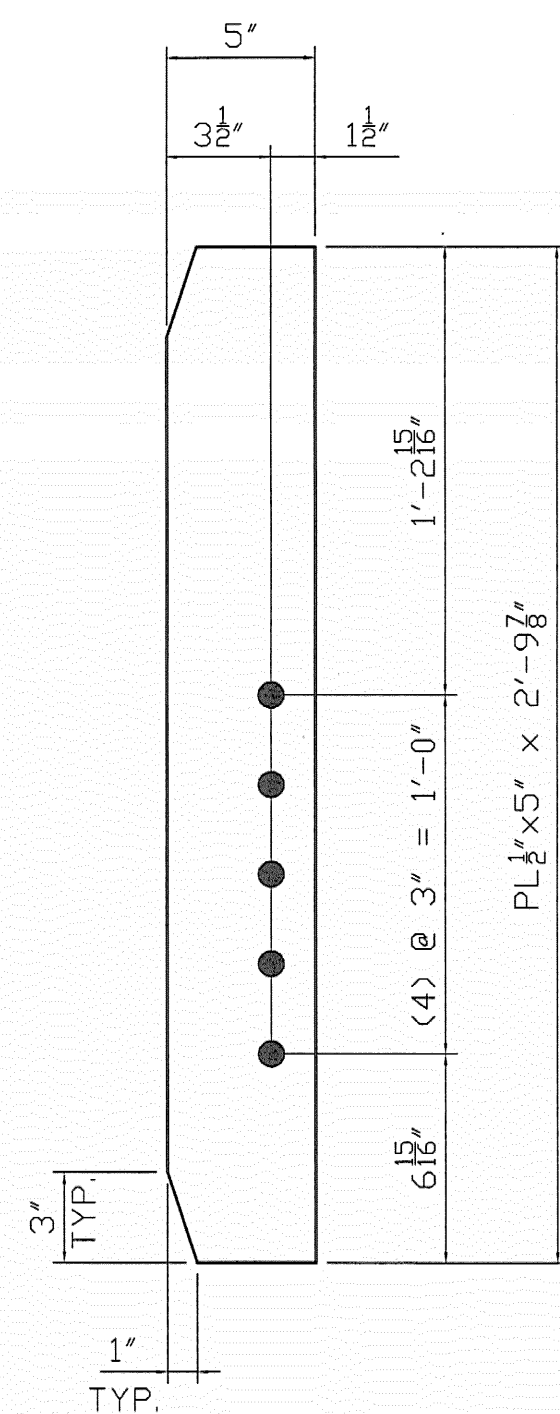

3 REQ'D ~ GUSSET ~ pfx1

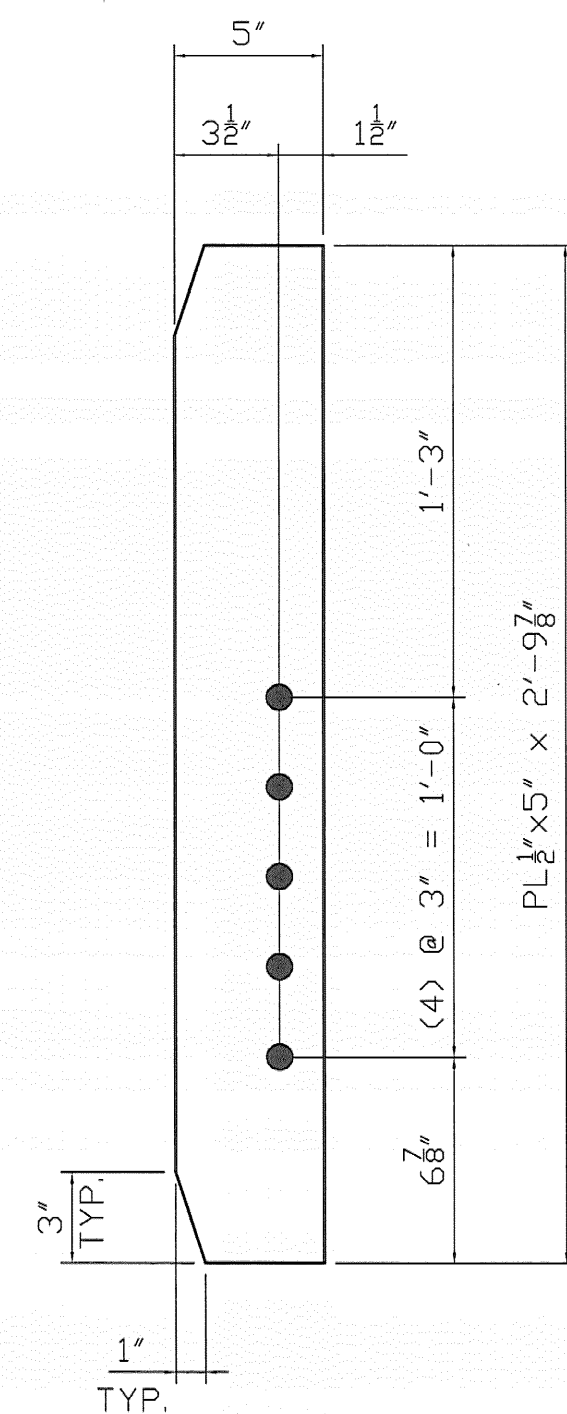

3 REQ'D ~ GUSSET ~ pgx1

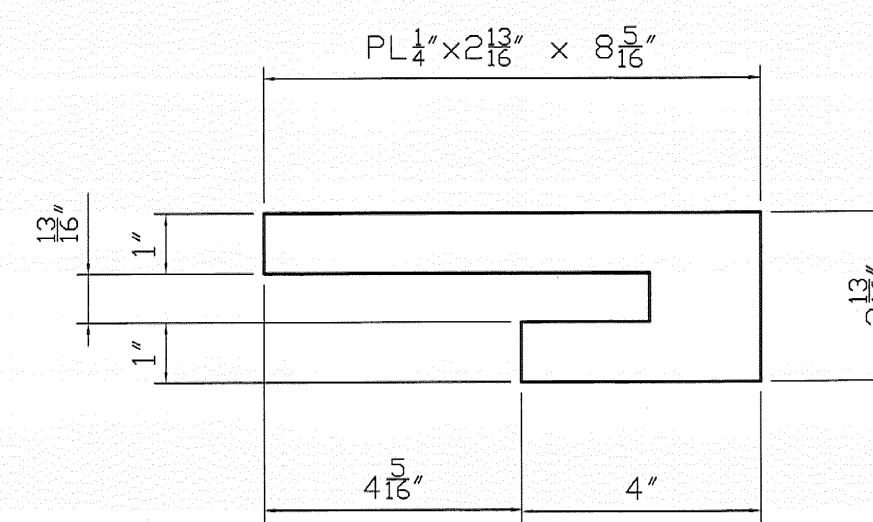

2 REQ'D ~ GUSSET ~ phx1

REVISION
 1/24/09

NOTE:
 1. FOR GENERAL NOTES SEE GN1

REV NO	DATE	REVISION
3		
2		
1		

DIAPHRAM DETAIL

VT.102 (MAJOR COLLECTOR) BRIDGE #16 CANAAN, VT
 PROJECT NUMBER ER ST 0271 (16)

SHOP NOTES
 HOLES 15/16" Ø (U.N.)
 BOLTS NONE
 PAINT SEE GN DWG
 WELDS TO BE MADE USING ER80-NiL ELECTRODES
 MATERIAL M270 Gr.50

FOSTER • PRECISE
 3 FARM LANE GEORGETOWN, MA 01833
 978-352-2591 FAX 978-352-2182
 OWNER: STATE OF VERMONT AGENCY OF TRANSPORTATION
 CONTRACTOR: WINTERSSET INC

DRAWN BY	CHECKED BY	JOB NO.	SHEET NO.
KC	WL	3476	X1
11/23/08	11/30/08		