



NOTE:
SEE PRELIMINARY SHEET FOR INDEX OF SHEETS
AND LIST OF STANDARDS

STATE OF VERMONT AGENCY OF TRANSPORTATION

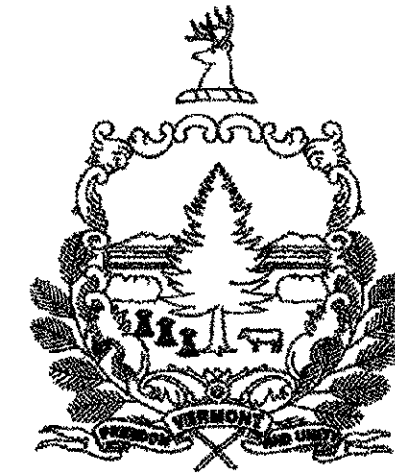


PROPOSED IMPROVEMENT BRIDGE PROJECT TOWN OF BUEL'S GORE CHITTENDEN COUNTY VT. ROUTE 17 - MAJOR COLLECTOR BRIDGE NO. 27

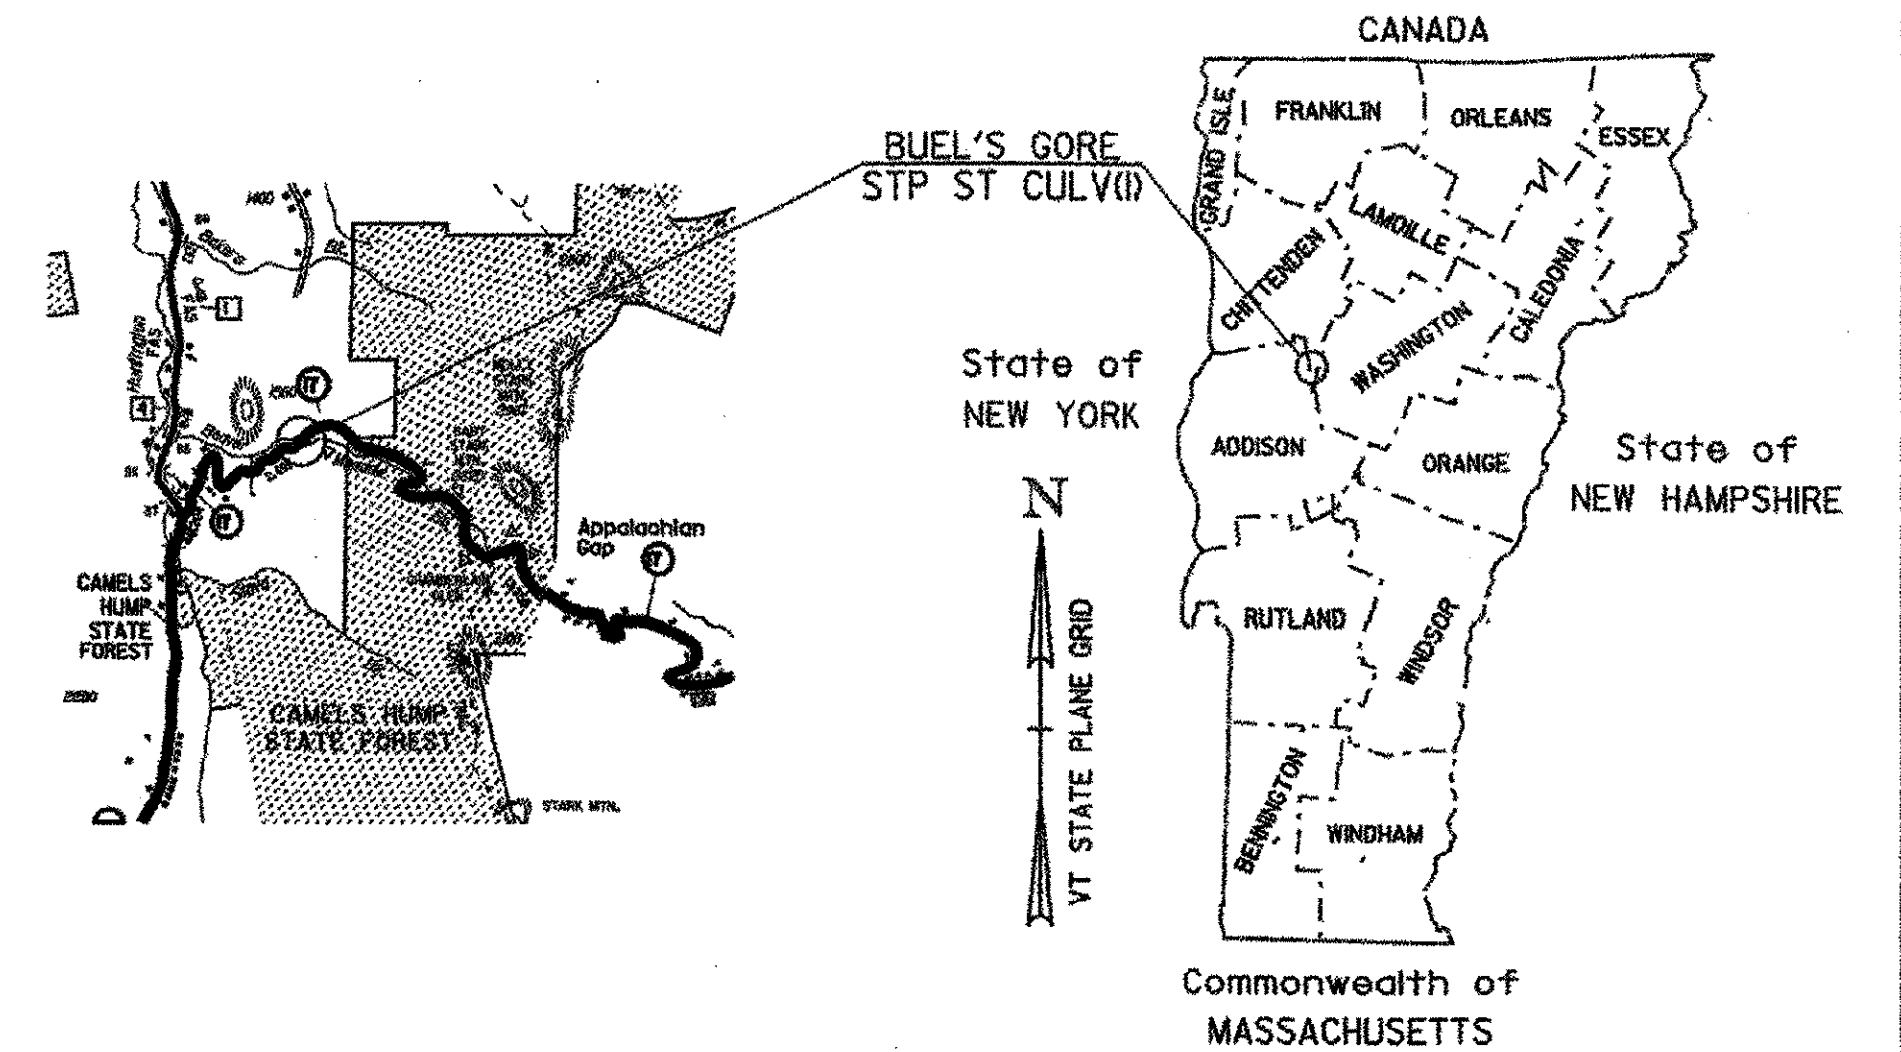

PROJECT LOCATION : BEGINNING AT A POINT ON VT ROUTE 17 APPROXIMATELY 1 MILE EAST OF THE T.H.4/VT ROUTE 17 INTERSECTION

PROJECT DESCRIPTION : REMOVAL AND DISPOSAL OF EXISTING STRUCTURE AND PLACEMENT OF A ~~NEW BOX CULVERT,~~ ^{NEW PRECAST ARCH WITH CAST IN PLACE FOOTINGS FOR ARCH AND WINGWALLS,} INCLUDING ASSOCIATED TEMPORARY CHANNEL AND TEMPORARY ROADWAY APPROACH WORK.

LENGTH OF STRUCTURE : 17.04 FEET.
LENGTH OF ROADWAY : 82.96 FEET.
LENGTH OF PROJECT : 100 FEET.

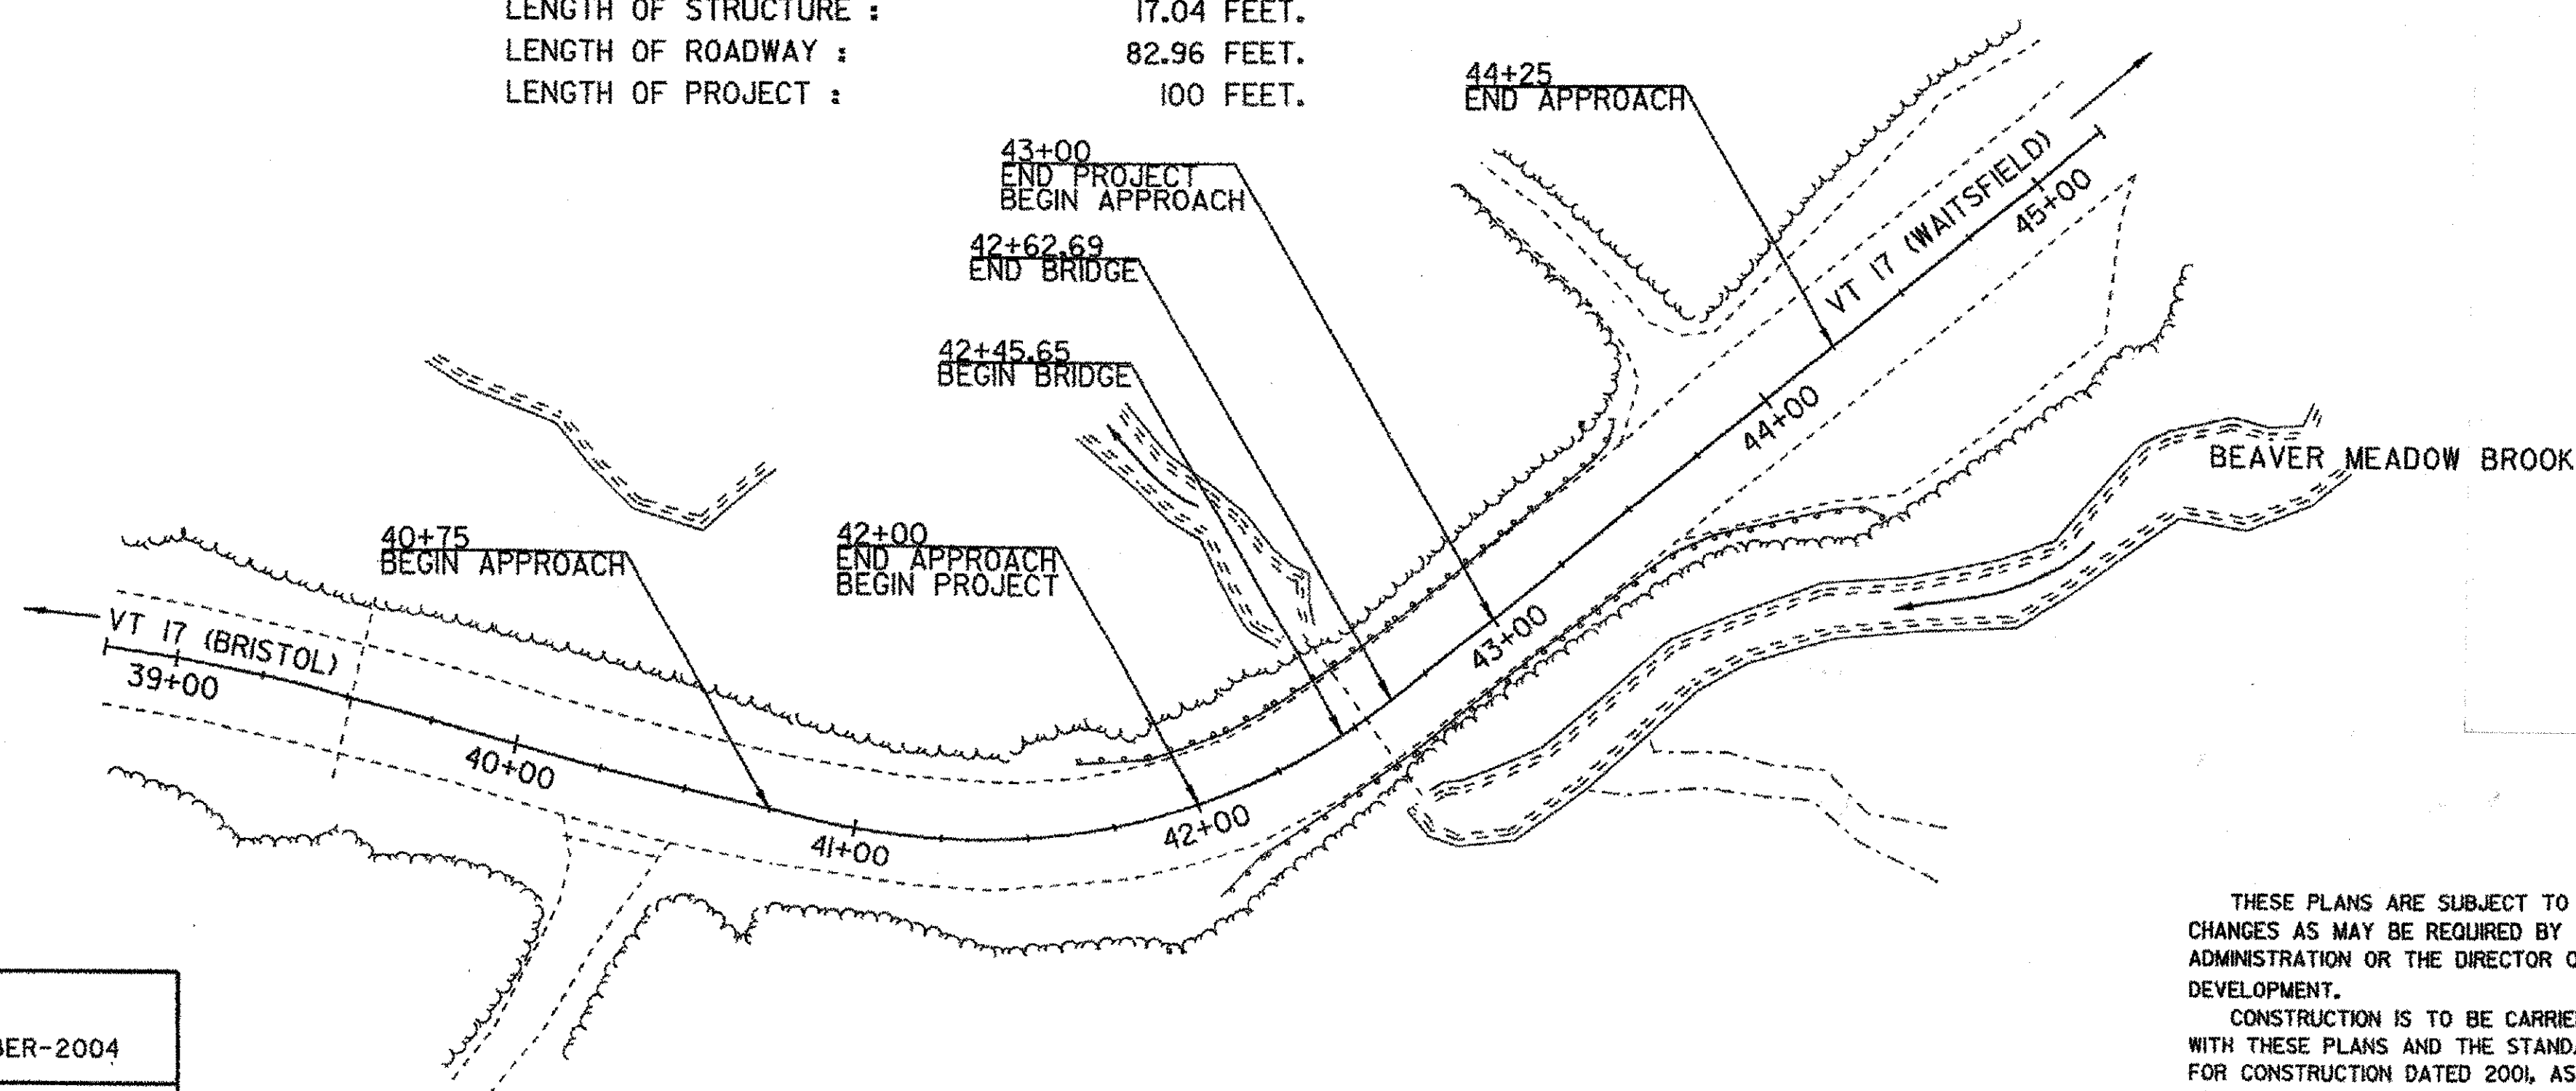

RECORD PLANS	
CONTRACTOR:	PIKE INDUSTRIES, INC. - BERLIN, VT
RESIDENT ENGINEER:	IAN JENIKE
CONSTRUCTION BEGAN:	7/13/2006
CONSTRUCTION COMPLETE:	10/30/2006
RECORD PLANS BY:	IAN JENIKE & N. GARBACIK
I HEREBY CERTIFY THAT ALL THE CONSTRUCTION REQUIRED BY THIS SET OF DRAWINGS HAS BEEN ACCOMPLISHED AS INDICATED HEREIN.	
BY:	<i>[Signature]</i> RESIDENT ENGINEER
DATE:	5/2/07
NOTE: Any further information concerning final quantities, amounts or other details relative to this project may be found at Central Files in the electronic archives.	

CONVENTIONAL SYMBOLS	
COUNTY LINE	
TOWN LINE	
LIMITS OF ACCESS	
POINT OF ACCESS	
FENCE LINE	
STONE WALL	
TRAVELED WAY	
GUARD RAIL	
RAILROAD	
SURVEY LINE	
CULVERT	
POWER POLE	
TELEPHONE POLE	
TREES	
CONTROL OF ACCESS	
PROPERTY LINE	
R.O.W. TAKING LINE	
SLOPE RIGHTS	
TOP OF CUT	
TOE OF SLOPE	

SURVEYED BY : L ORVIS
SURVEYED DATE : 16-NOVEMBER-2004
DATUM
VERTICAL NAVD 27
HORIZONTAL ASSUMED



THESE PLANS ARE SUBJECT TO SUCH ENGINEERING CHANGES AS MAY BE REQUIRED BY THE FEDERAL HIGHWAY ADMINISTRATION OR THE DIRECTOR OF PROGRAM DEVELOPMENT.
CONSTRUCTION IS TO BE CARRIED ON IN ACCORDANCE WITH THESE PLANS AND THE STANDARD SPECIFICATIONS FOR CONSTRUCTION DATED 2001, AS APPROVED BY THE FEDERAL HIGHWAY ADMINISTRATION ON JANUARY 4, 2001 FOR USE ON THIS PROJECT, INCLUDING ALL SUBSEQUENT REVISIONS AND SUCH REVISED SPECIFICATIONS AND SPECIAL PROVISIONS AS ARE INCORPORATED IN THESE PLANS.

DIRECTOR OF PROGRAM DEVELOPMENT	
APPROVED <i>[Signature]</i>	DATE 3-28-06
PROJECT MANAGER : M. EVANS-MONGEON	
PROJECT NAME : BUEL'S GORE	
PROJECT NUMBER : STP ST CULV(I)	
IPARM: s04c138+1.1	
SHEET 1 OF 30 SHEETS	