

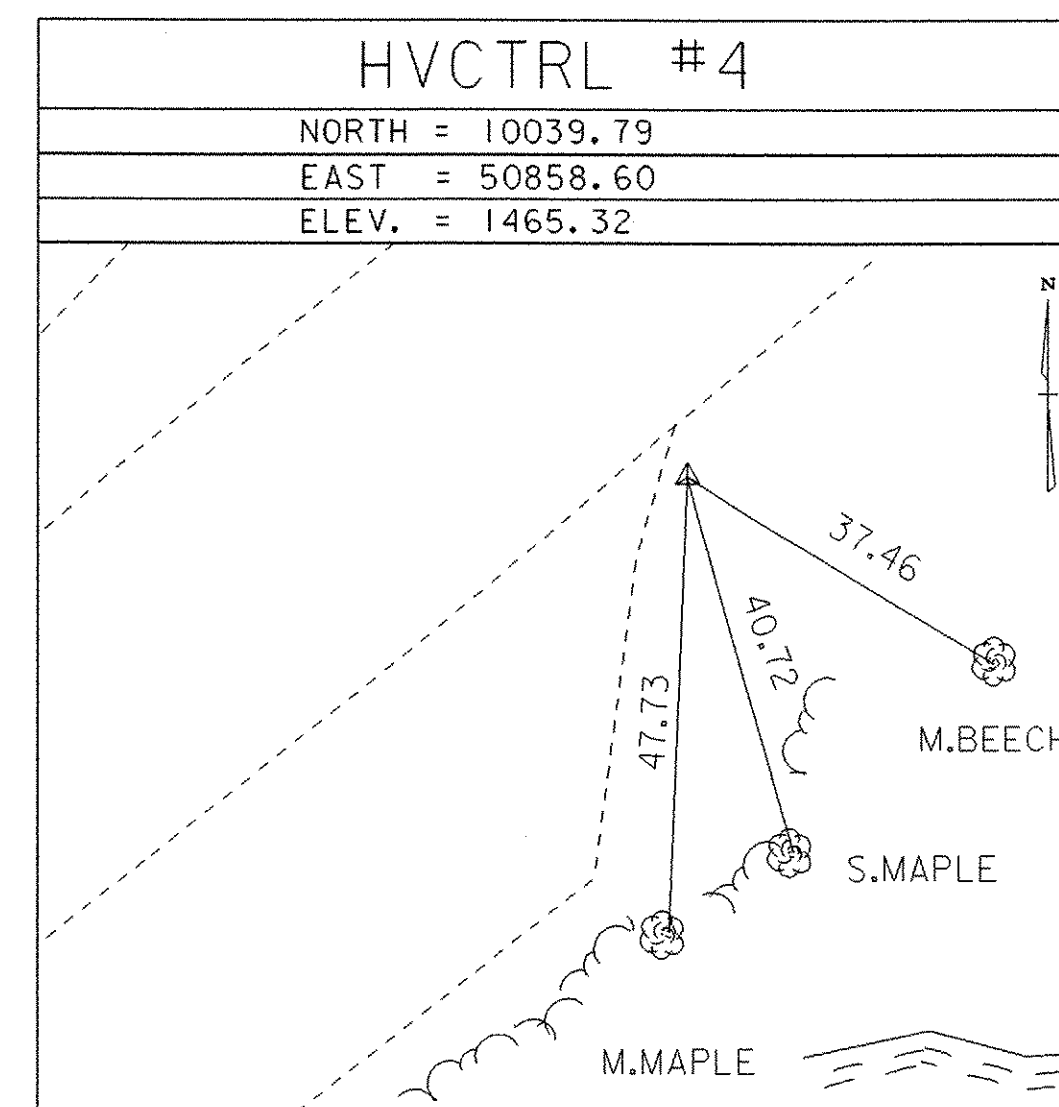
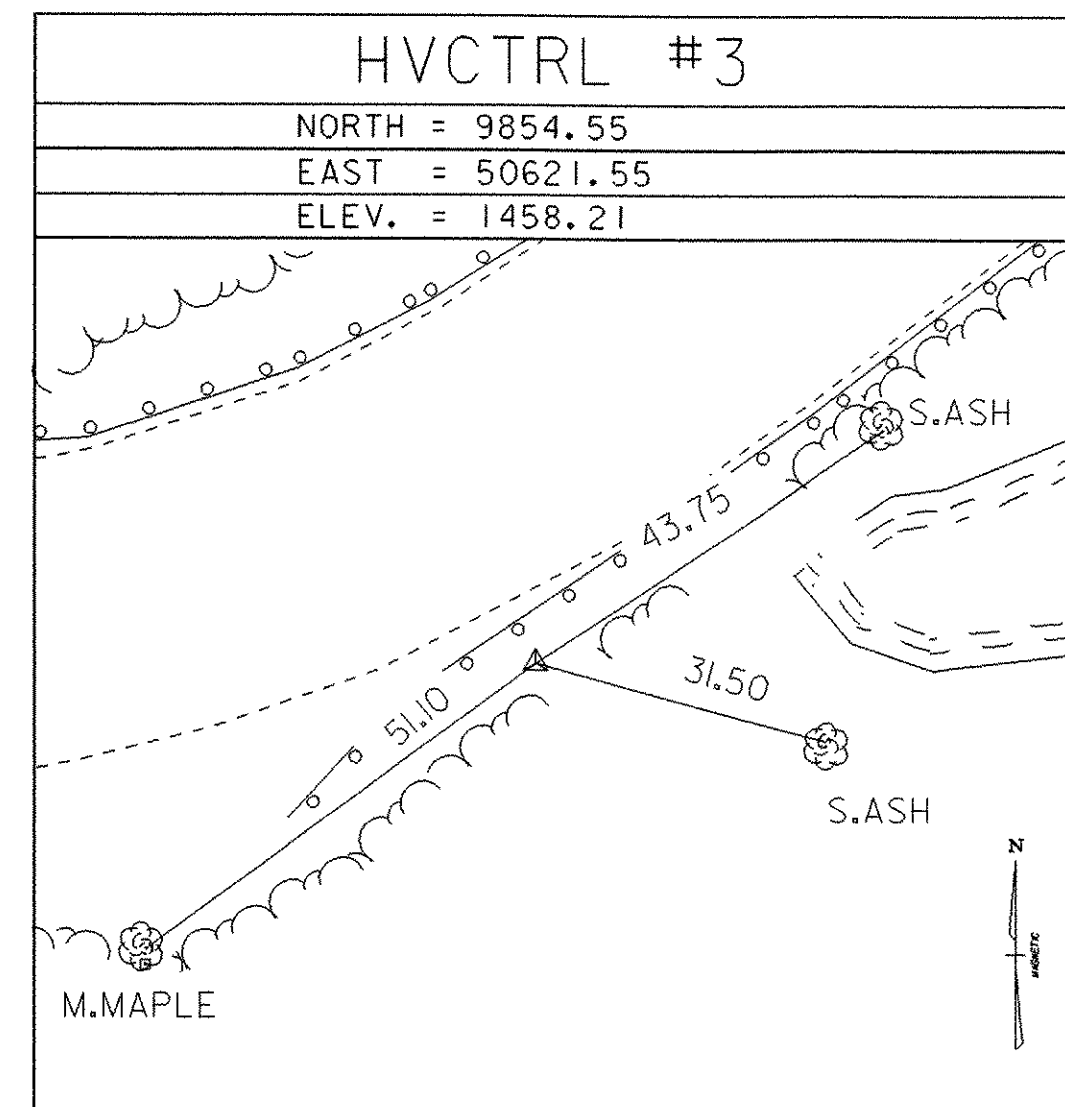


TRAVERSE TIES





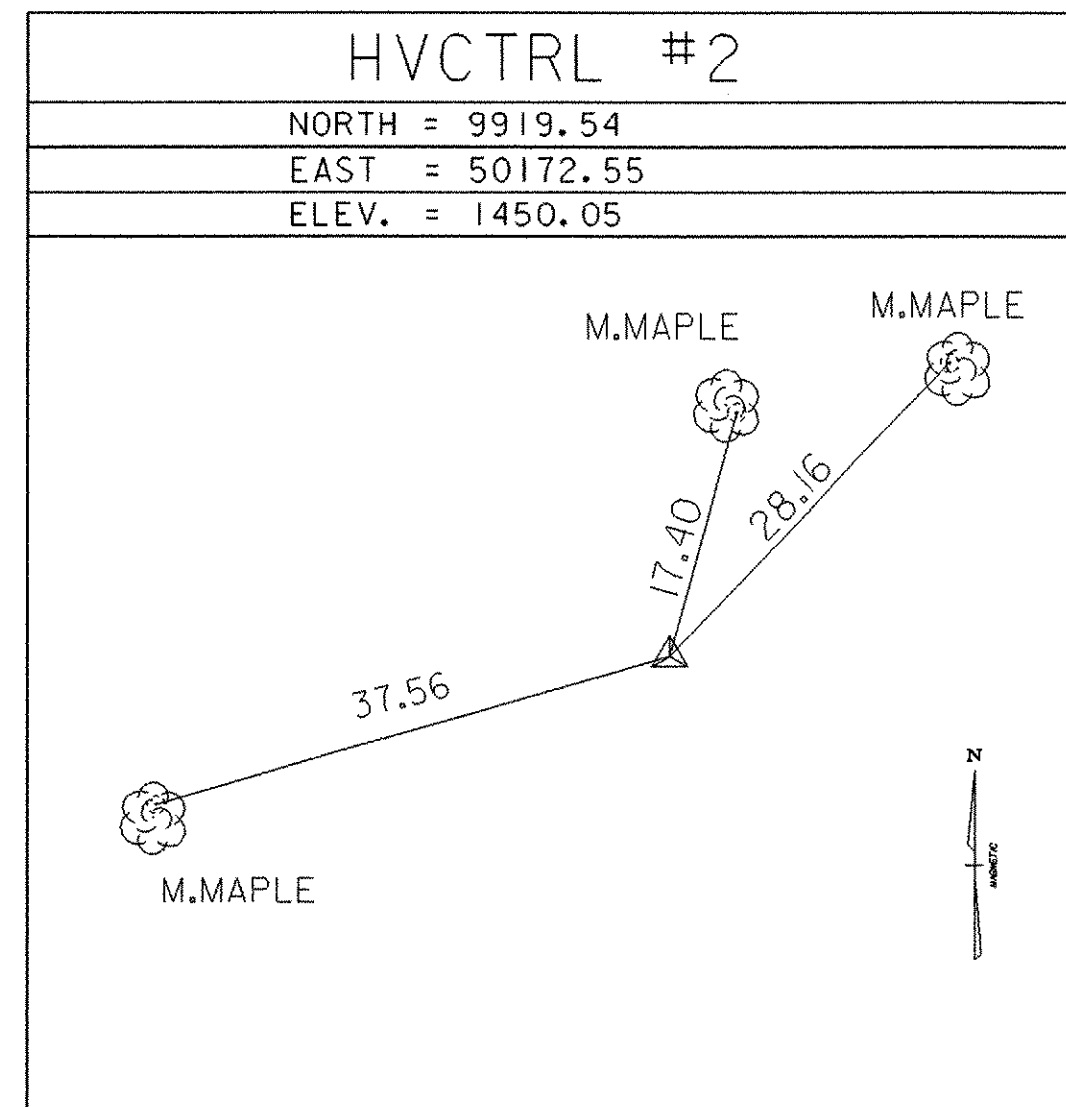


ALIGNMENT TIES

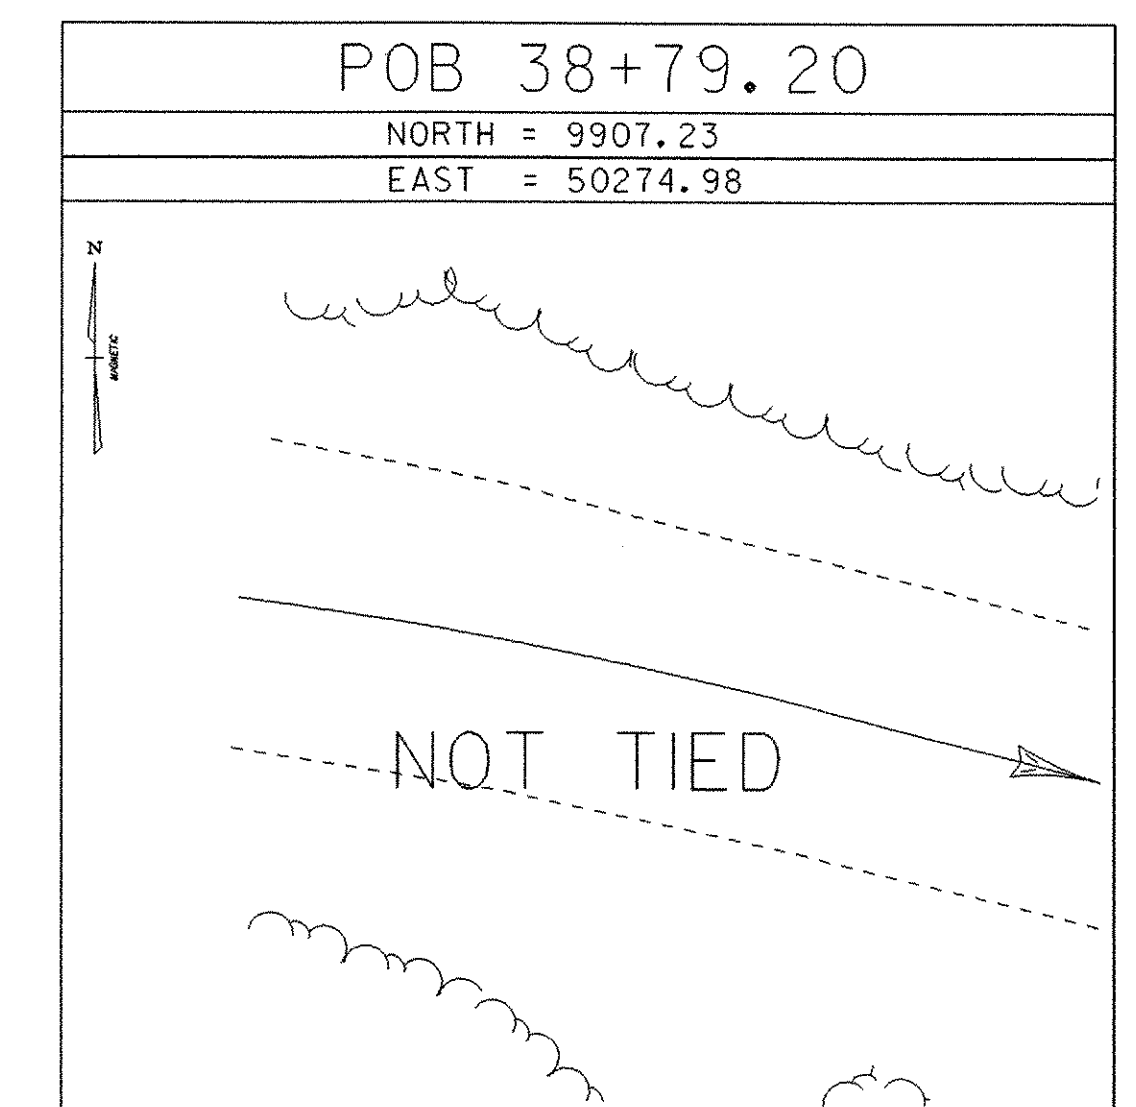






Traverse completed 10/18/2004 by L.Orvis P.C. & J.Hulett

ALIGNMENT TIES

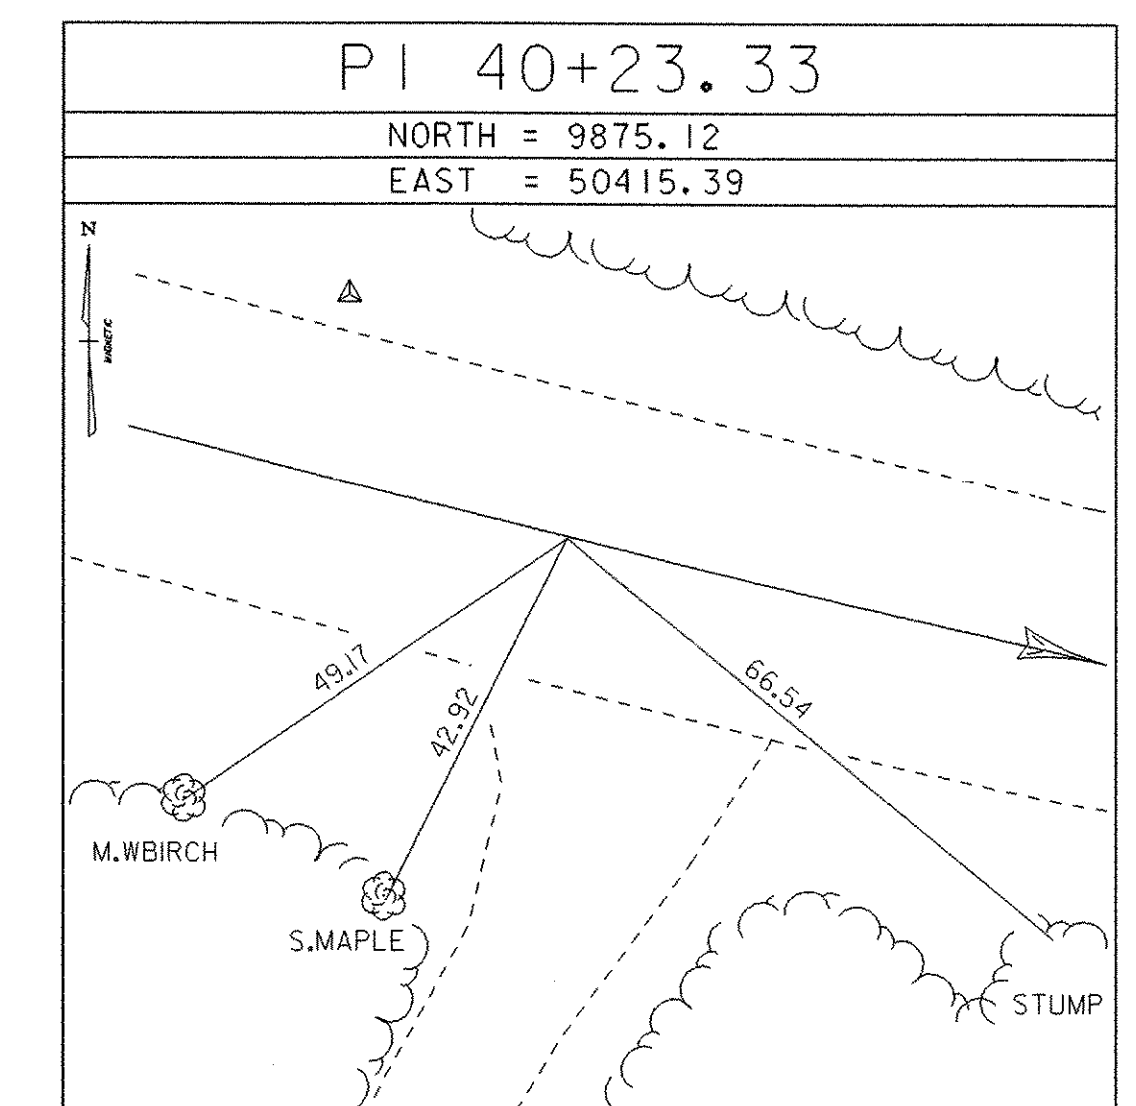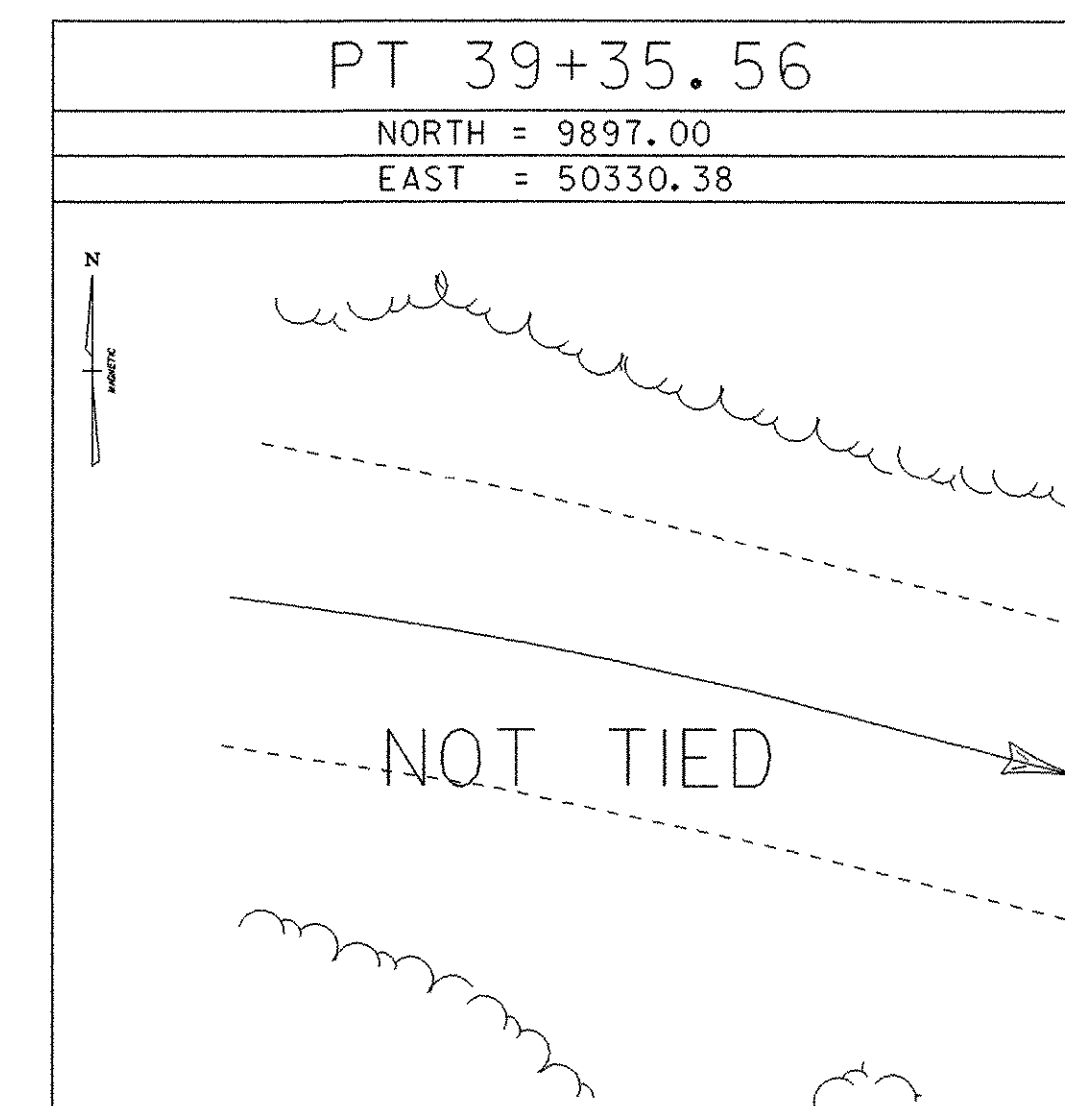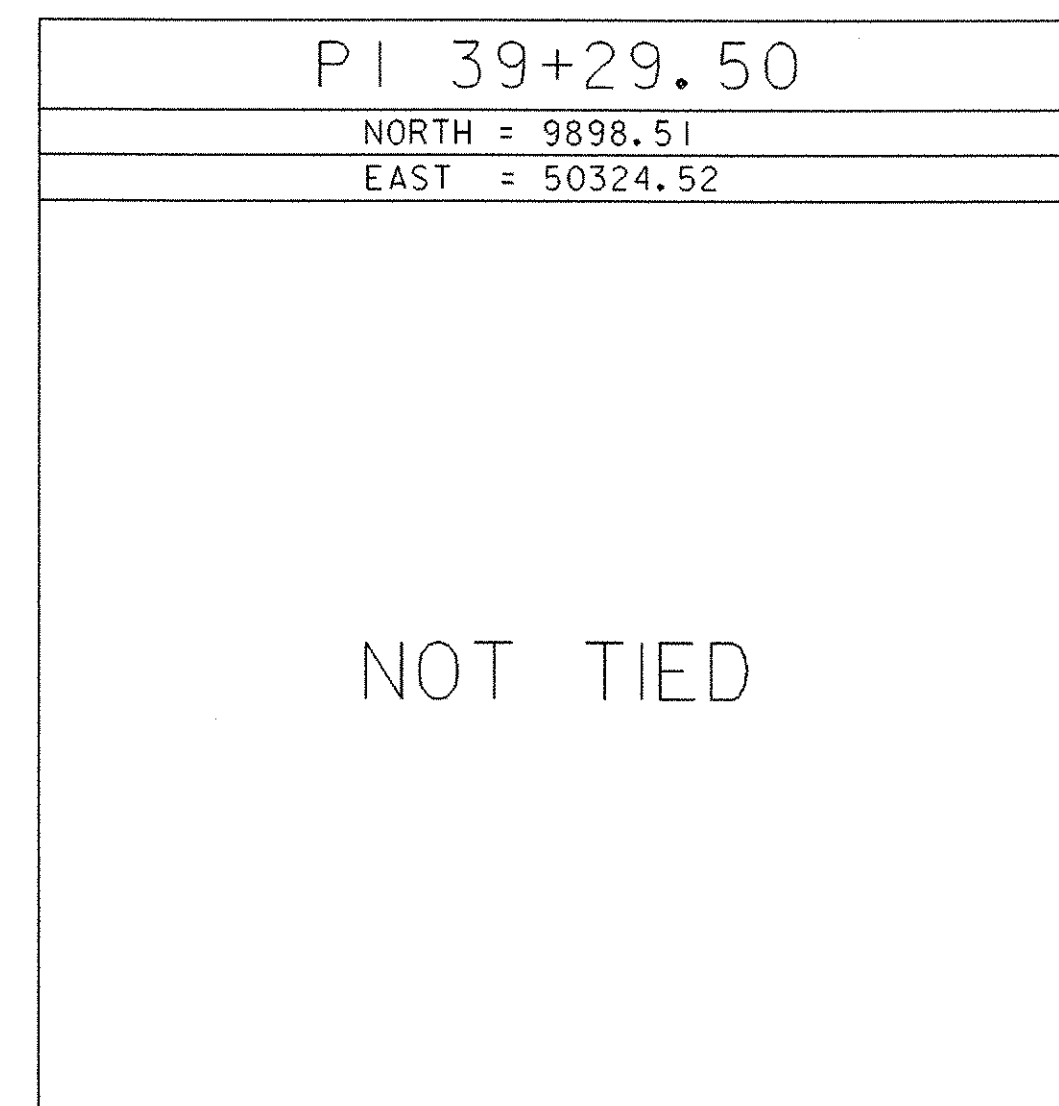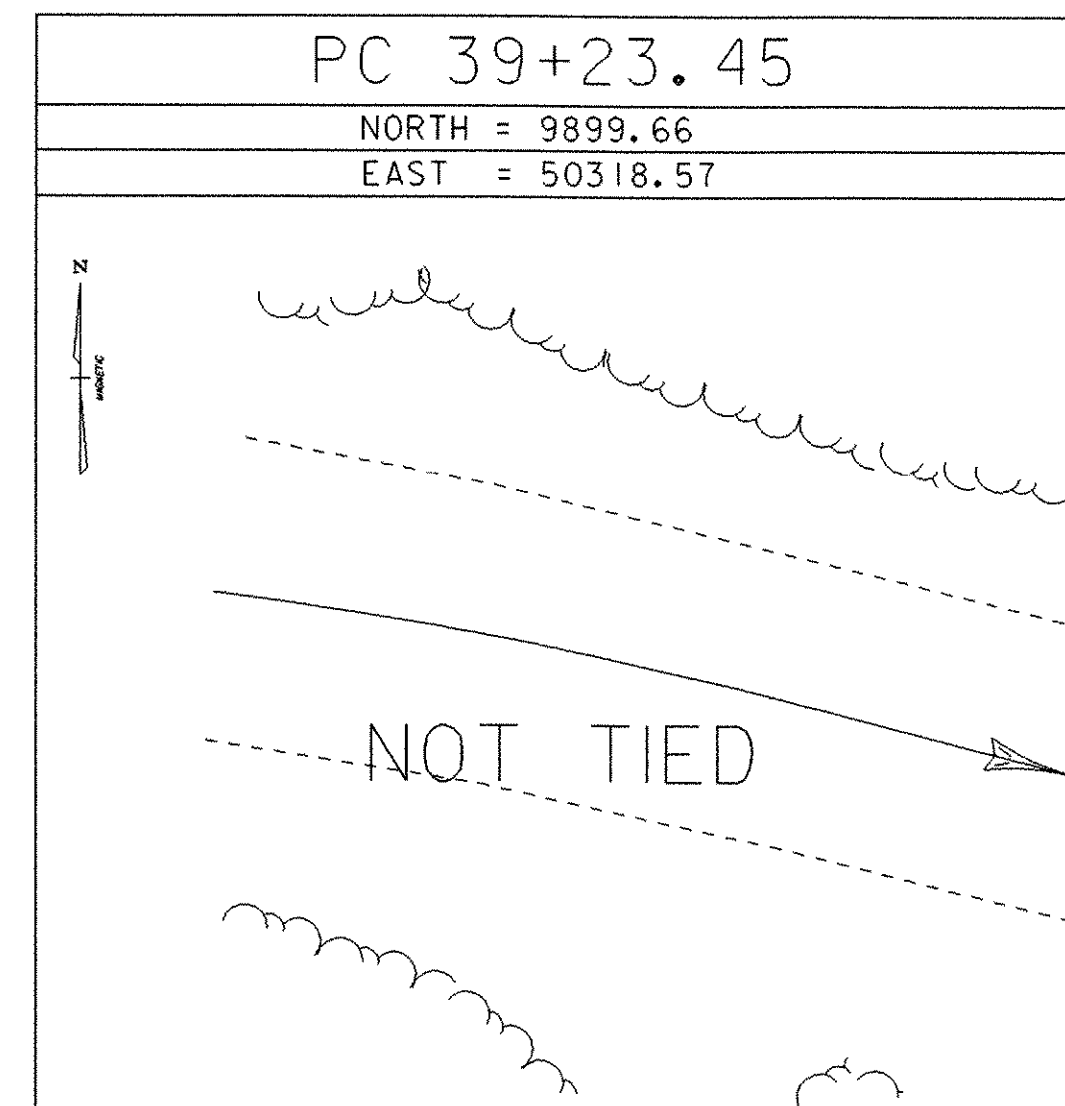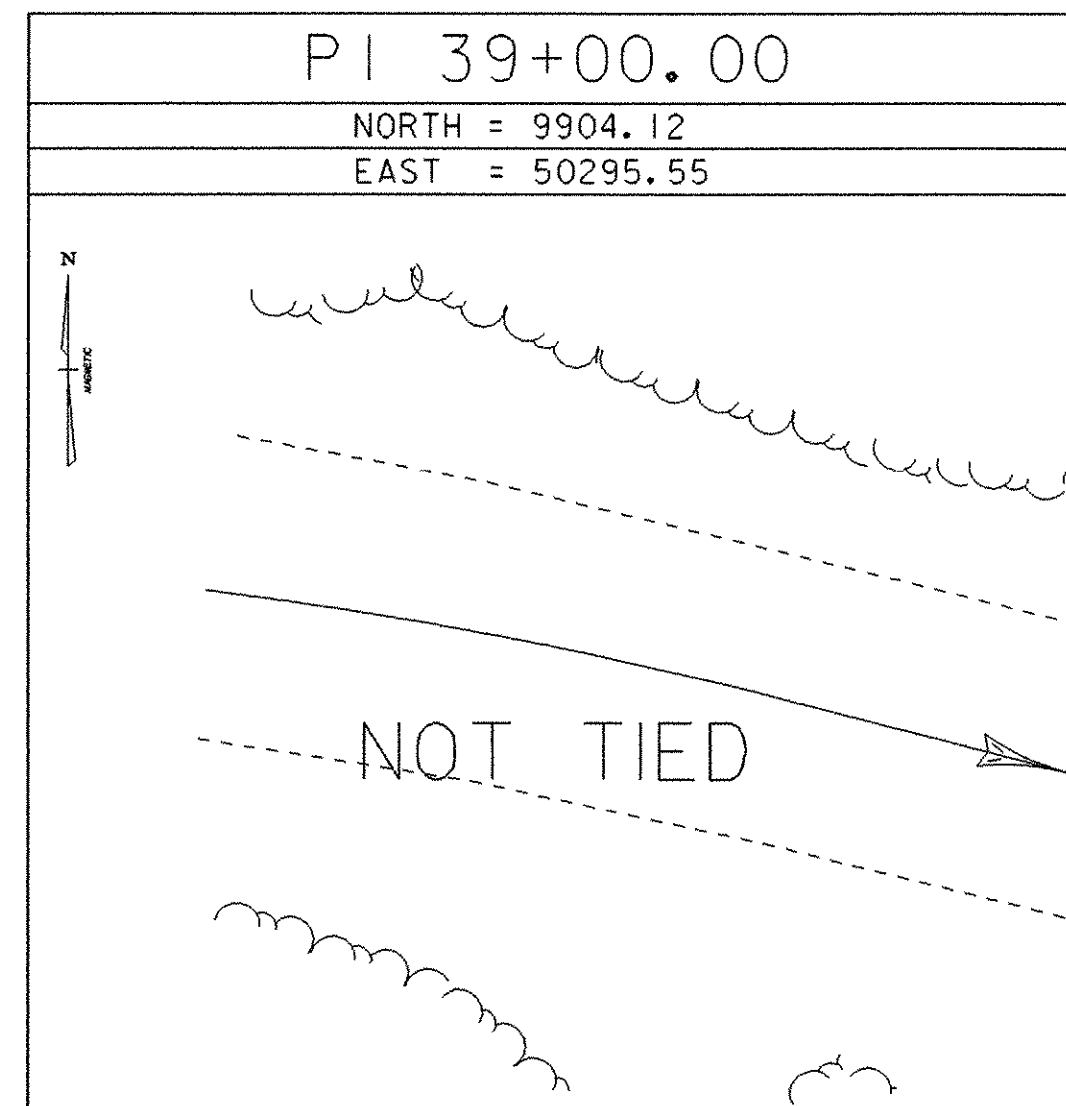

Centerline Staked 06/02/2005 by L.Orvis P.C. & J.Hulett

ALIGNMENT TIES

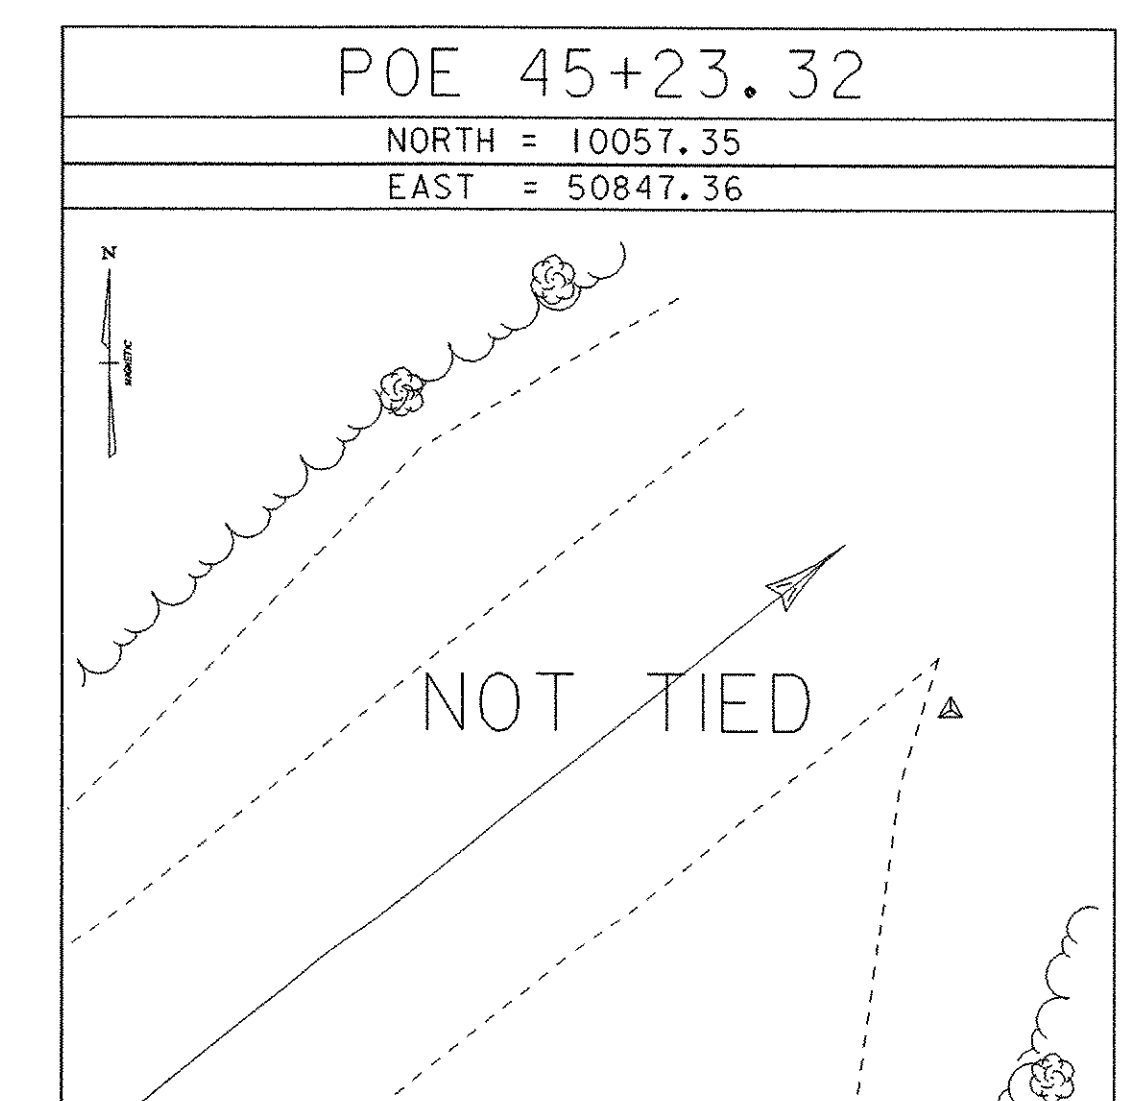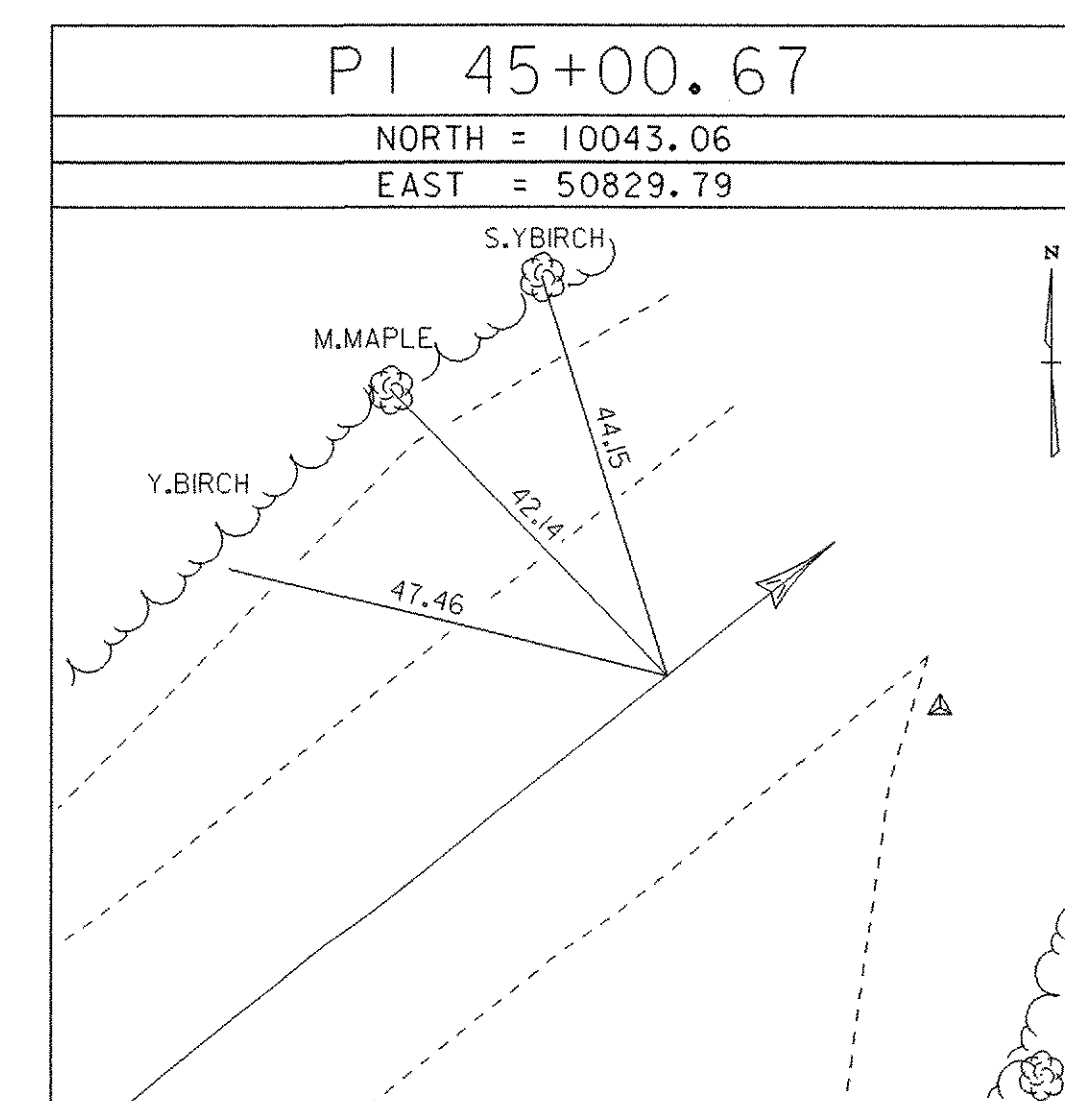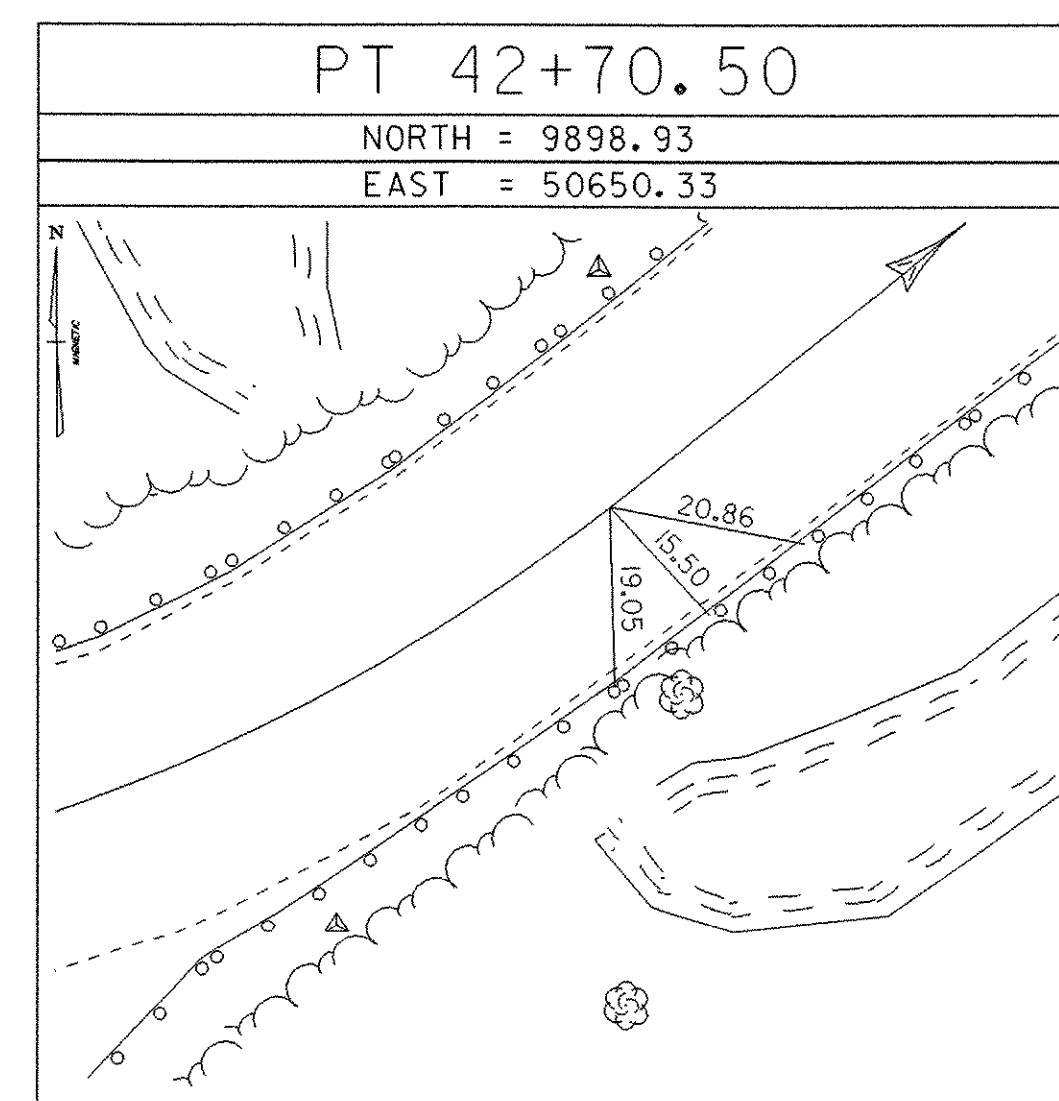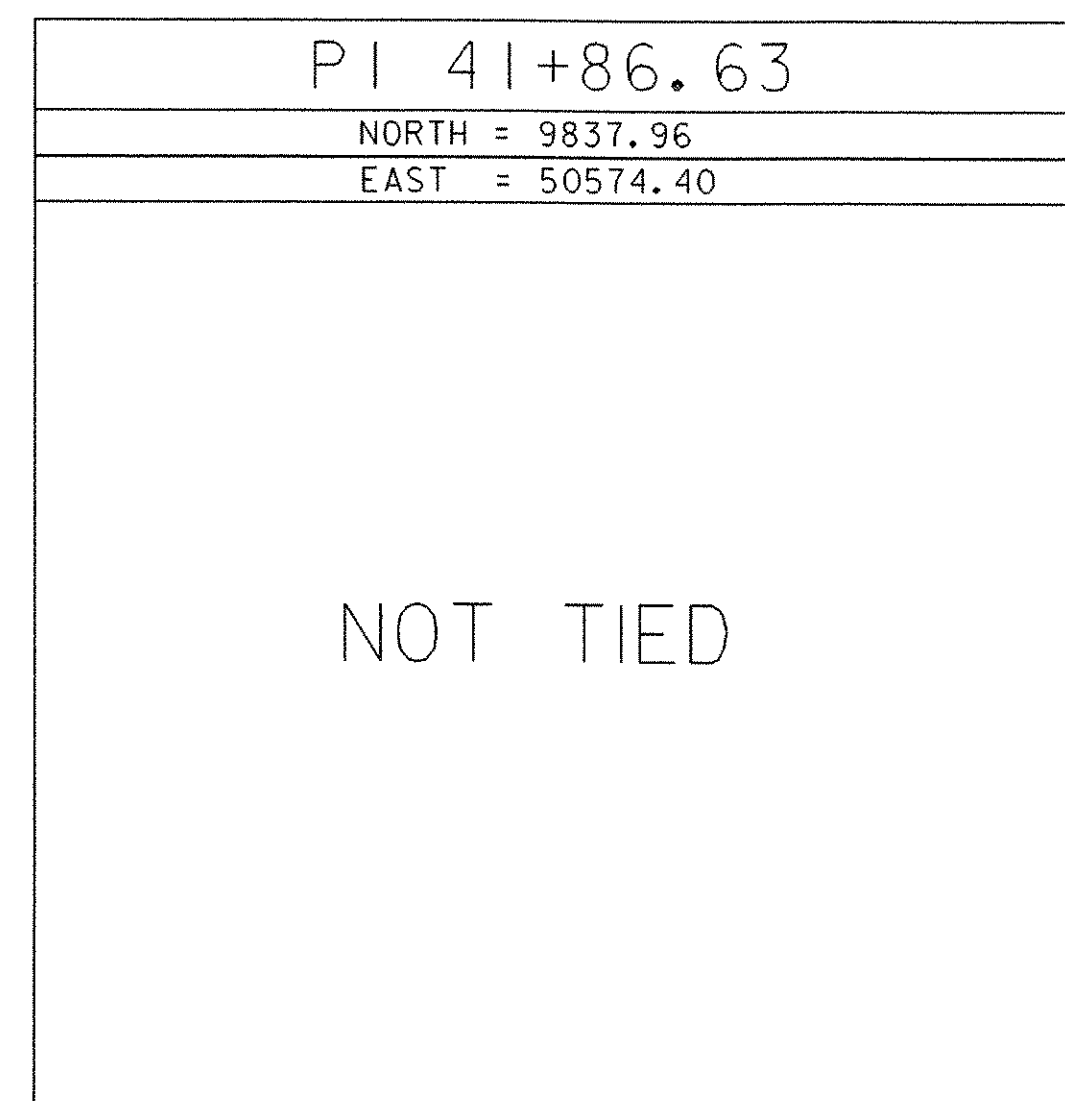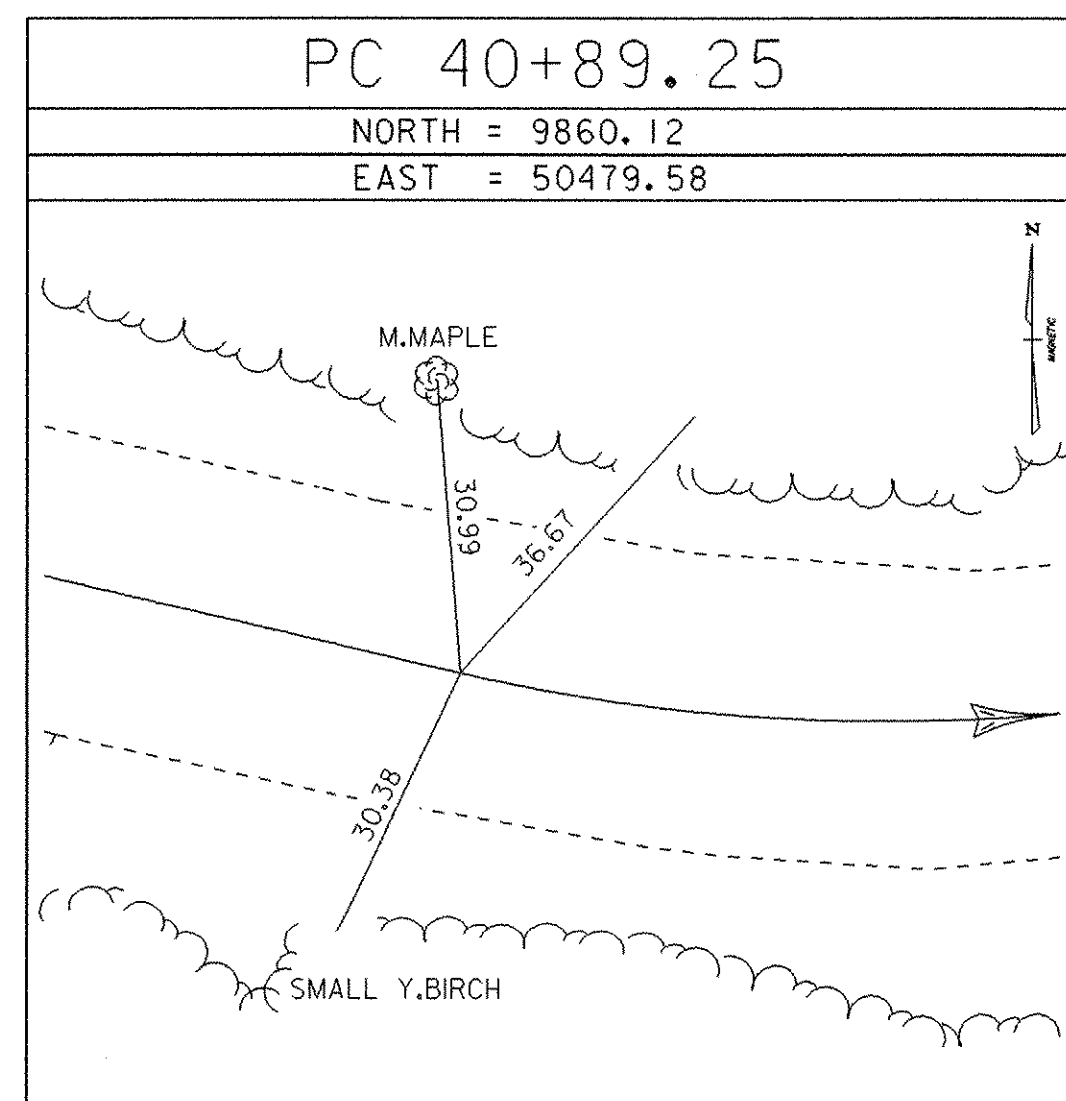

DATUM	
VERTICAL	NAVD 27
HORIZONTAL	ASSUMED
ADJUSTMENT	NONE

COORDINATES ASSUMED

TIE SHEET

PROJECT NAME:	BUELS GORE
PROJECT NUMBER:	STP ST CULV (I)
FILE NAME:	04cl38/survey/x04cl38t1.dgn
PROJECT LEADER:	M.EVANS-MONGEON
DESIGNED BY:	W.FARLEY
IPARM:	s04cl38t1e.i
PLOT DATE:	05-APR-2006
DRAWN BY:	J.H & R.B
CHECKED BY:	M.EVANS-MONGEON
SHEET	7 OF 30