


PRECAST BOX CULVERT CHANGED TO PRECAST ARCH WITH
CAST IN PLACE FOOTINGS FOR ARCH AND WINGWALLS.

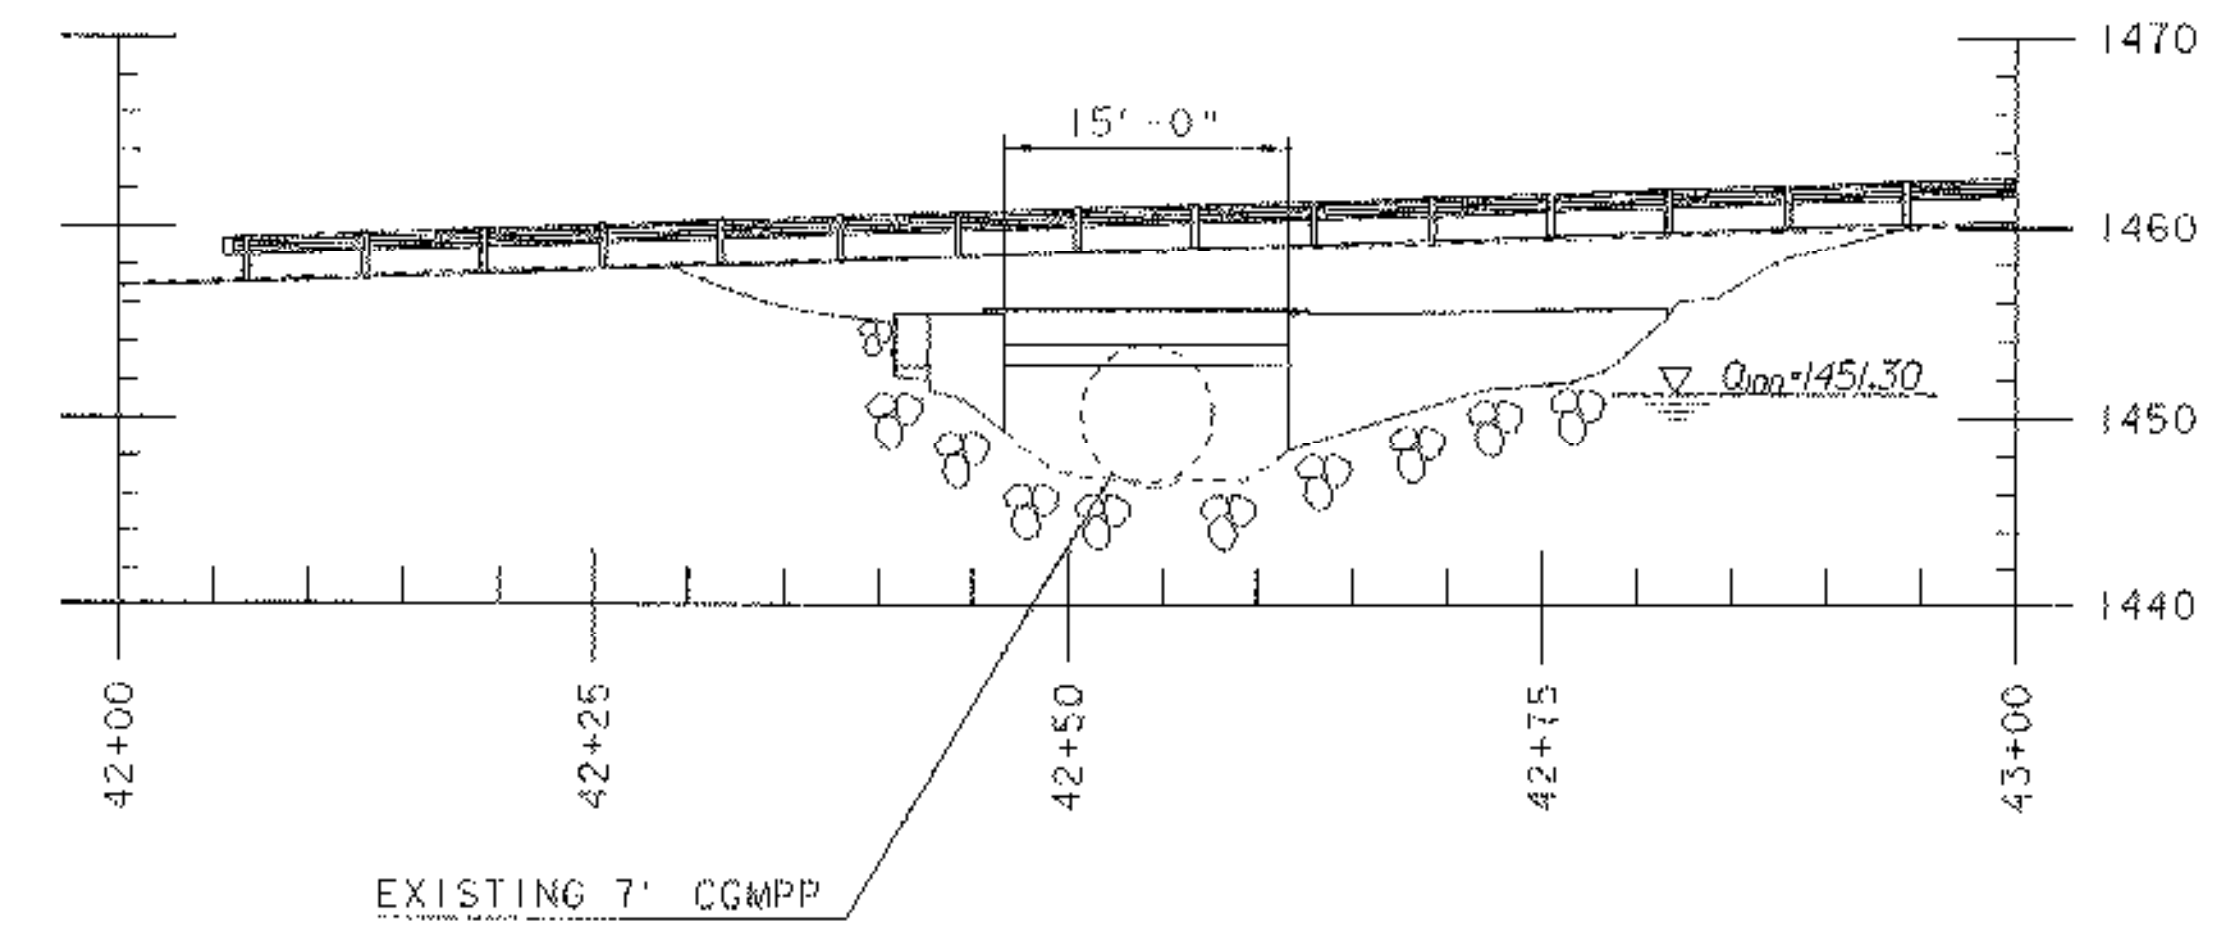

DATUM	
VERTICAL	NAVD 27
HORIZONTAL	ASSUMED

PLAN AND ELEVATION SHEET	
PROJECT NAME:	BUELS GORE
PROJECT NUMBER:	STP ST CULV(I)
FILE NAME: /04c138/structures/s04c138pe.dgn	PLOT DATE: 05-APR-2006
PROJECT LEADER: M. EVANS-MONGEON	DRAWN BY: W. FARLEY
DESIGNED BY: W. FARLEY	CHECKED BY: M. EVANS-MONGEON
IPARM: s04c138pe.l	SHEET 21 OF 30