

# STATE OF VERMONT AGENCY OF TRANSPORTATION



## PROPOSED IMPROVEMENT BRIDGE PROJECT



TOWN OF READSBORO  
COUNTY OF BENNINGTON

ROUTE NO. : VT RTE 8, RURAL MAJOR COLLECTOR      BRIDGE NO. : 02

PROJECT LOCATION : BEGINNING AT A POINT ON VT RTE 8, APPROXIMATELY 1.30 MILES  
NORTHERLY FROM ITS INTERSECTION WITH VT RTE 100 AND PROCEEDING  
NORTHERLY ALONG VT RTE 8 FOR APPROXIMATELY 0.10 MILES.

PROJECT DESCRIPTION : CONSTRUCTION OF A NEW PRECAST CONCRETE BOX CULVERT IN THE EXISTING  
LOCATION WITH RELATED CHANNEL AND APPROACH WORK.

|                      |        |      |
|----------------------|--------|------|
| LENGTH OF STRUCTURE: | N/A    | FEET |
| LENGTH OF ROADWAY:   | 150.00 | FEET |
| LENGTH OF PROJECT:   | 150.00 | FEET |

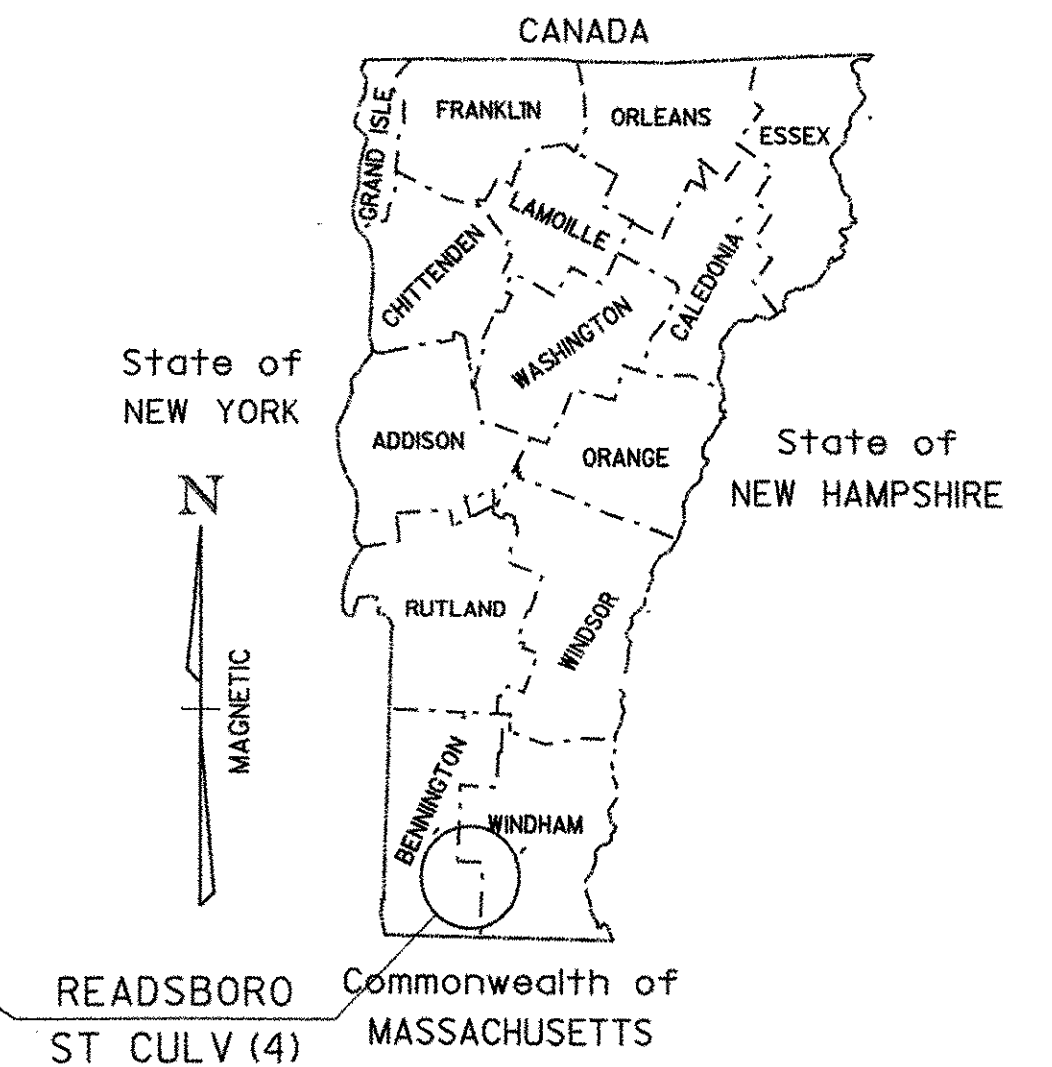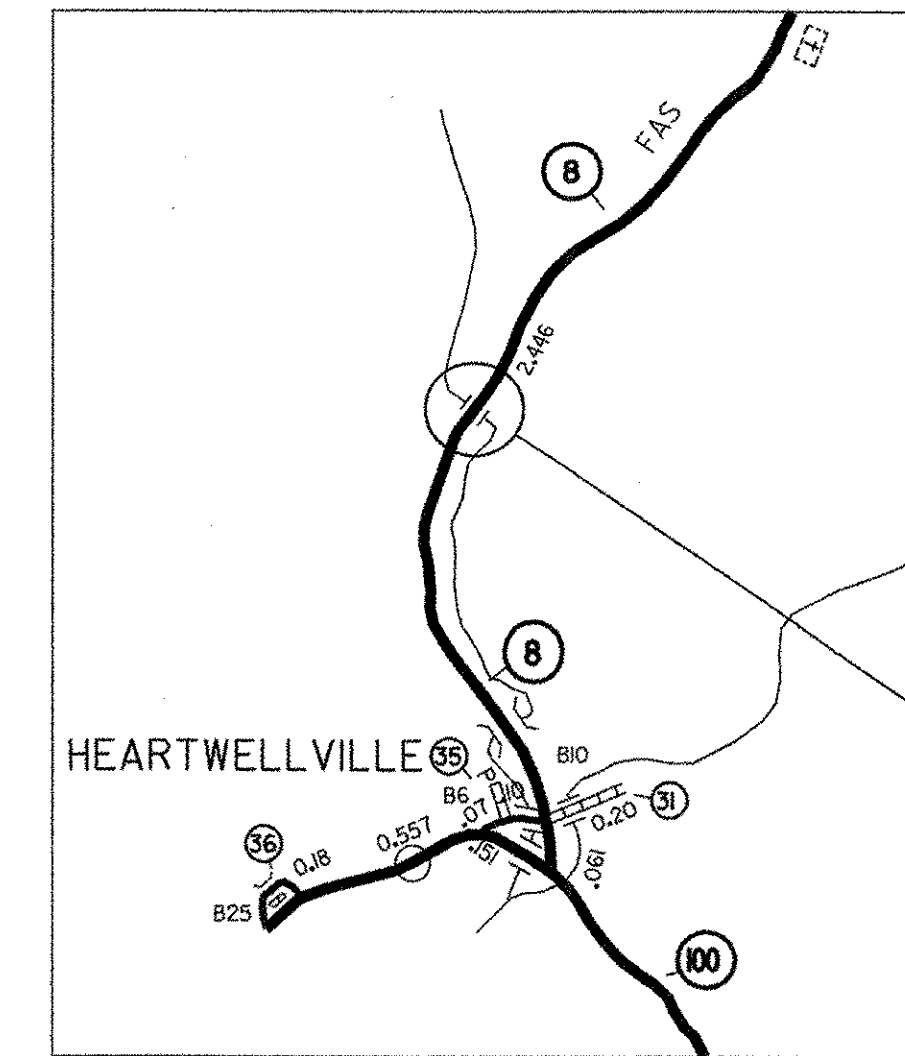

### RECORD PLANS



|                        |                                    |
|------------------------|------------------------------------|
| CONTRACTOR:            | PIKE INDUSTRIES, INC. - BERLIN, VT |
| RESIDENT ENGINEER:     | FRED ROSS                          |
| CONSTRUCTION BEGAN:    | MAY 29, 2007                       |
| CONSTRUCTION COMPLETE: | SEPTEMBER 22, 2007                 |
| RECORD PLANS BY:       | FRED ROSS & MIKE BOOTH             |

I HEREBY CERTIFY THAT ALL THE CONSTRUCTION REQUIRED BY THIS SET OF DRAWINGS HAS BEEN ACCOMPLISHED AS INDICATED HEREIN.

BY Fred Ross RESIDENT ENGINEER  
DATE 3/19/09

NOTE: Any further information concerning final quantities, amounts or other details relative to this project may be found at Central Files in the electronic archives.

| CONVENTIONAL SYMBOLS |  |
|----------------------|--|
| COUNTY LINE          |  |
| TOWN LINE            |  |
| LIMITS OF ACCESS     |  |
| POINT OF ACCESS      |  |
| FENCE LINE           |  |
| STONE WALL           |  |
| TRAVELED WAY         |  |
| GUARD RAIL           |  |
| RAILROAD             |  |
| SURVEY LINE          |  |
| CULVERT              |  |
| POWER POLE           |  |
| TELEPHONE POLE       |  |
| TREES                |  |
| CONTROL OF ACCESS    |  |
| PROPERTY LINE        |  |
| R.O.W. TAKING LINE   |  |
| SLOPE RIGHTS         |  |
| TOP OF CUT           |  |
| TOE OF SLOPE         |  |

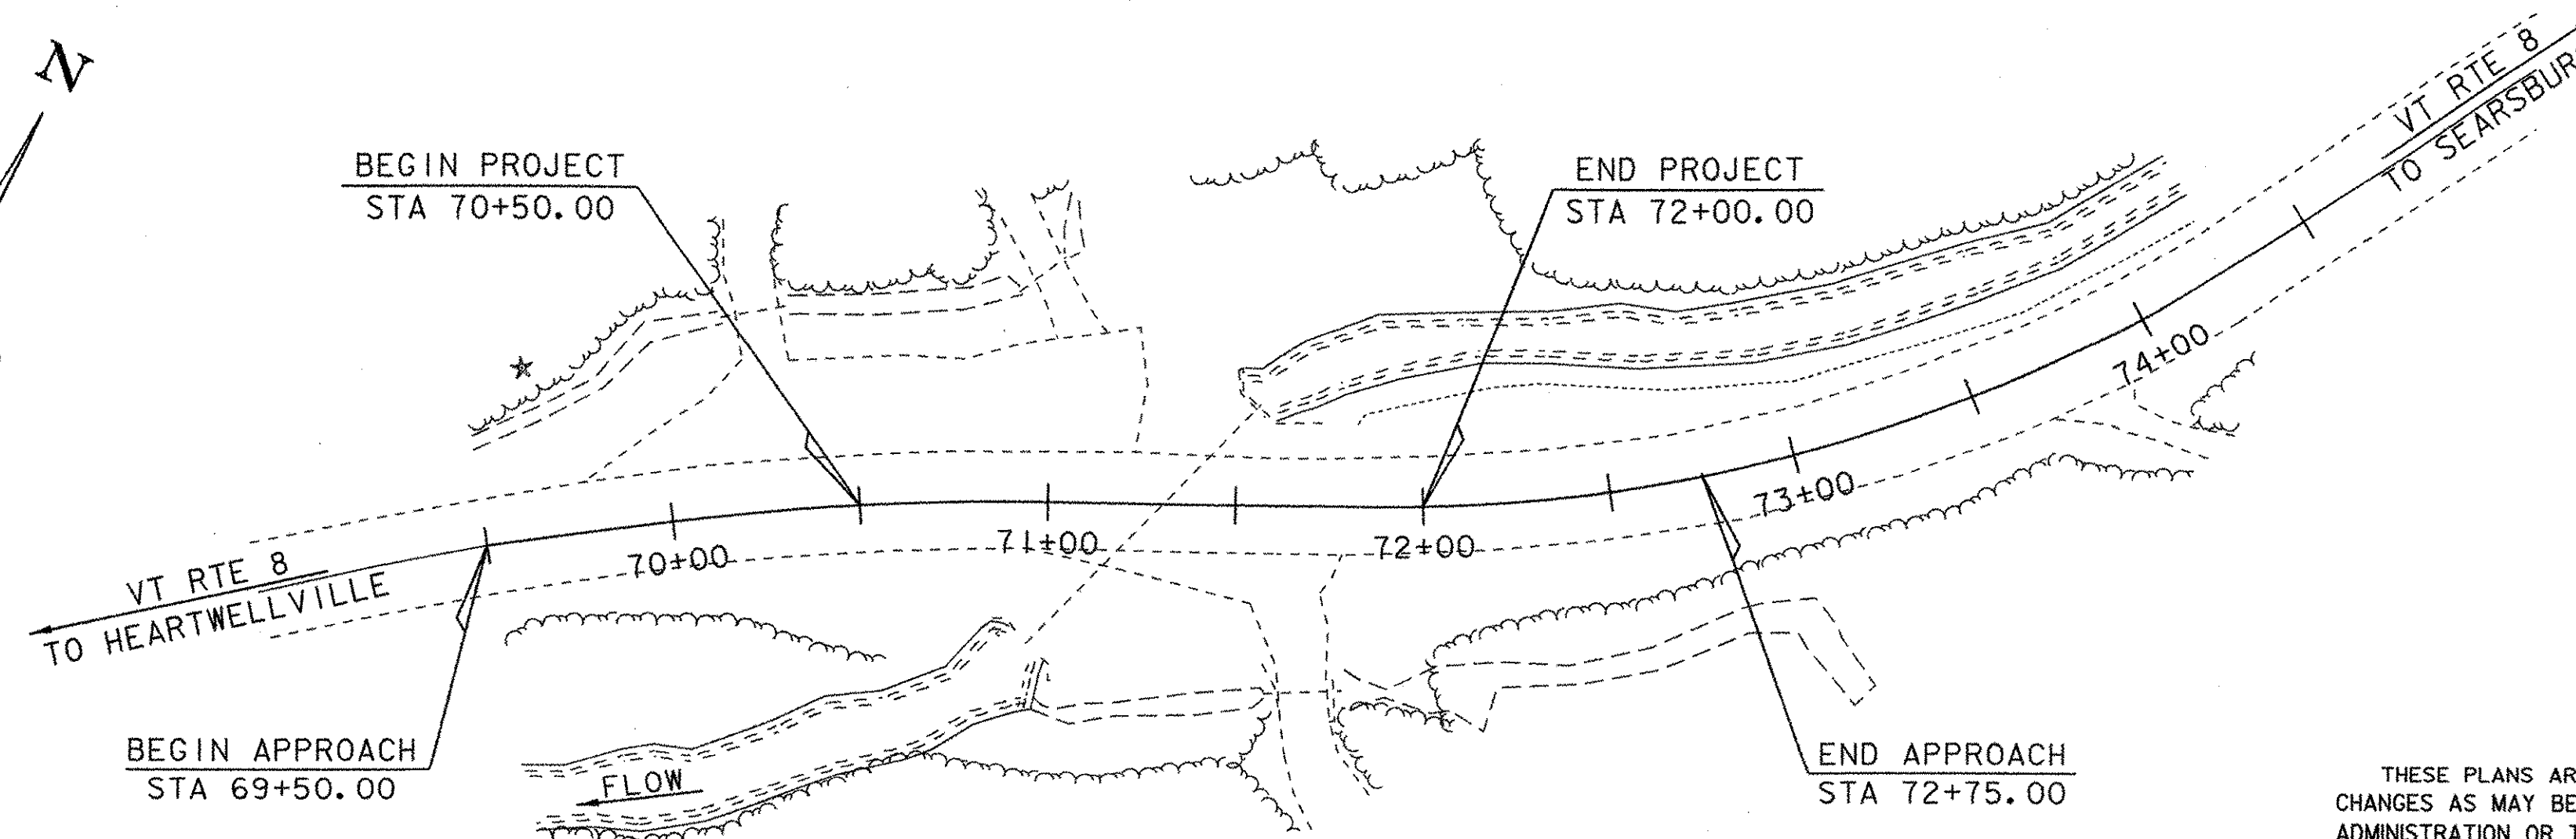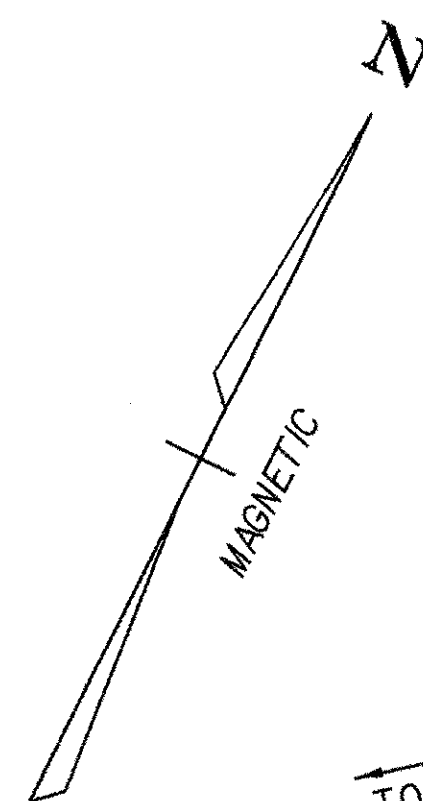

SURVEYED BY : L. ORVIS  
SURVEYED DATE : 11/2004

DATUM  
VERTICAL NAVD 88  
HORIZONTAL ASSUMED

SCALE 1" = 40'-0"  
40 0 40

THESE PLANS ARE SUBJECT TO SUCH ENGINEERING CHANGES AS MAY BE REQUIRED BY THE FEDERAL HIGHWAY ADMINISTRATION OR THE DIRECTOR OF PROGRAM DEVELOPMENT.

CONSTRUCTION IS TO BE CARRIED ON IN ACCORDANCE WITH THESE PLANS AND THE STANDARD SPECIFICATIONS FOR CONSTRUCTION DATED 2001, AS APPROVED BY THE FEDERAL HIGHWAY ADMINISTRATION ON JANUARY 4, 2001 FOR USE ON THIS PROJECT, INCLUDING ALL SUBSEQUENT REVISIONS AND SUCH REVISED SPECIFICATIONS AND SPECIAL PROVISIONS AS ARE INCORPORATED IN THESE PLANS.

|                                     |                     |
|-------------------------------------|---------------------|
| DIRECTOR OF PROGRAM DEVELOPMENT     |                     |
| APPROVED <u>Richard Fitzmaurice</u> | DATE <u>3/23/09</u> |
| PROJECT MANAGER : C.P. WILLIAMS     |                     |
| PROJECT NAME : READSBORO            |                     |
| PROJECT NUMBER : AC 50 ST CULV (4)  |                     |
| SHEET 1 OF 39 SHEETS                |                     |