




69+75

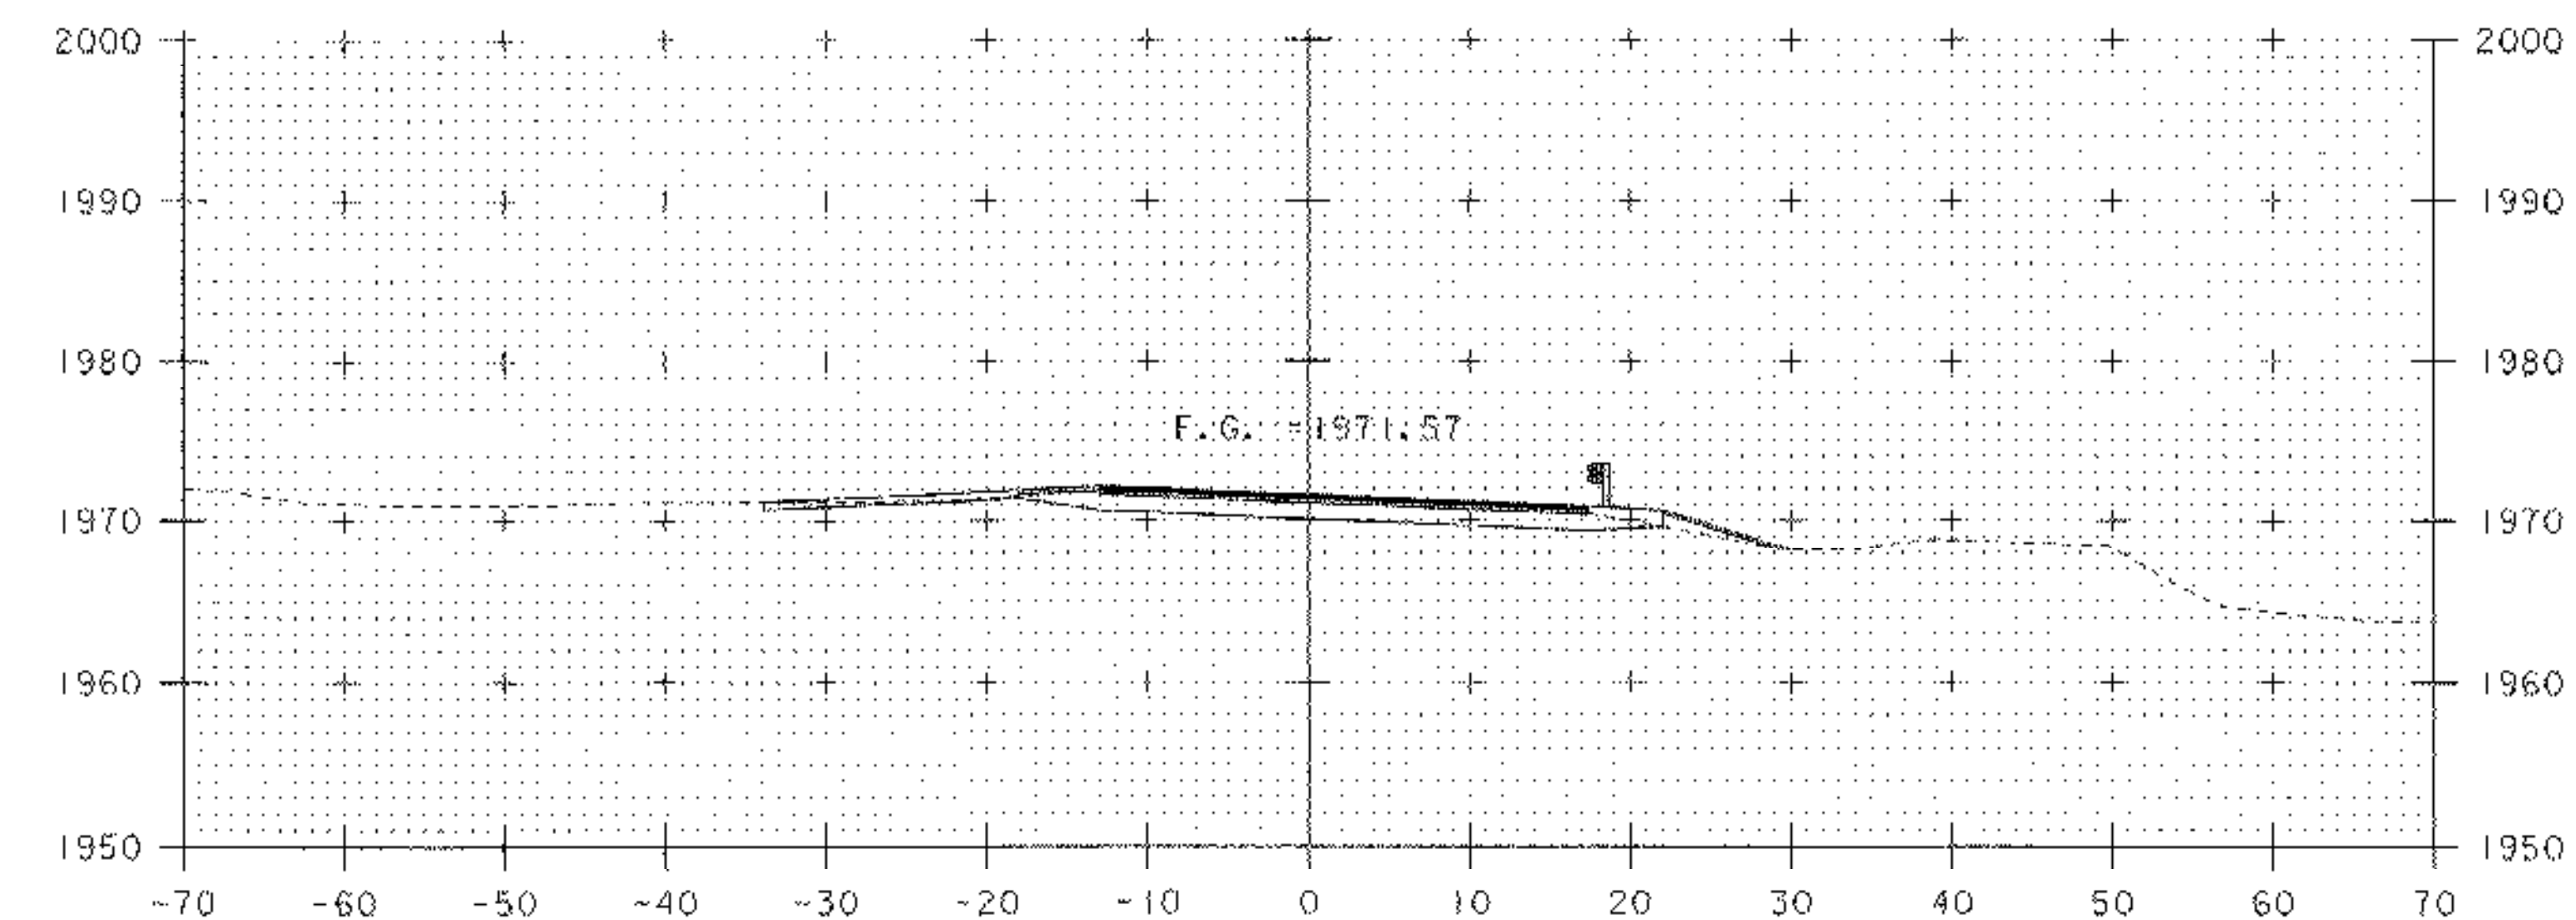

70+25

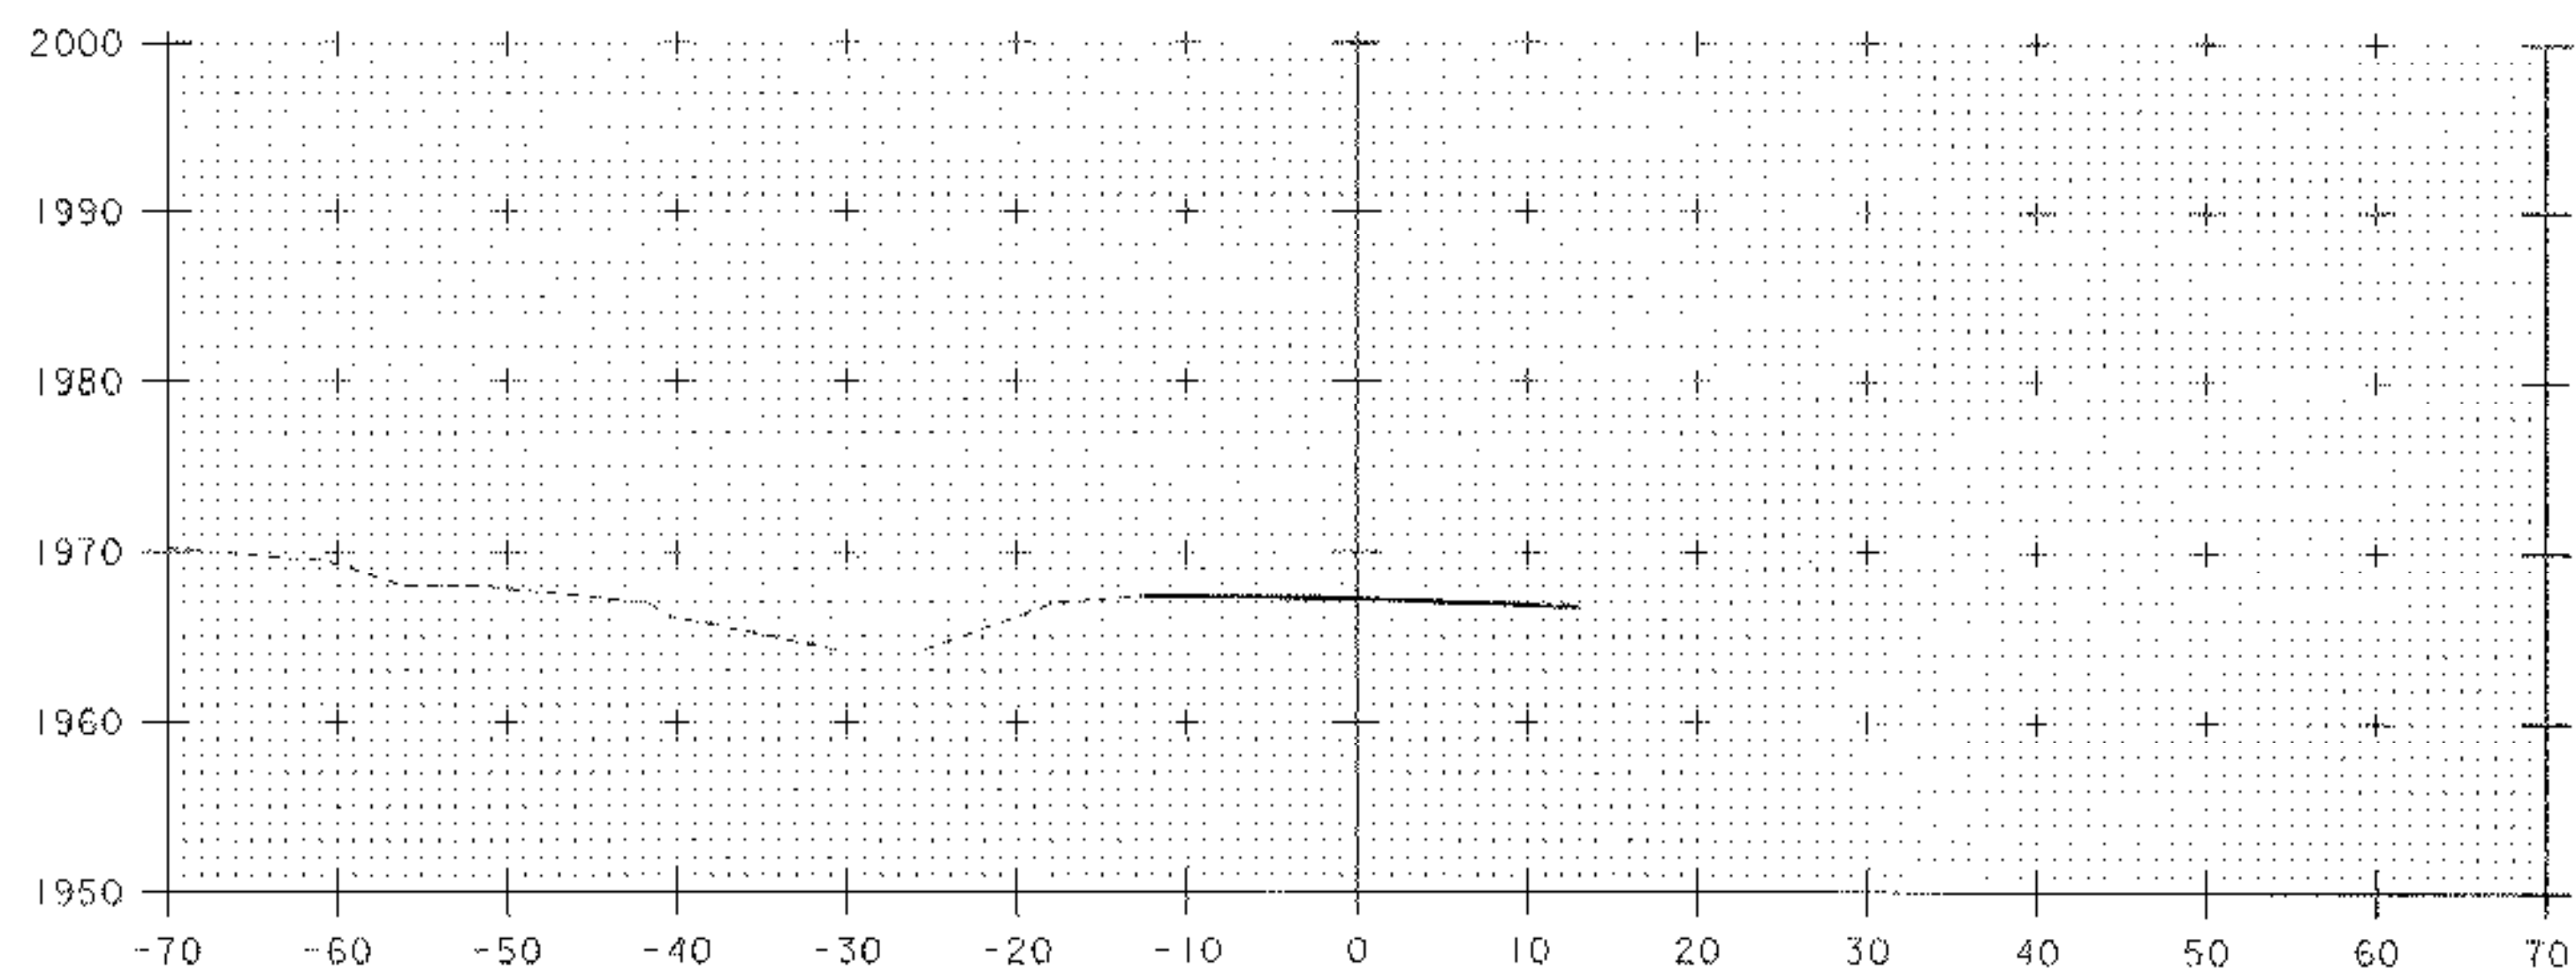

69+50
BEGIN APPROACH

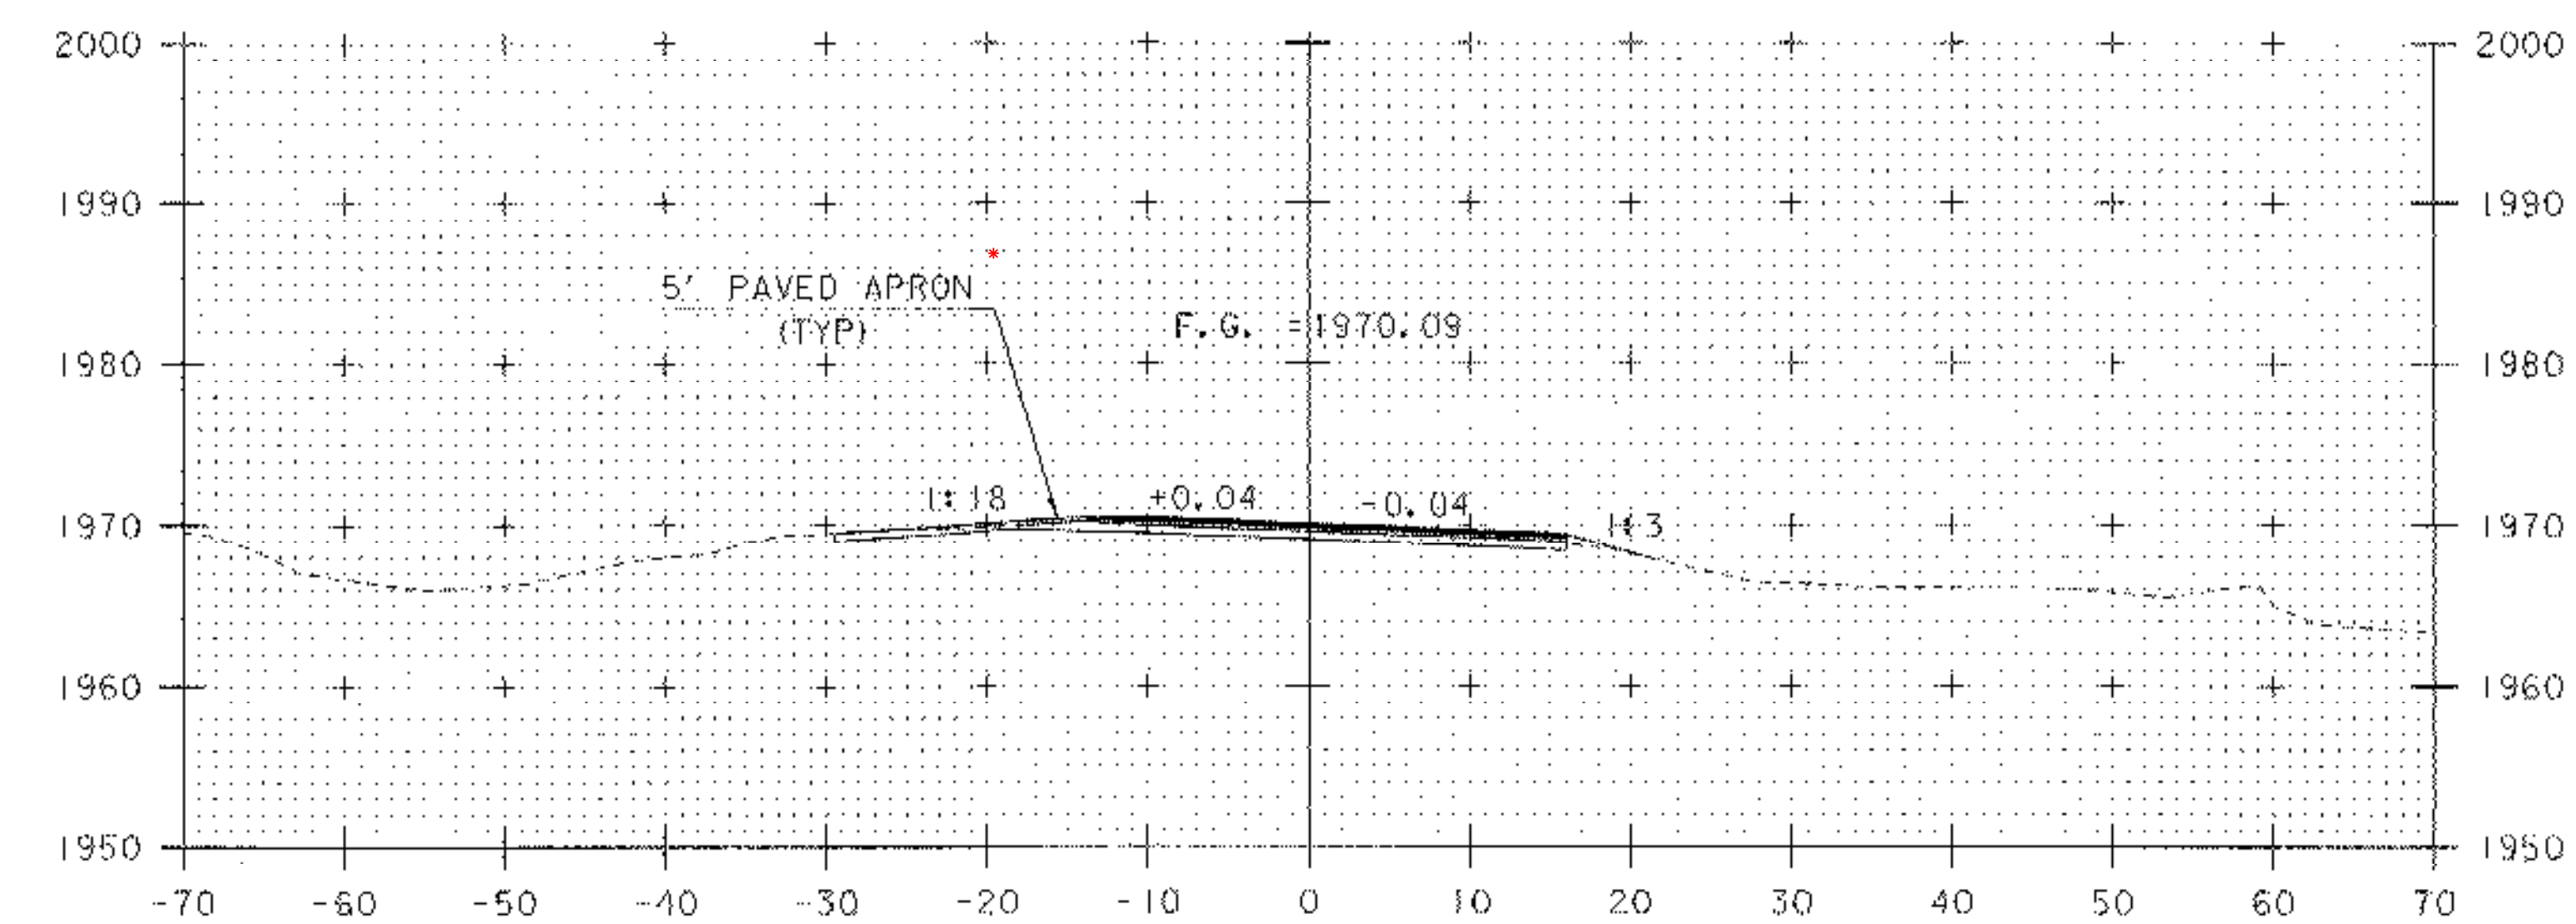

70+00

SCALE 1" = 10'-0"
10 0 10

PROJECT: READSBORO	PROJECT NO.: ST CULV (4)
DESIGN FILE NAME: s04c176/structures/s04c176xs.dgn	PLOT DATE: 18-JUL-2006
IPARM FILE NAME: s04c176m11.i	DRAWN BY: M. FESSEL
DESIGNED BY: E. L. RUSTAY	CHECKED BY: M. GAGULIC
SQUAD LEADER: C. P. WILLIAMS	SHEET: 23 OF 39
ML STA. 69+50 TO STA. 70+25	