



10+25

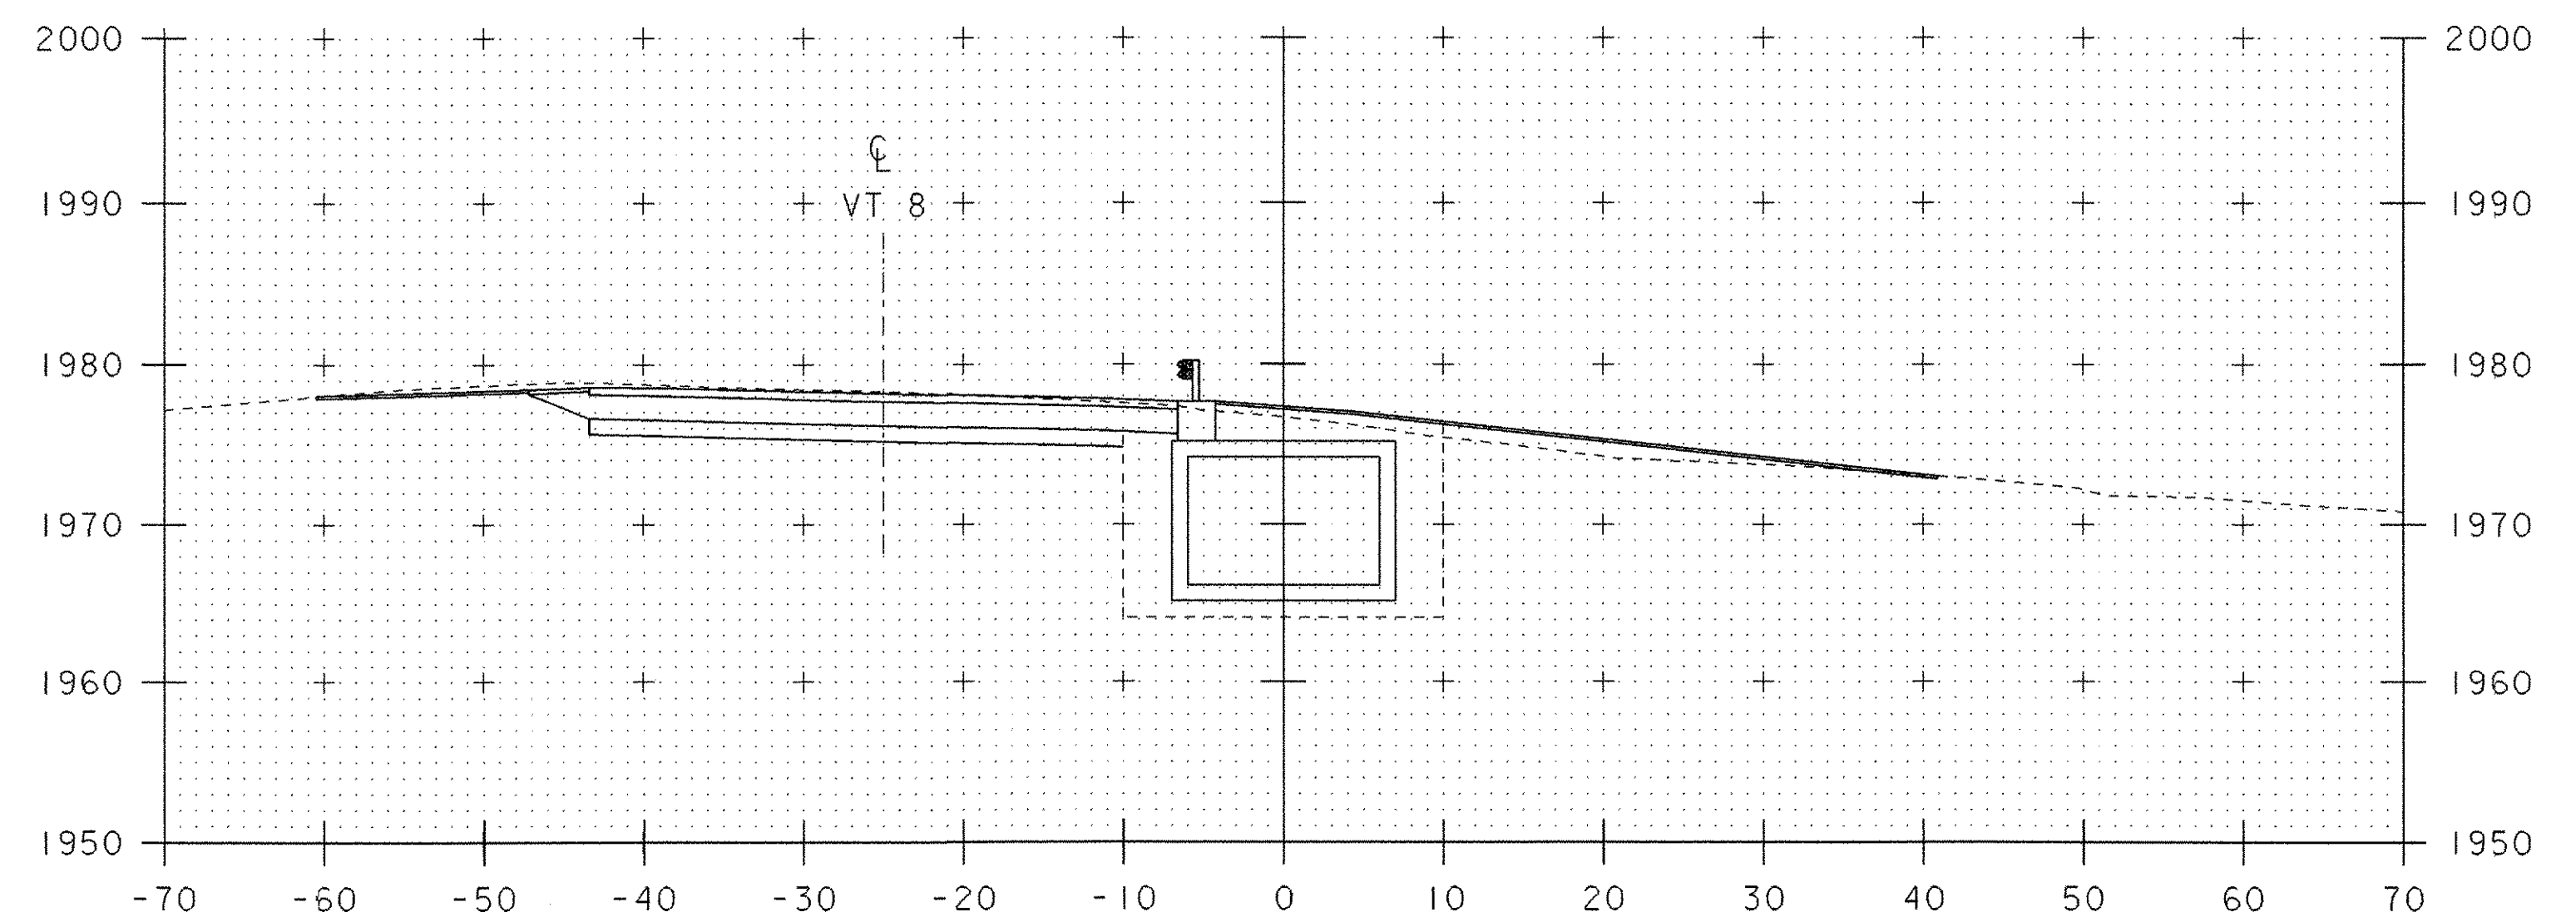


10+75

STA 10+63.00 RT & LT
 END STONE FILL TYPE II FOR CHANNEL STABILIZATION
 END GEOTEXTILE UNDER STONE FILL
 END GRUBBING MATERIAL

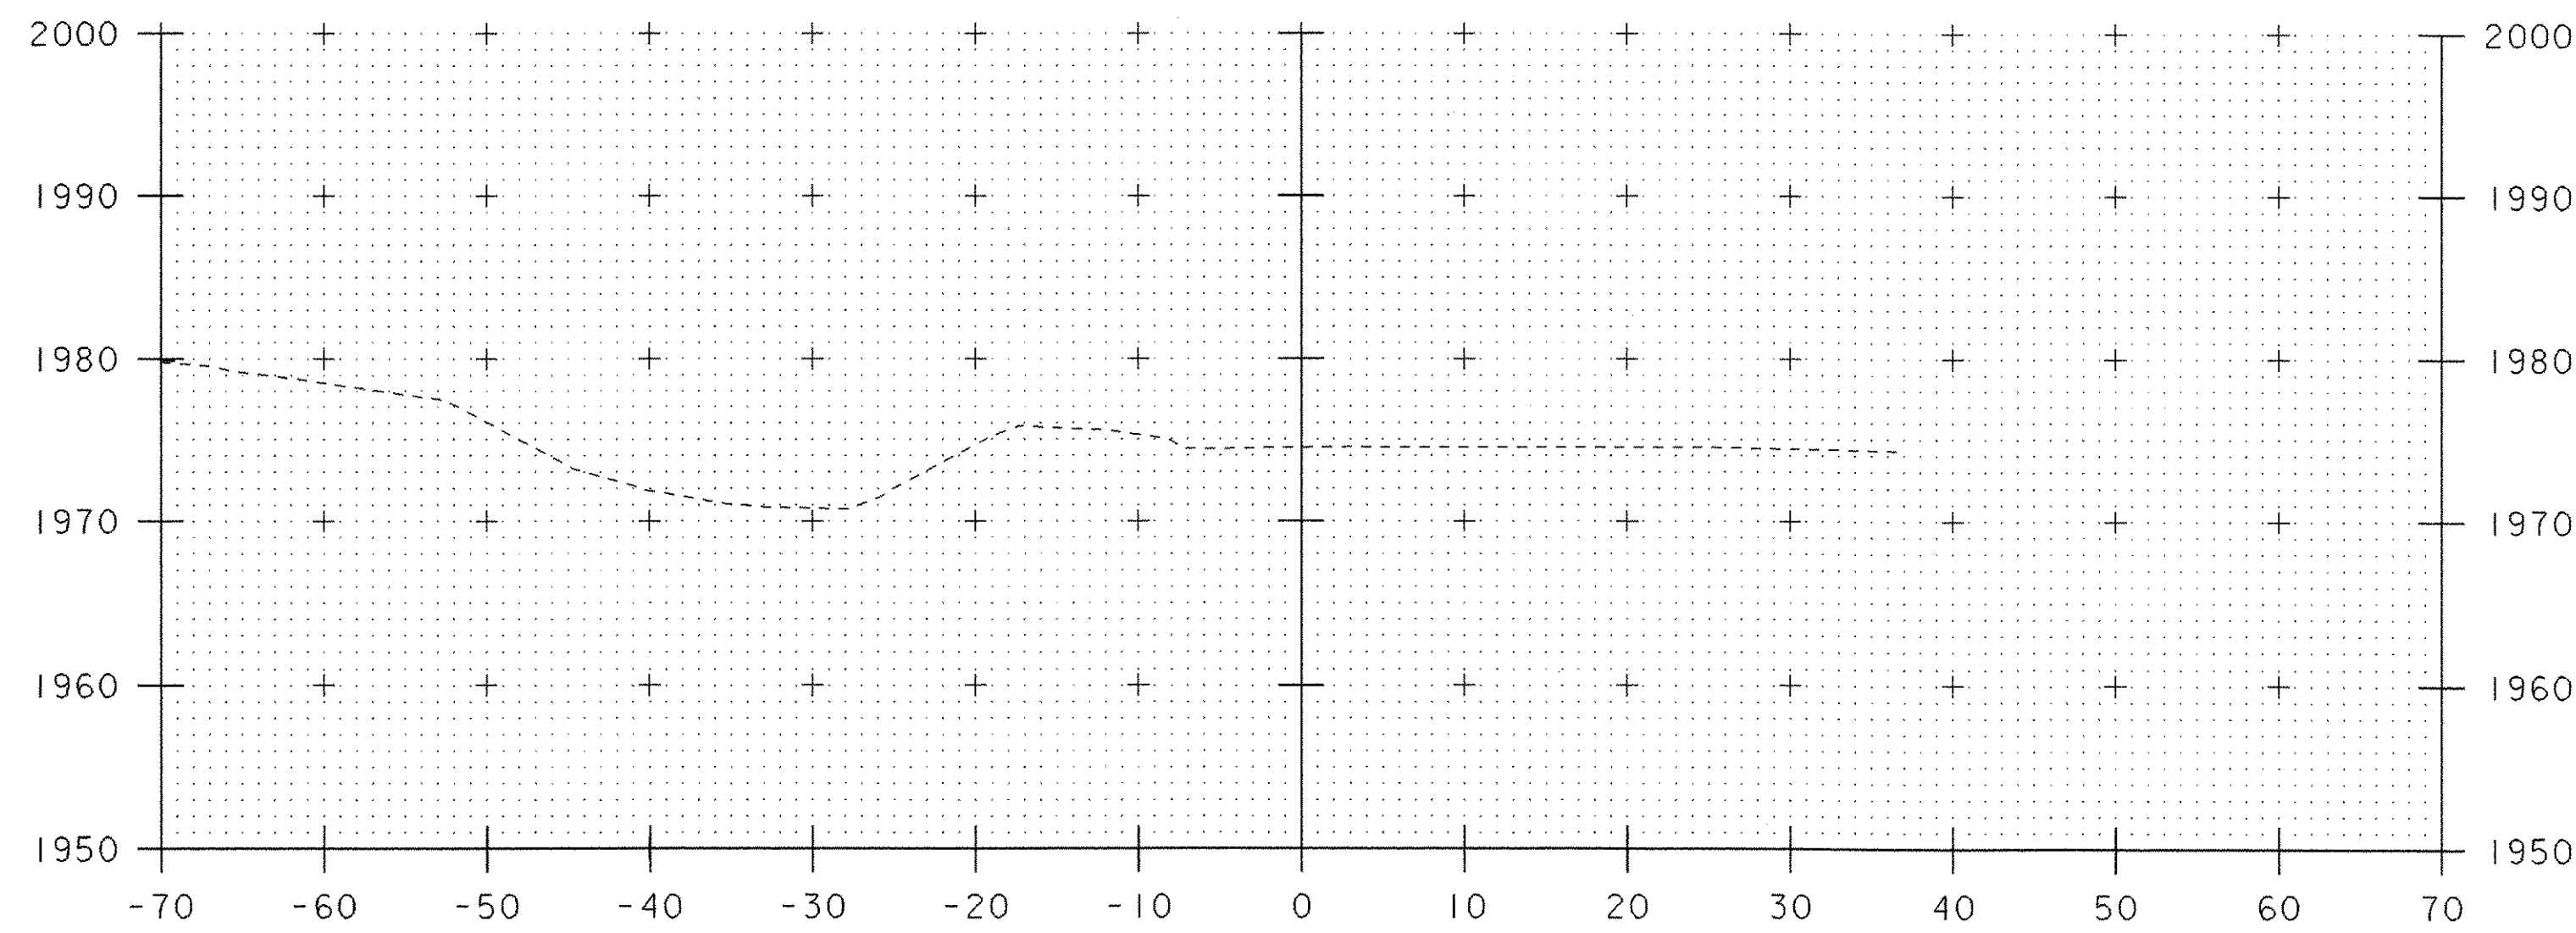

10+00

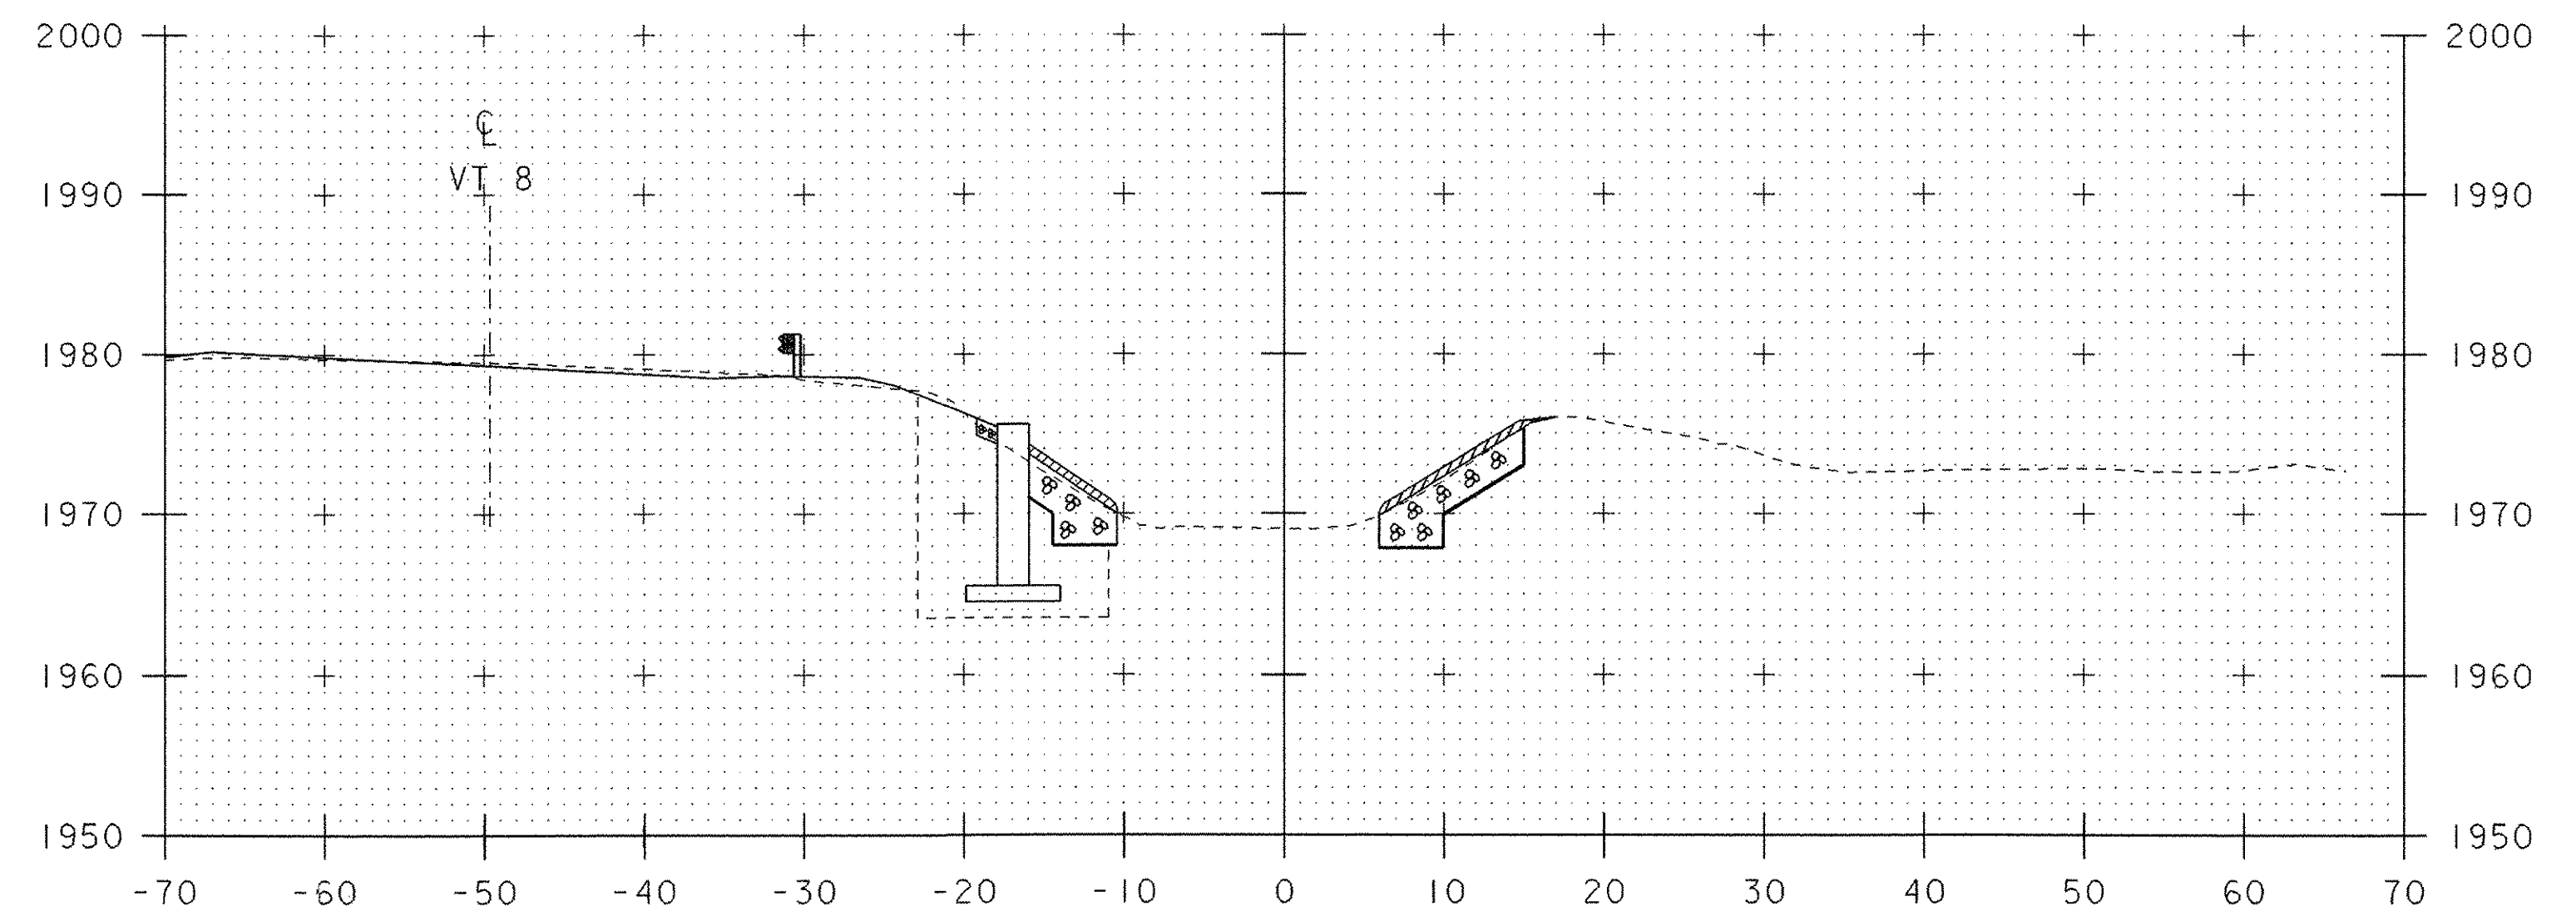

10+50

STA 10+32.00 LT
 BEGIN STONE FILL TYPE II
 BEGIN GEOTEXTILE UNDER STONE FILL
 BEGIN GRUBBING MATERIAL
 BEGIN UNCLASSIFIED CHANNEL EXCAVATION

STA 10+50.00 RT
 BEGIN STONE FILL TYPE II
 BEGIN GEOTEXTILE UNDER STONE FILL
 BEGIN GRUBBING MATERIAL
 BEGIN UNCLASSIFIED CHANNEL EXCAVATION

PROJECT: READSBORO	PROJECT NO.: ST CULV (4)
DESIGN FILE NAME: 04c176/structures/s04c176xs.dgn	PLOT DATE: 18-JUL-2006
IPARM FILE NAME: s04c176chl.i	DESIGNED BY: E.L.RUSTAY
SQUAD LEADER: C.P.WILLIAMS	CHECKED BY: M.GAGULIC
CHANNEL STA. 10+00 TO STA. 10+75	SHEET: 27 OF 39

