



12+25

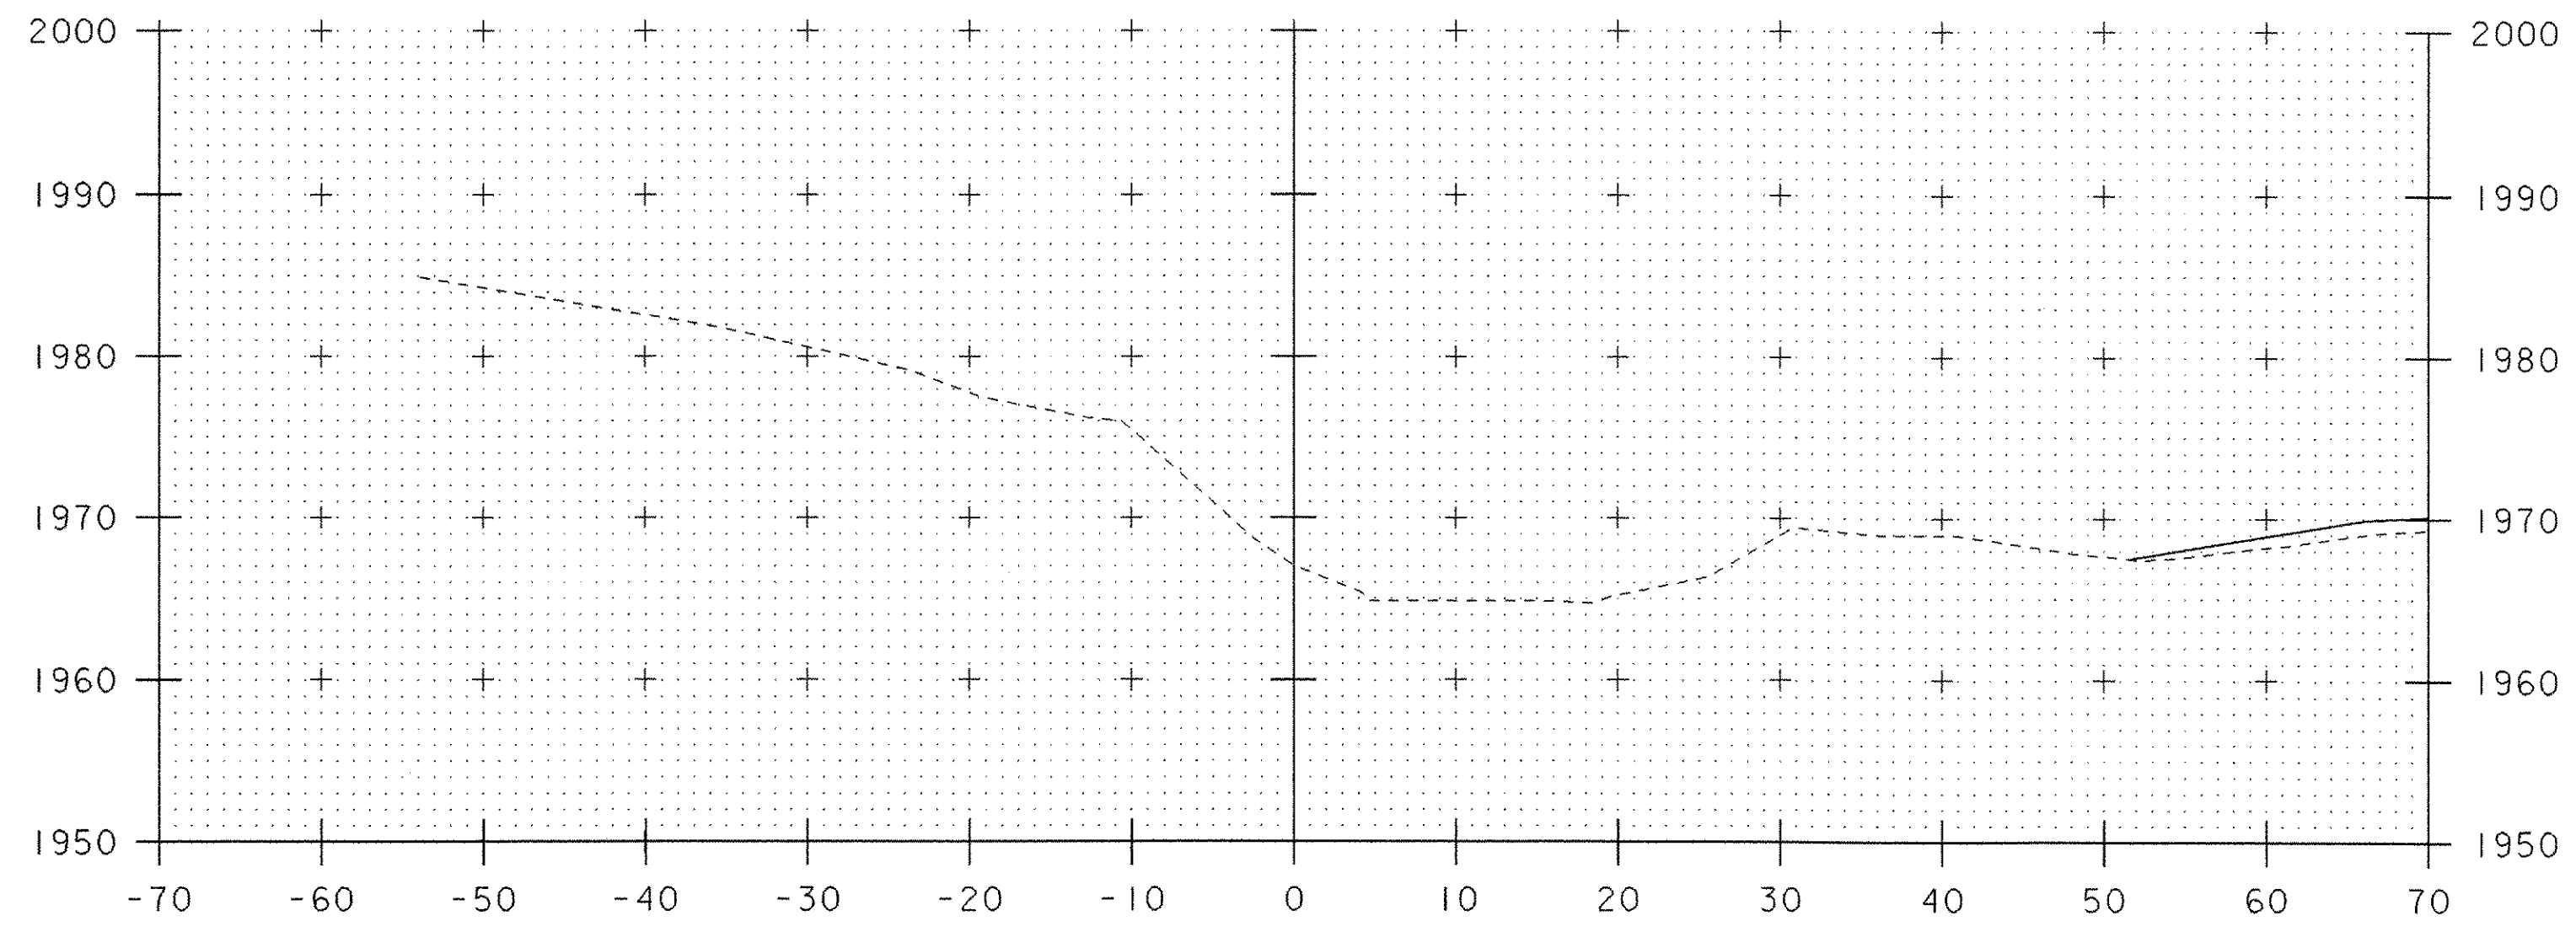

12+00

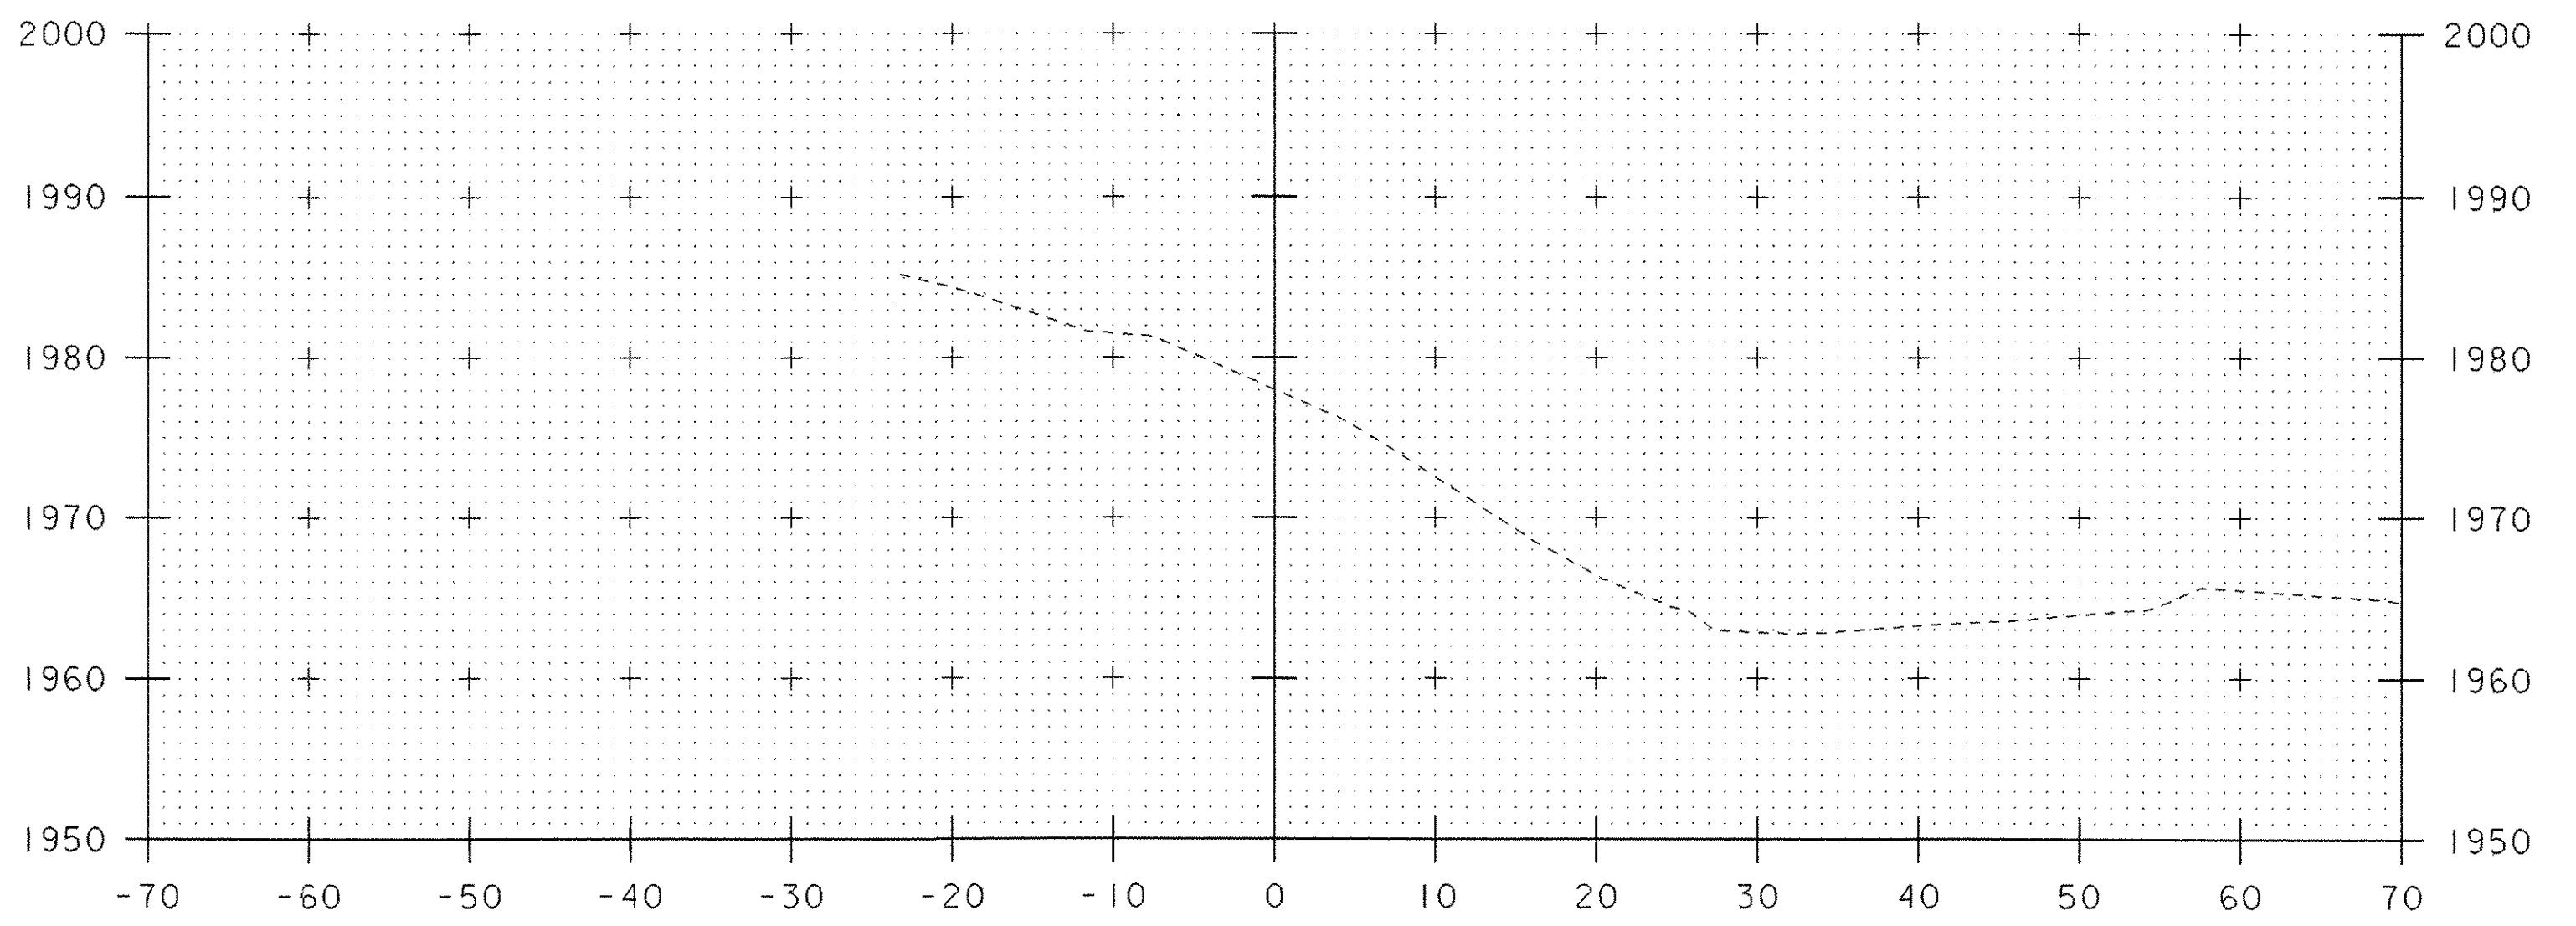

12+50

SCALE 1" = 10'-0"
 10 0 10

PROJECT: READSBORO	PROJECT NO.: ST CULV (4)
DESIGN FILE NAME: 04c176/structures/s04c176xs.dgn	PLOT DATE: 18-JUL-2006
IPARM FILE NAME: s04c176ch3.i	DESIGNED BY: E.L.RUSTAY
SQUAD LEADER: C.P.WILLIAMS	DRAWN BY: E.L.RUSTAY
CHANNEL STA. 12+00 TO STA. 12+50	CHECKED BY: M.GAGULIC
	SHEET: 29 OF 39