


ALL LANDS SURROUNDING THE PROJECT SITE
 BELONG TO THE UNITED STATES OF AMERICA
 DEPARTMENT OF AGRICULTURE FOREST SERVICE

DATUM	
VERTICAL	NAVD 88
HORIZONTAL	ASSUMED

EXISTING CONDITIONS SITE PLAN

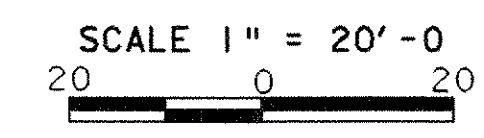

PROJECT: READSBORO	PROJECT NO.: ST CULV (4)
DESIGN FILE NAME: s04c176/structures/s04c176bdr_ero.dgn	PLOT DATE: 18-JUL-2006
IPARM FILE NAME: s04c176excon.i	SURVEY DATE: 11/2004
SURVEYED BY: L.G. ORVIS	DRAWN BY: M.FESSEL
SQUAD LEADER: C.P. WILLIAMS	SHEET: 31 OF 39
EXISTING CONDITIONS	